


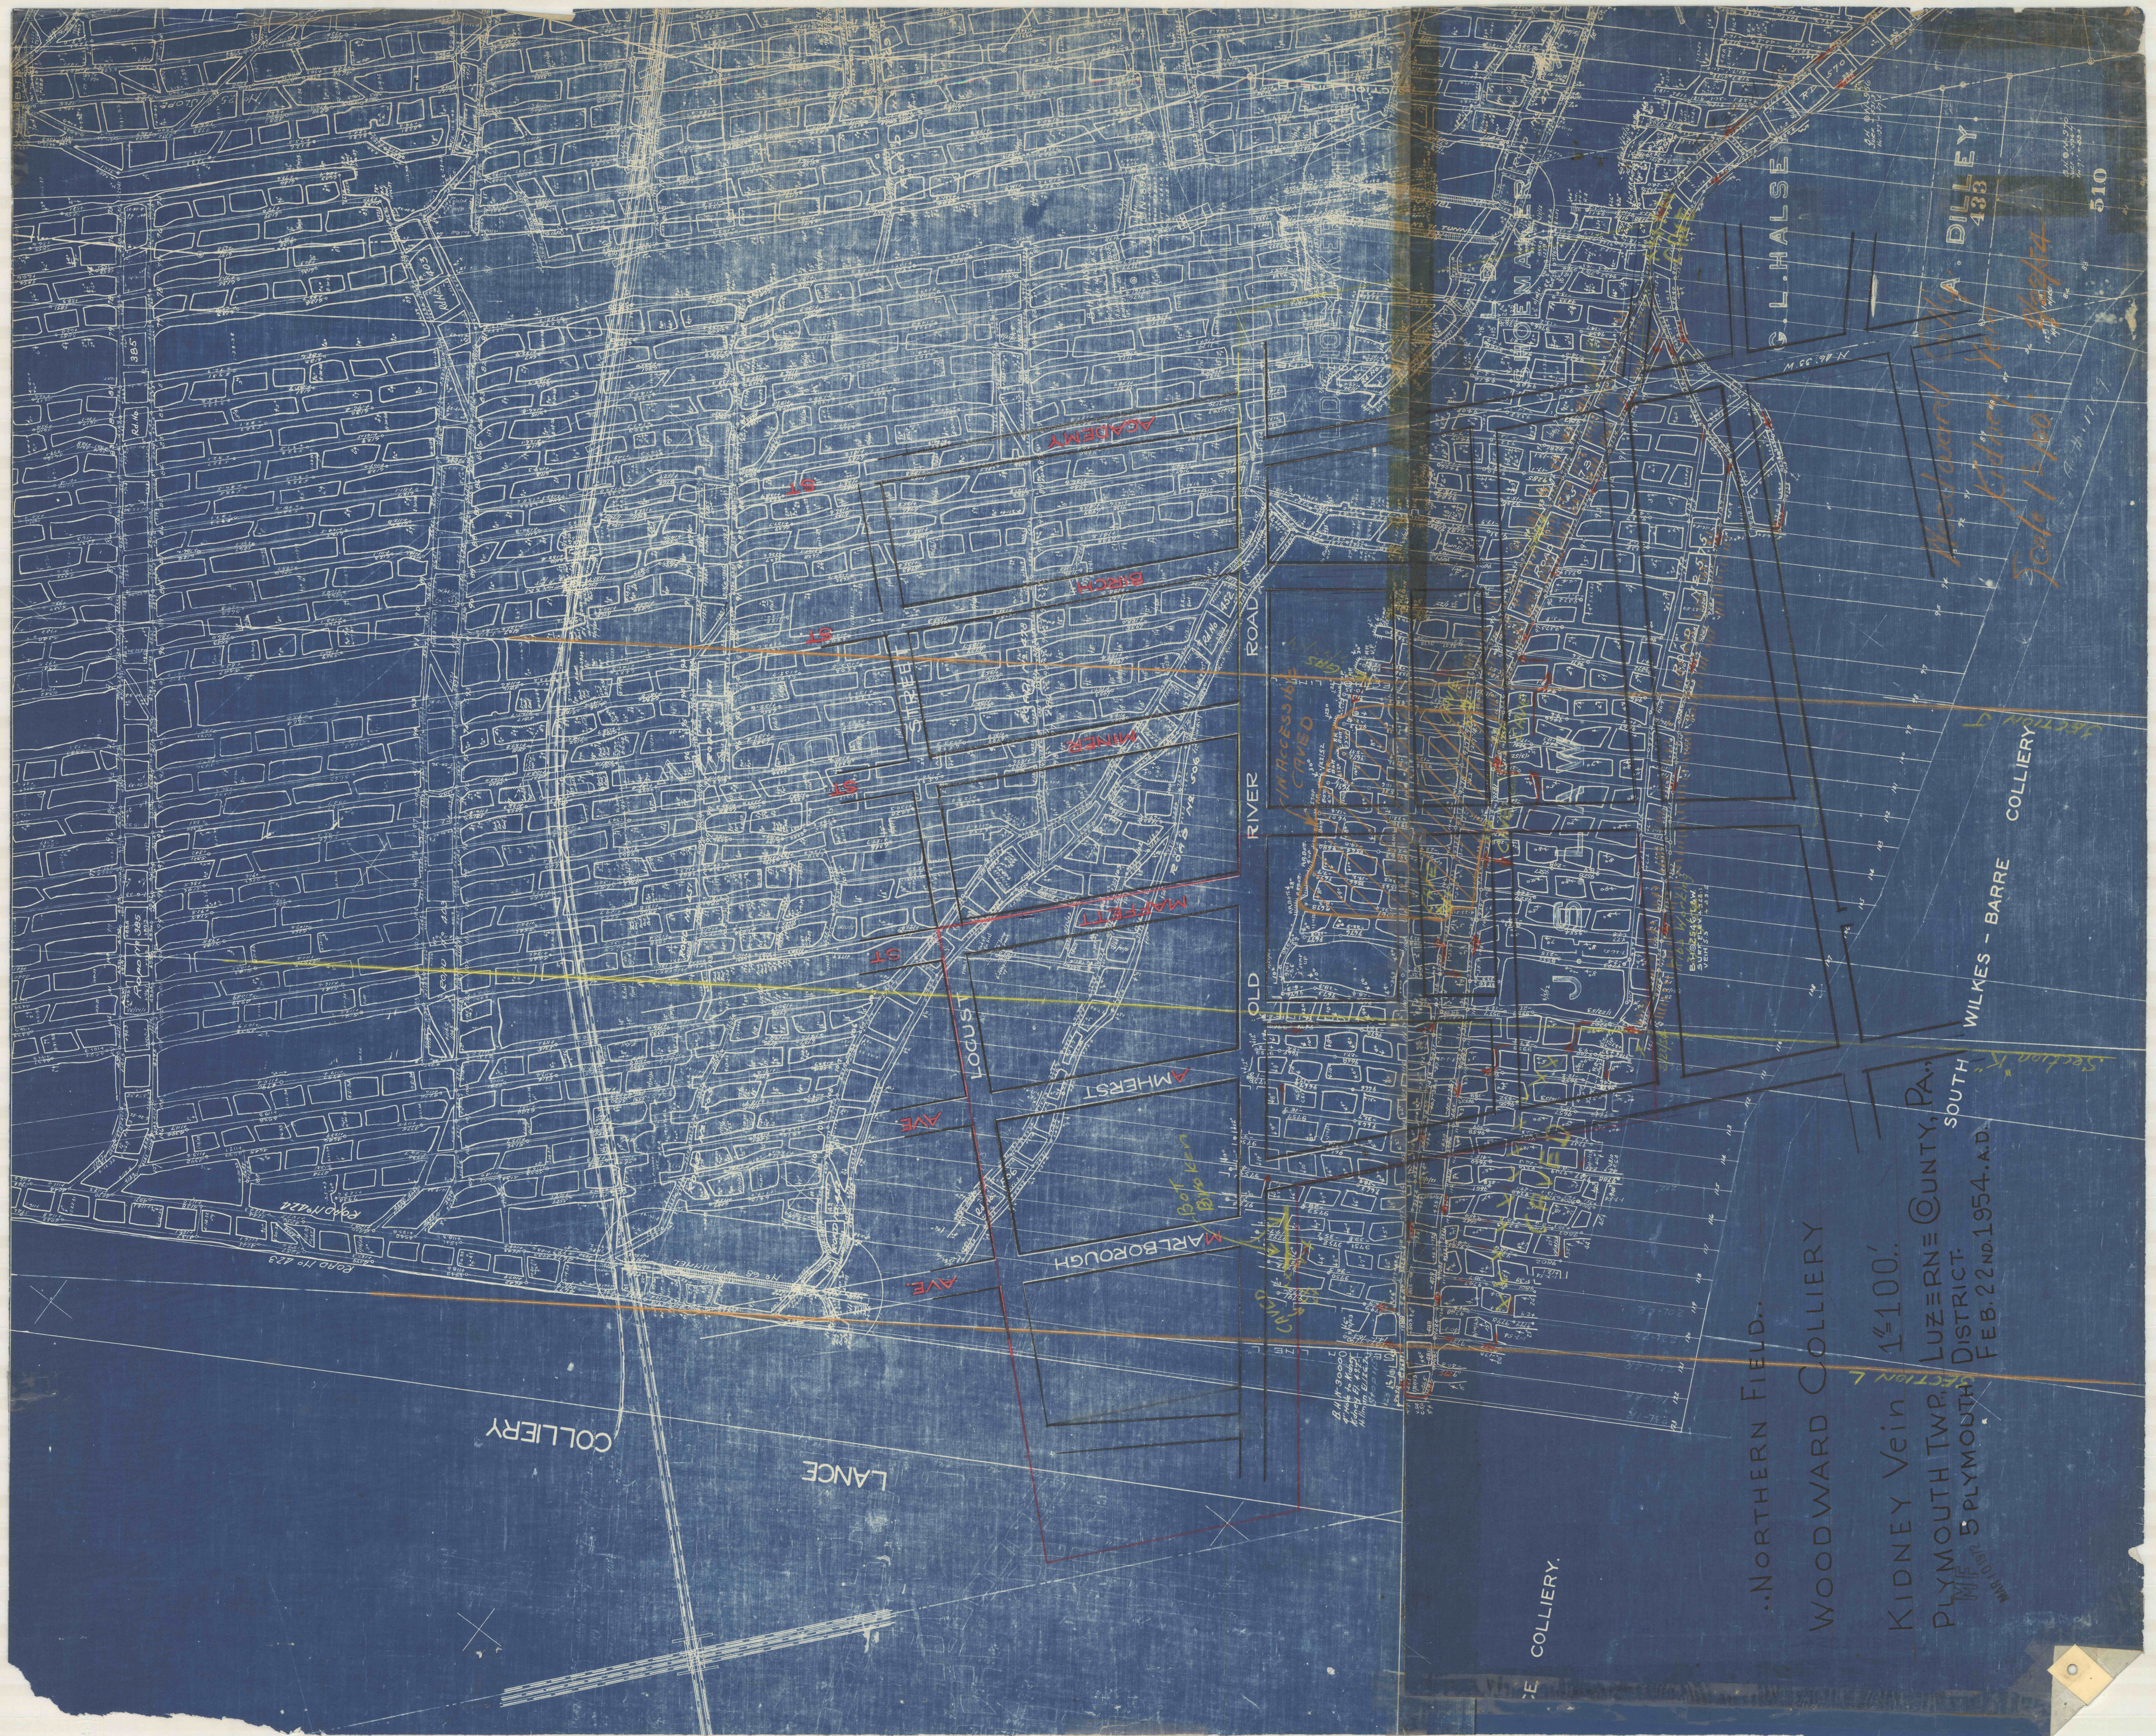

WOODWARD COLLIERY

KIDNEY VEIN 1"=100'

PLYMOUTH TWP., LUZERNE COUNTY, PA.
DISTRICT SOUTH
FEB. 22 NO. 1954 A.D.

WOODWARD COLLIERY
KIDNEY VEIN
FEB. 22 NO. 1954 A.D.

WILKES - BARRE COLLIERY