


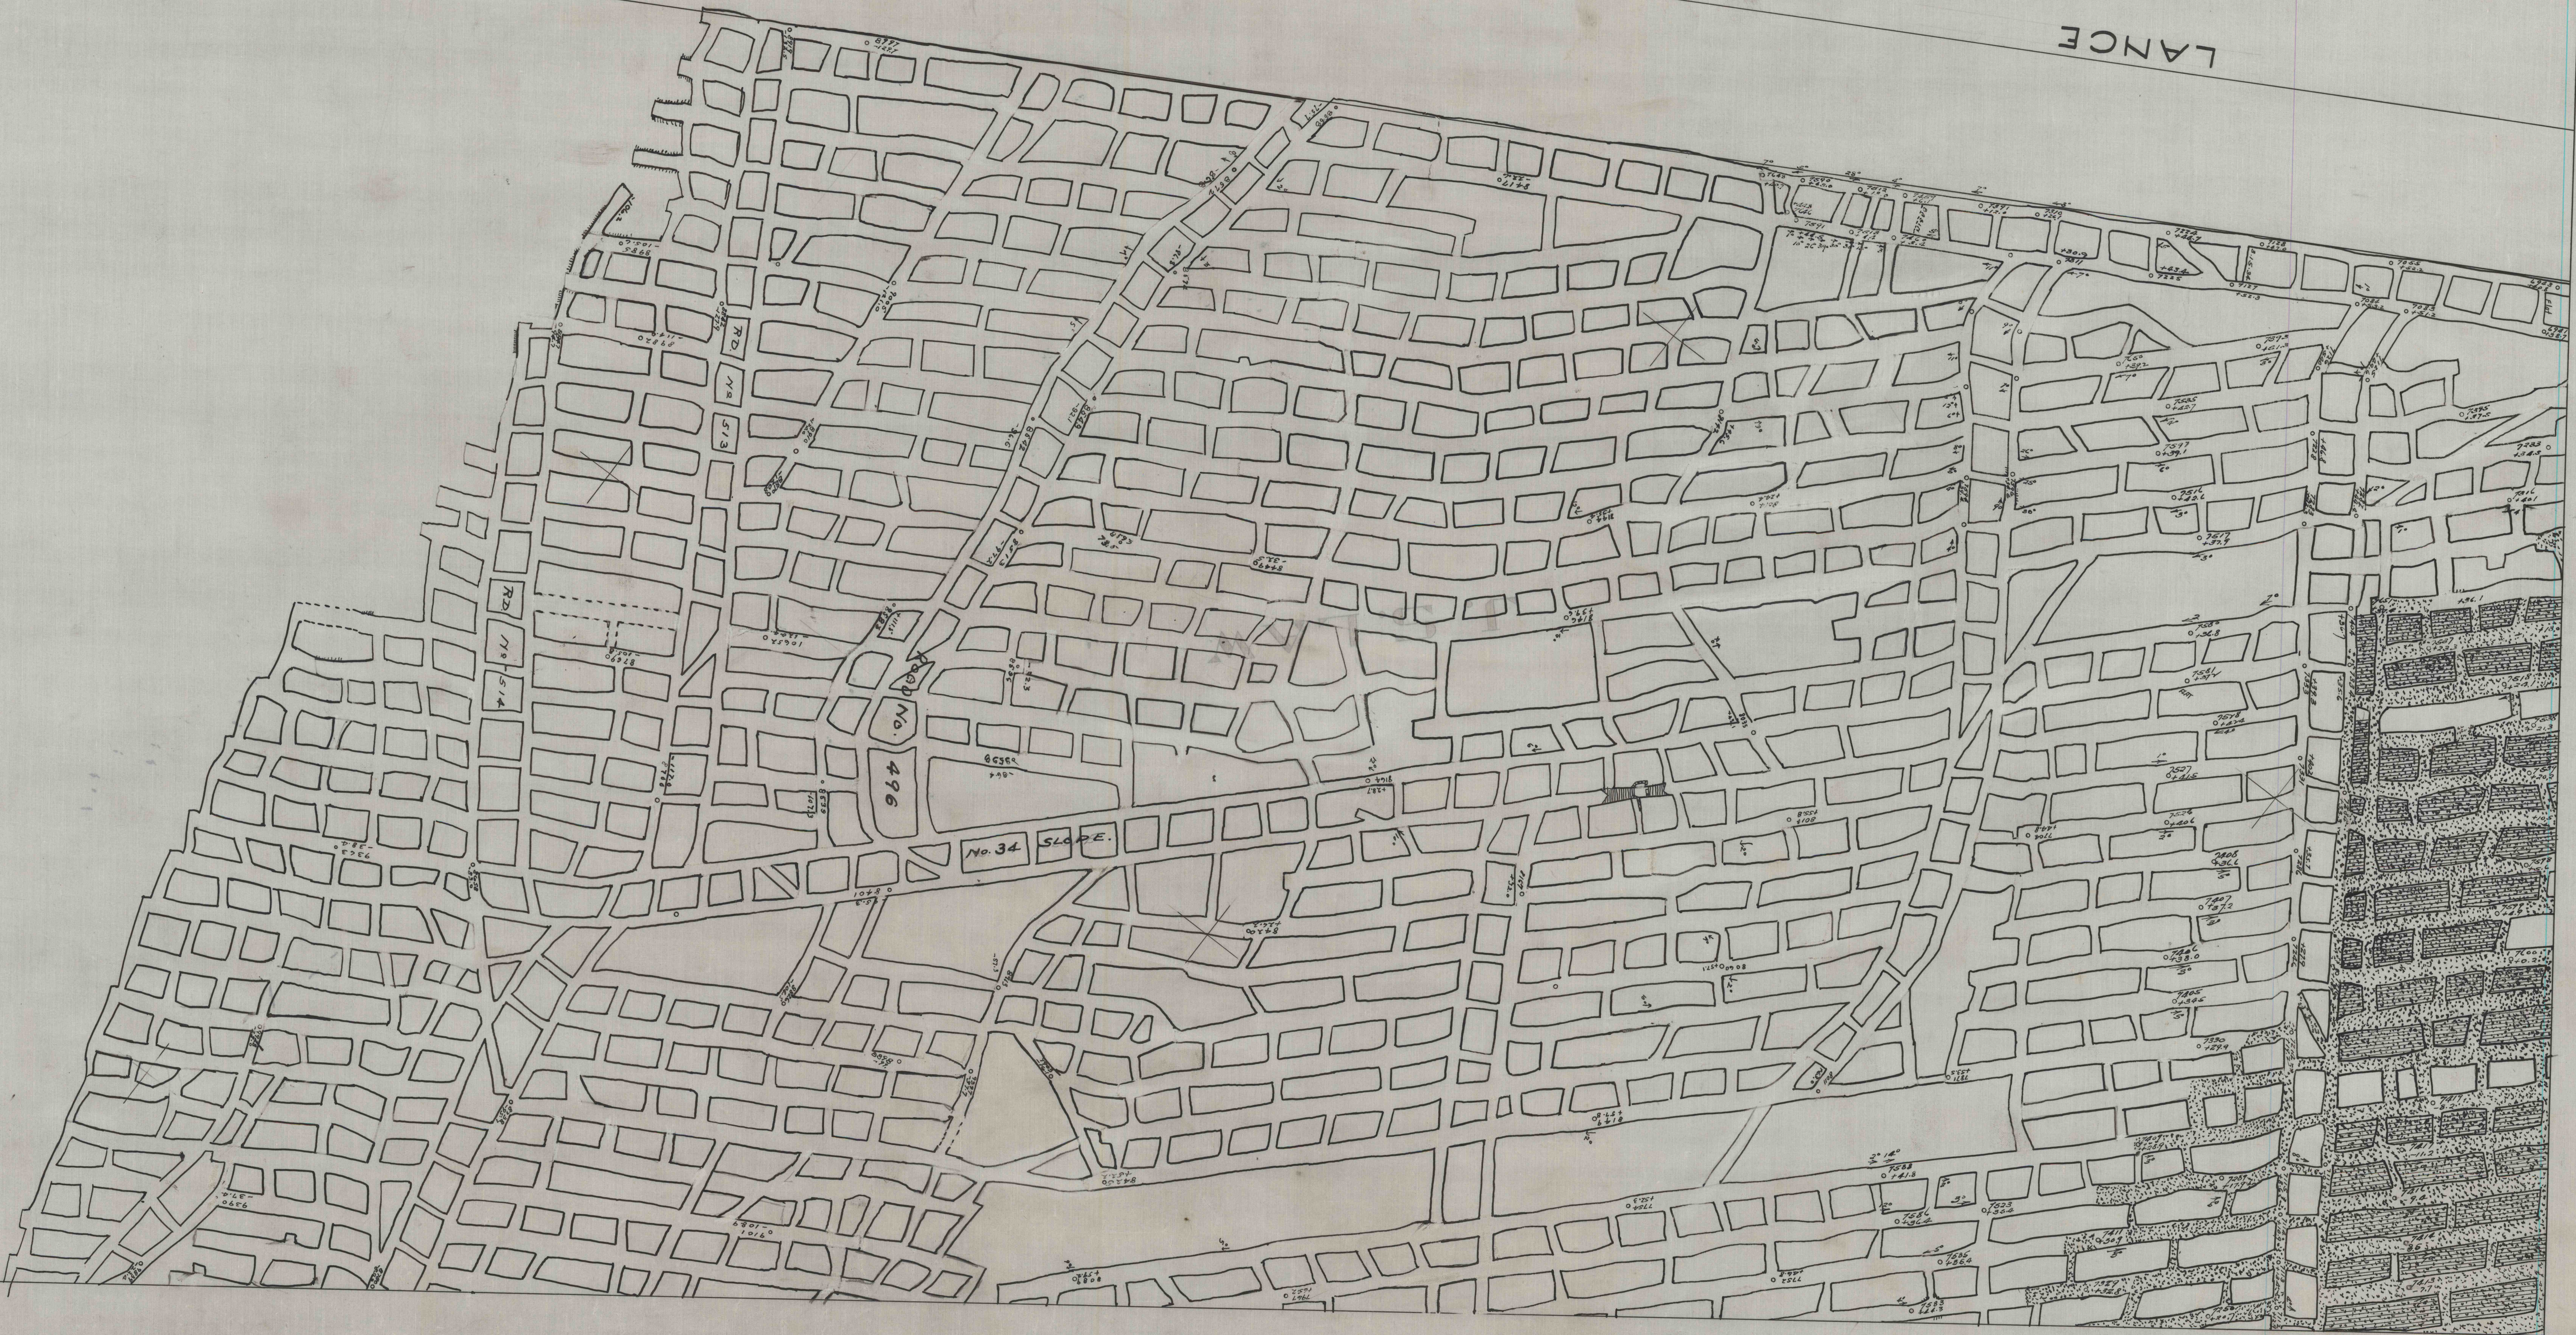

COLLIERY

LANC

No. 496

No. 34 SLOPE

POSTED - APR. 1, 1934.

" " 8, 1935.
" June 18, 1936
" March 17, 1939
" April 7, 1941
" Dec. 10, 1941
" Sept. 11, 1942
" July 8, 1943
" Jan. 8, 1944
" Oct. 9, 1945
" Jan. 18, 1946
" Aug. 11, 1947
" July 8, 1948
" April 9, 1949
" Feb. 17, 1950
" " 1, 1951
" May 21, 1952
" March 11, 1953
" Feb. 13, 1954
" May 1, 1959
" Oct. 12, 1960
" Feb. 5, 1961

NORTHERN COAL FIELD...
INSPECTORS
LUZERNE COUNTY, PLYMOUTH TWP., PA.
WOODWARD MINE
GLEN ALDEN COAL CO.
HILLMAN VEIN
MAP

SCALE . . . 1" = 100'