


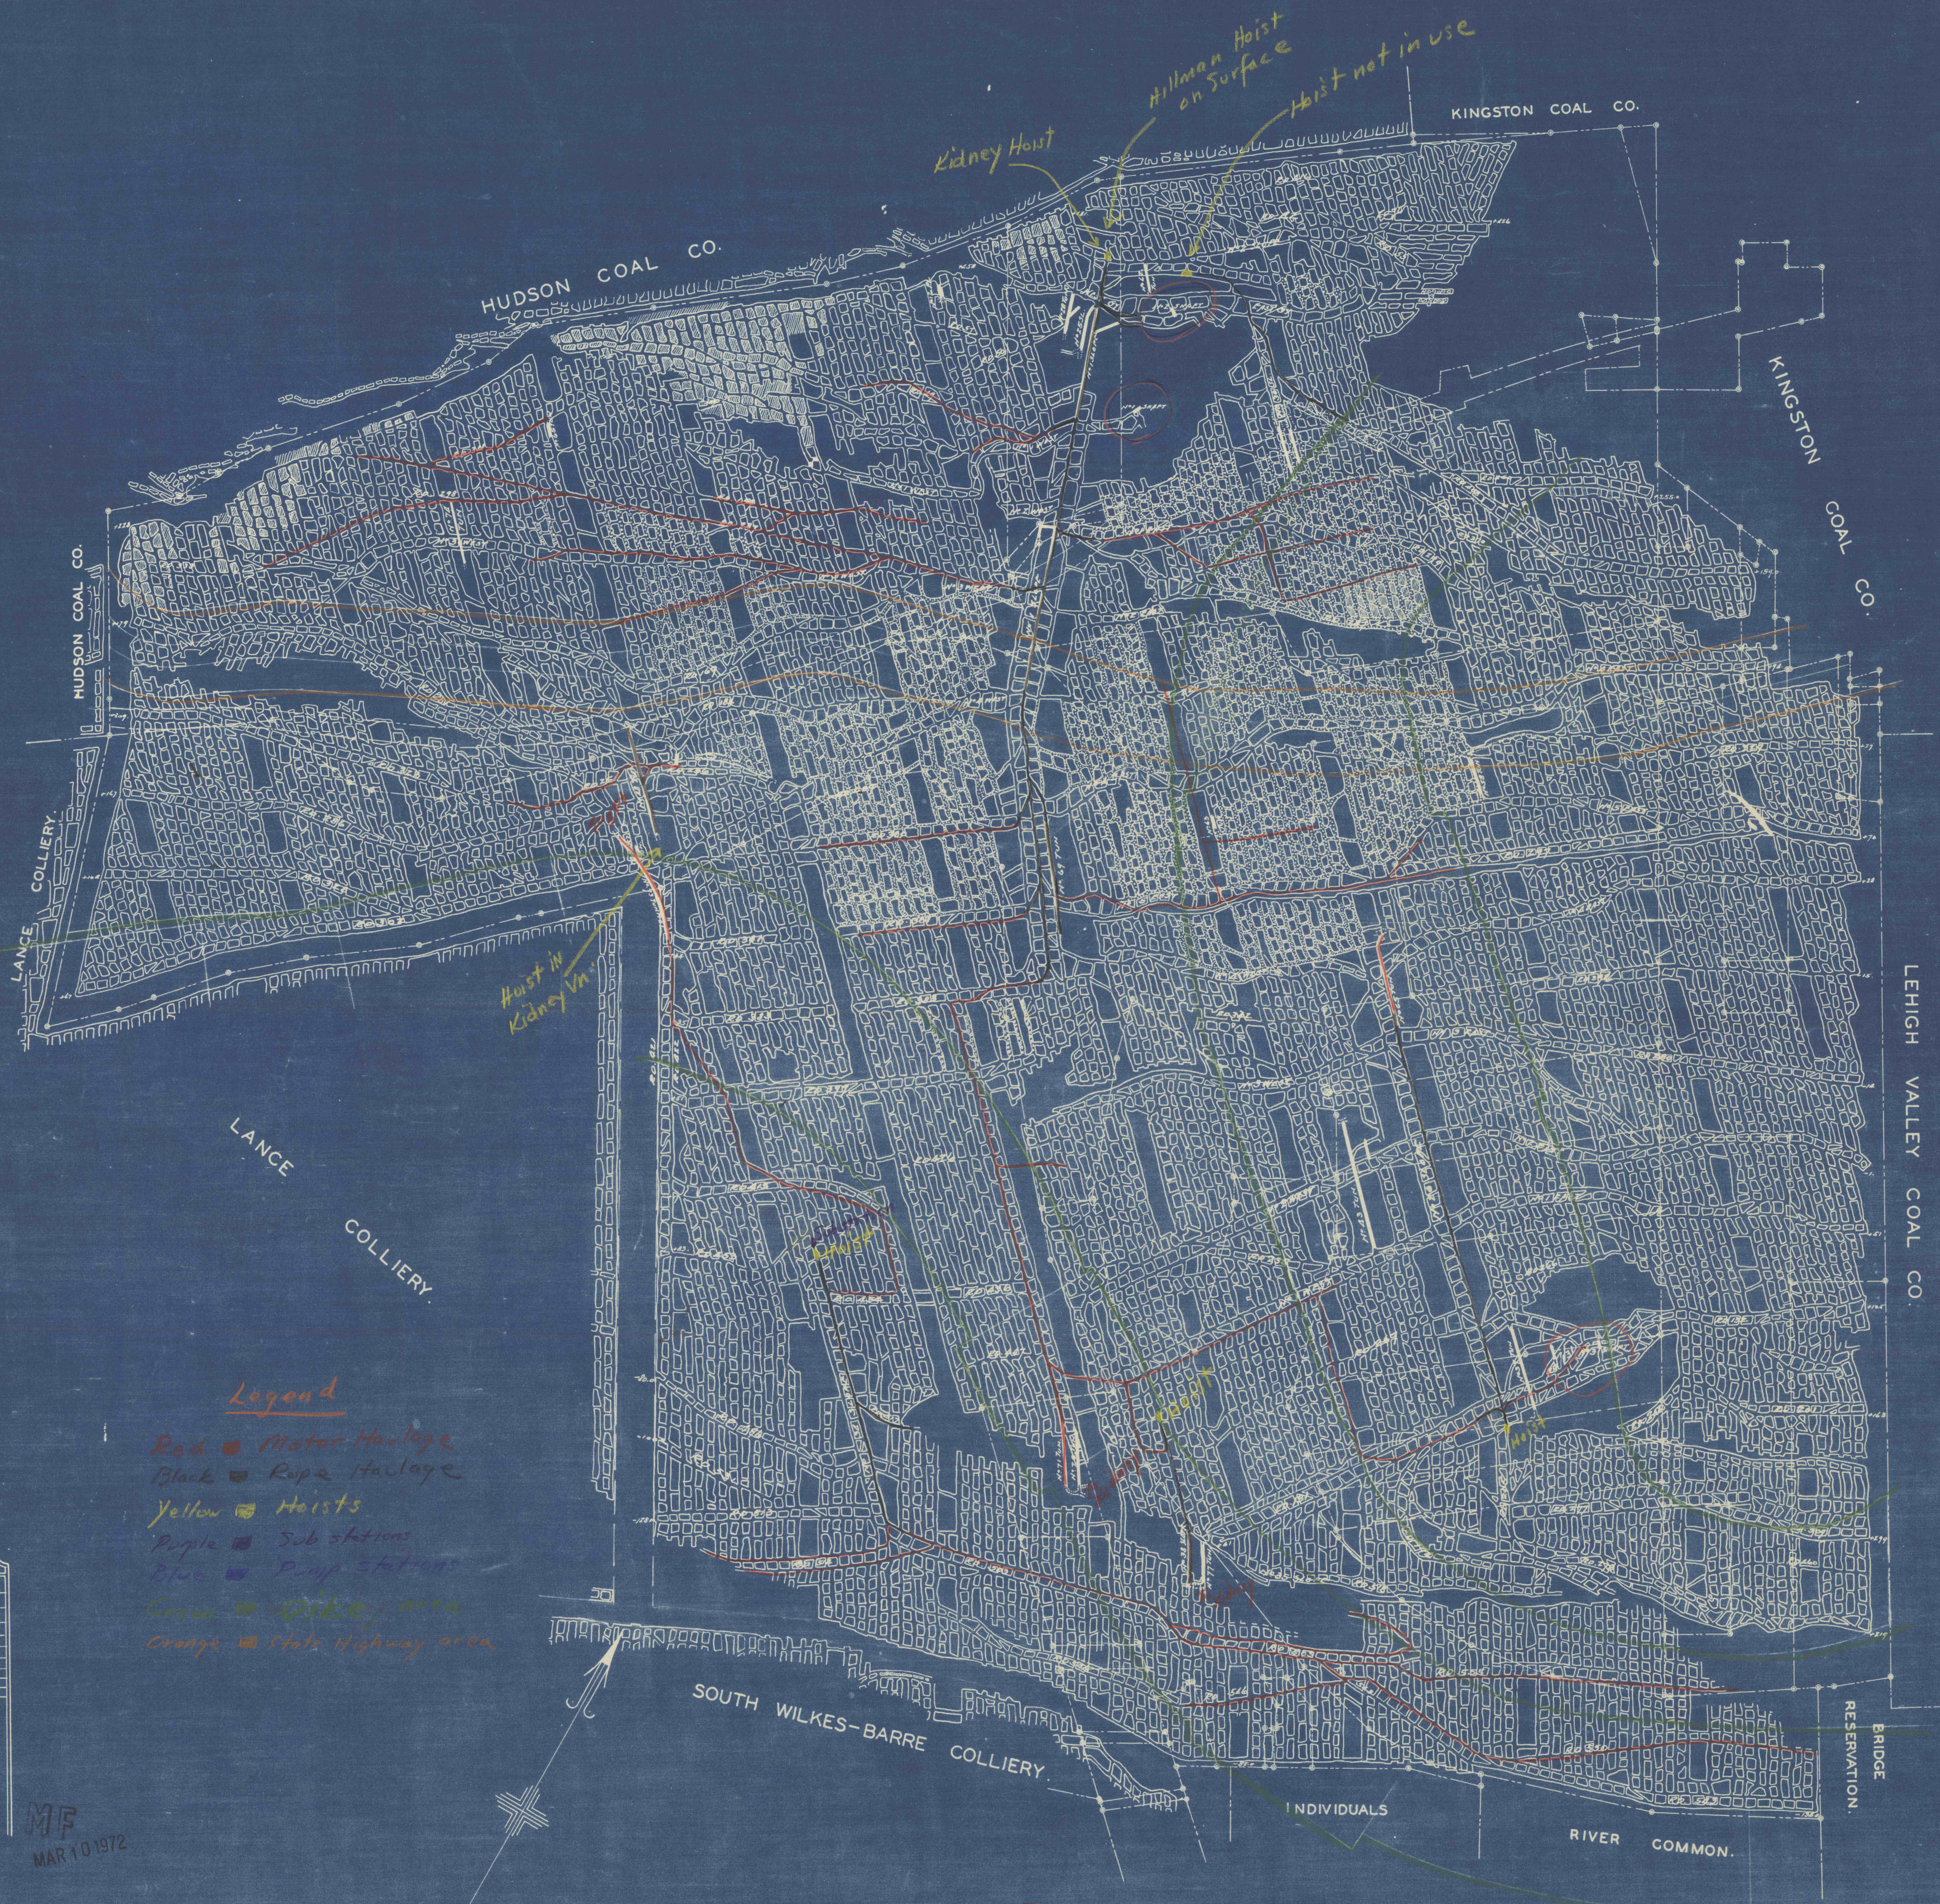

Legend

- Red ■ Motor Haulage
- Black ■ Rope Haulage
- Yellow ■ Hoists
- Purple ■ Sub stations
- Blue ■ Pump stations
- Green ■ Dike area
- Orange ■ State Highway area

POSTED	
In Service	Jan 28
Apr 17	20
May 3	42
Oct 29	63
Nov 8	46
Nov 19	47
July 29	28
Aug 29	29
Feb 22	28

MF
MAR 10 1972

NORTHERN COAL FIELD
WOODWARD COLLIERY
HILLMAN VEIN LUZERNE COUNTY
SCALE, 1 INCH = 400 FEET. PLYMOUTH TWP, PA