


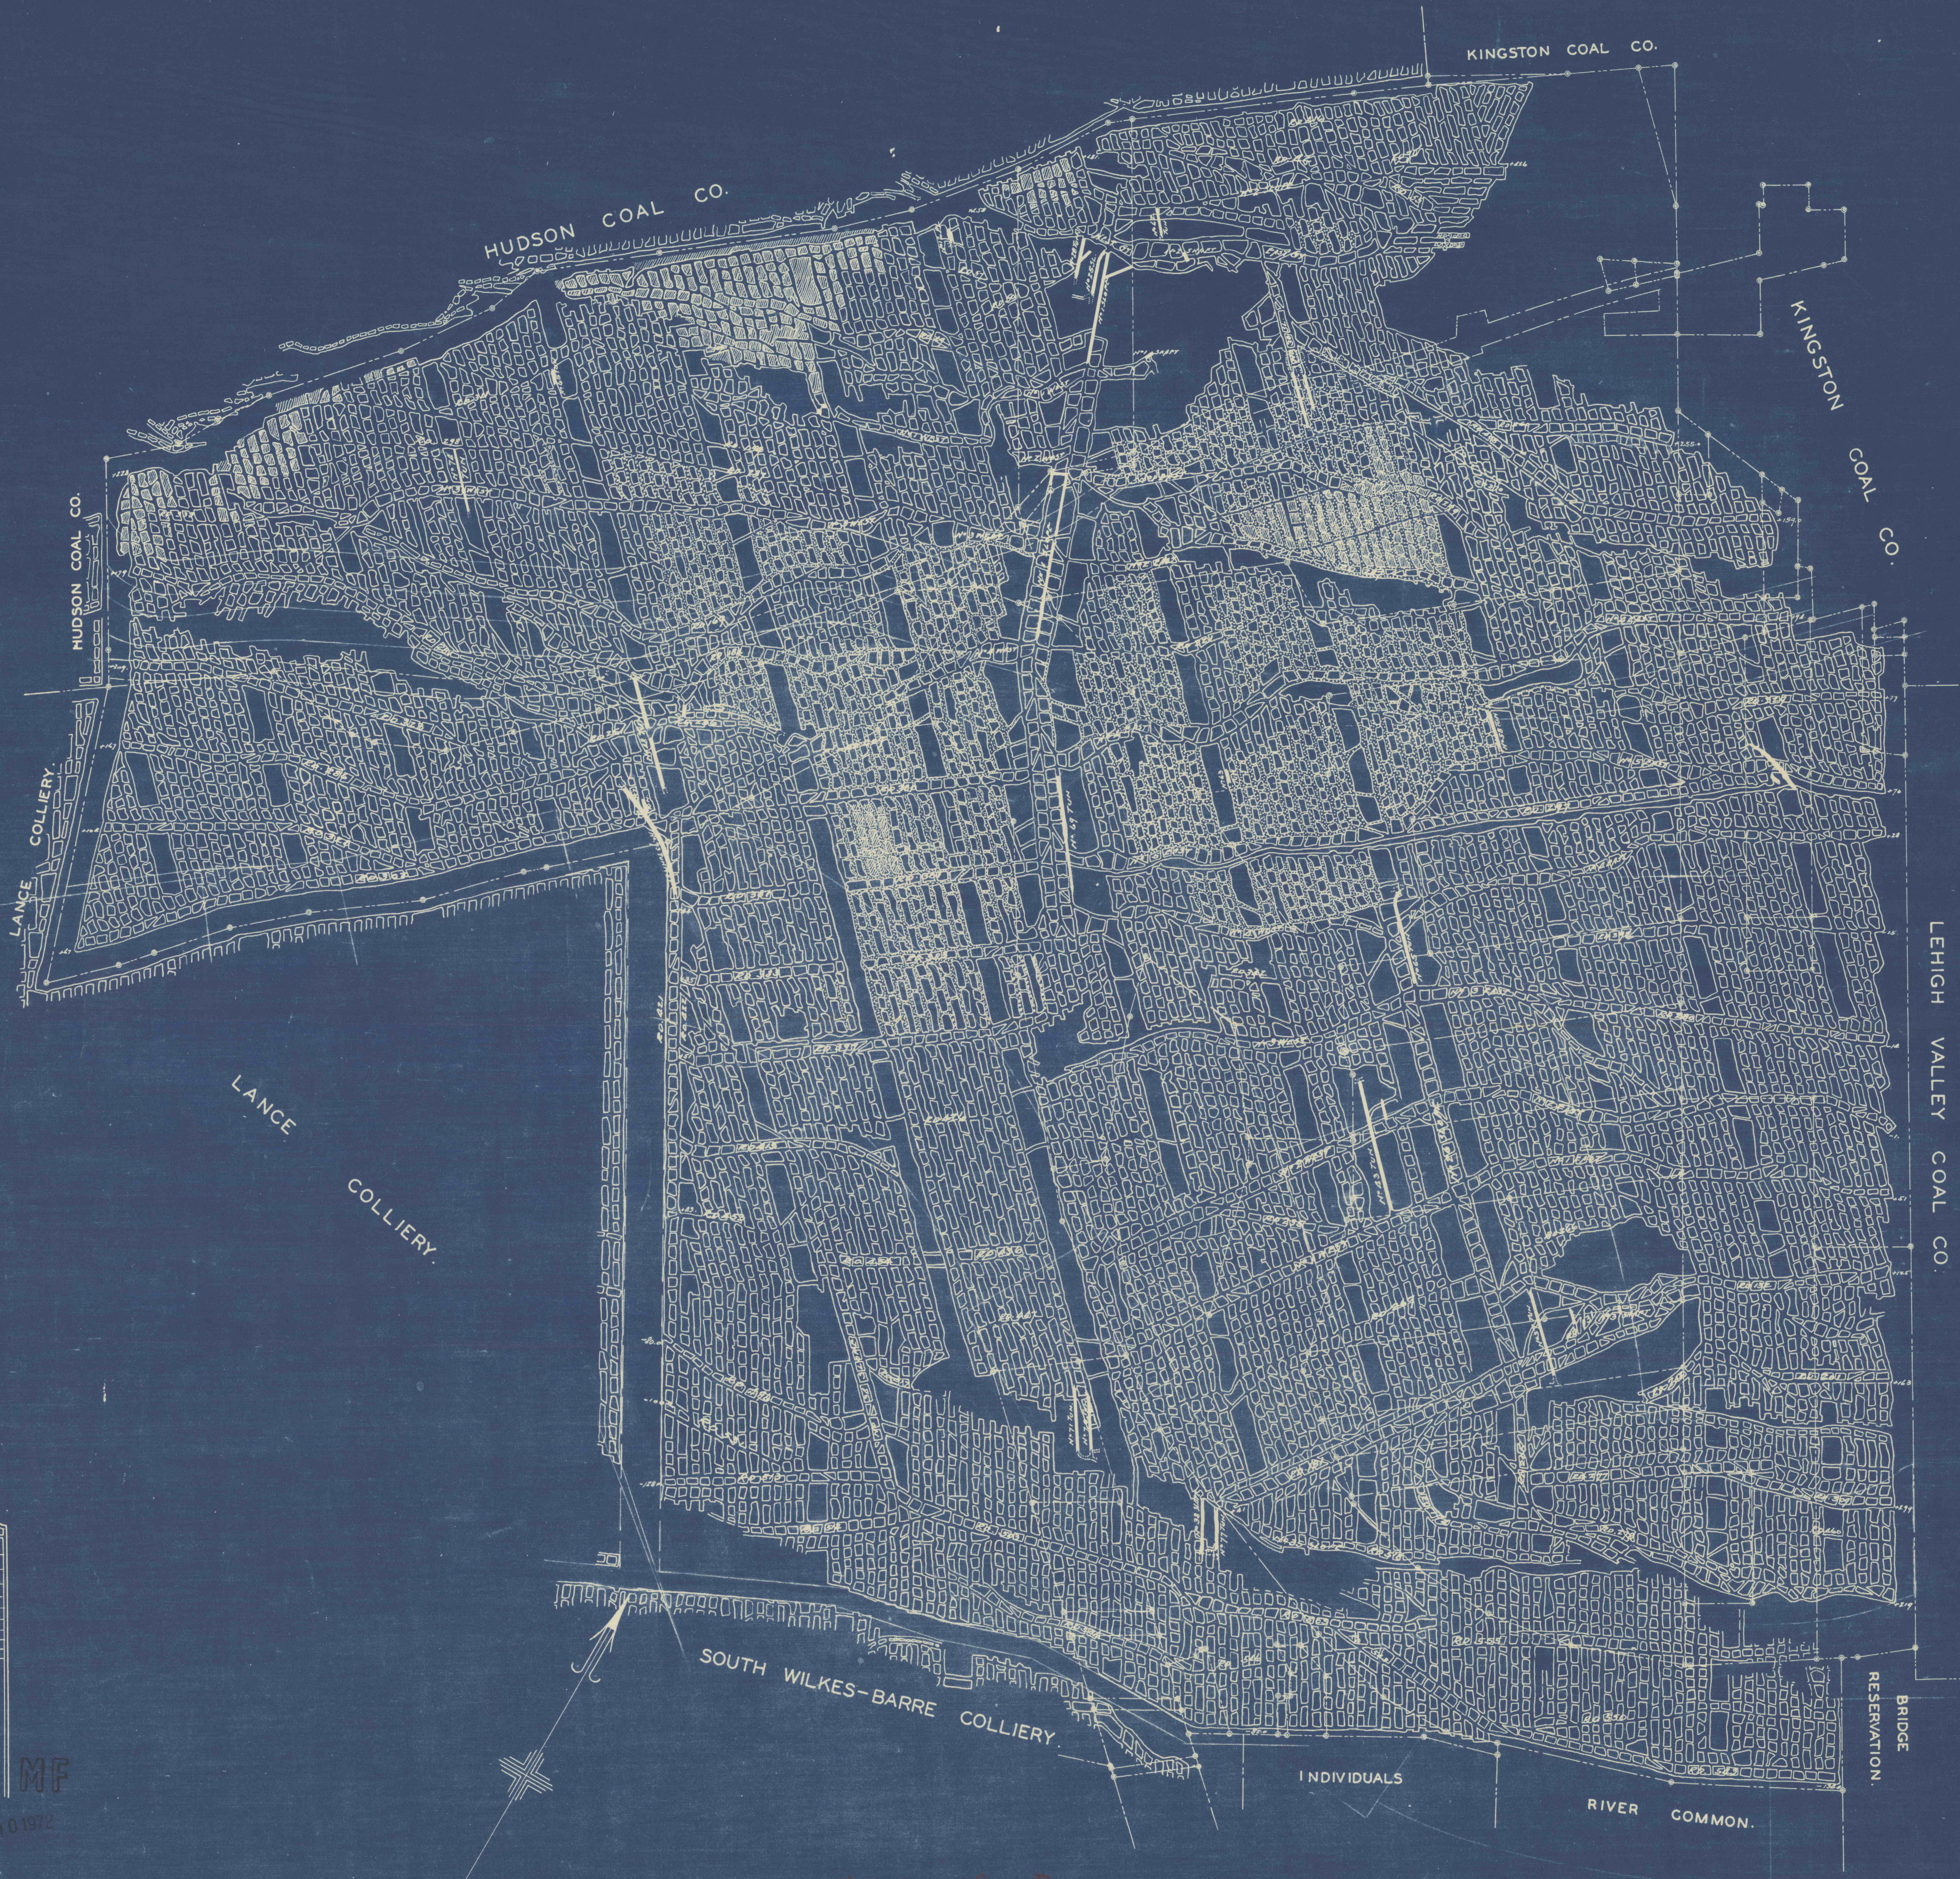

POSTED.	
IN SERVICE	JUNE 50
APR. 17, 40	F
NOV. 3, 42	F
APR. 27, 45	F
MAY 2, 46	F
NOV. 19, 48	F
JULY 29, 49	F
APR. 27, 49	F
APR. 27, 49	F
NOV. 20, 50	F

MF

MAR 10 1972

NORTHERN COAL FIELD
 WOODWARD COLLIERY
 HILLMAN VEIN, LUZERNE COUNTY
 SCALE, 1 INCH = 400 FEET. PLYMOUTH TWP., PA.