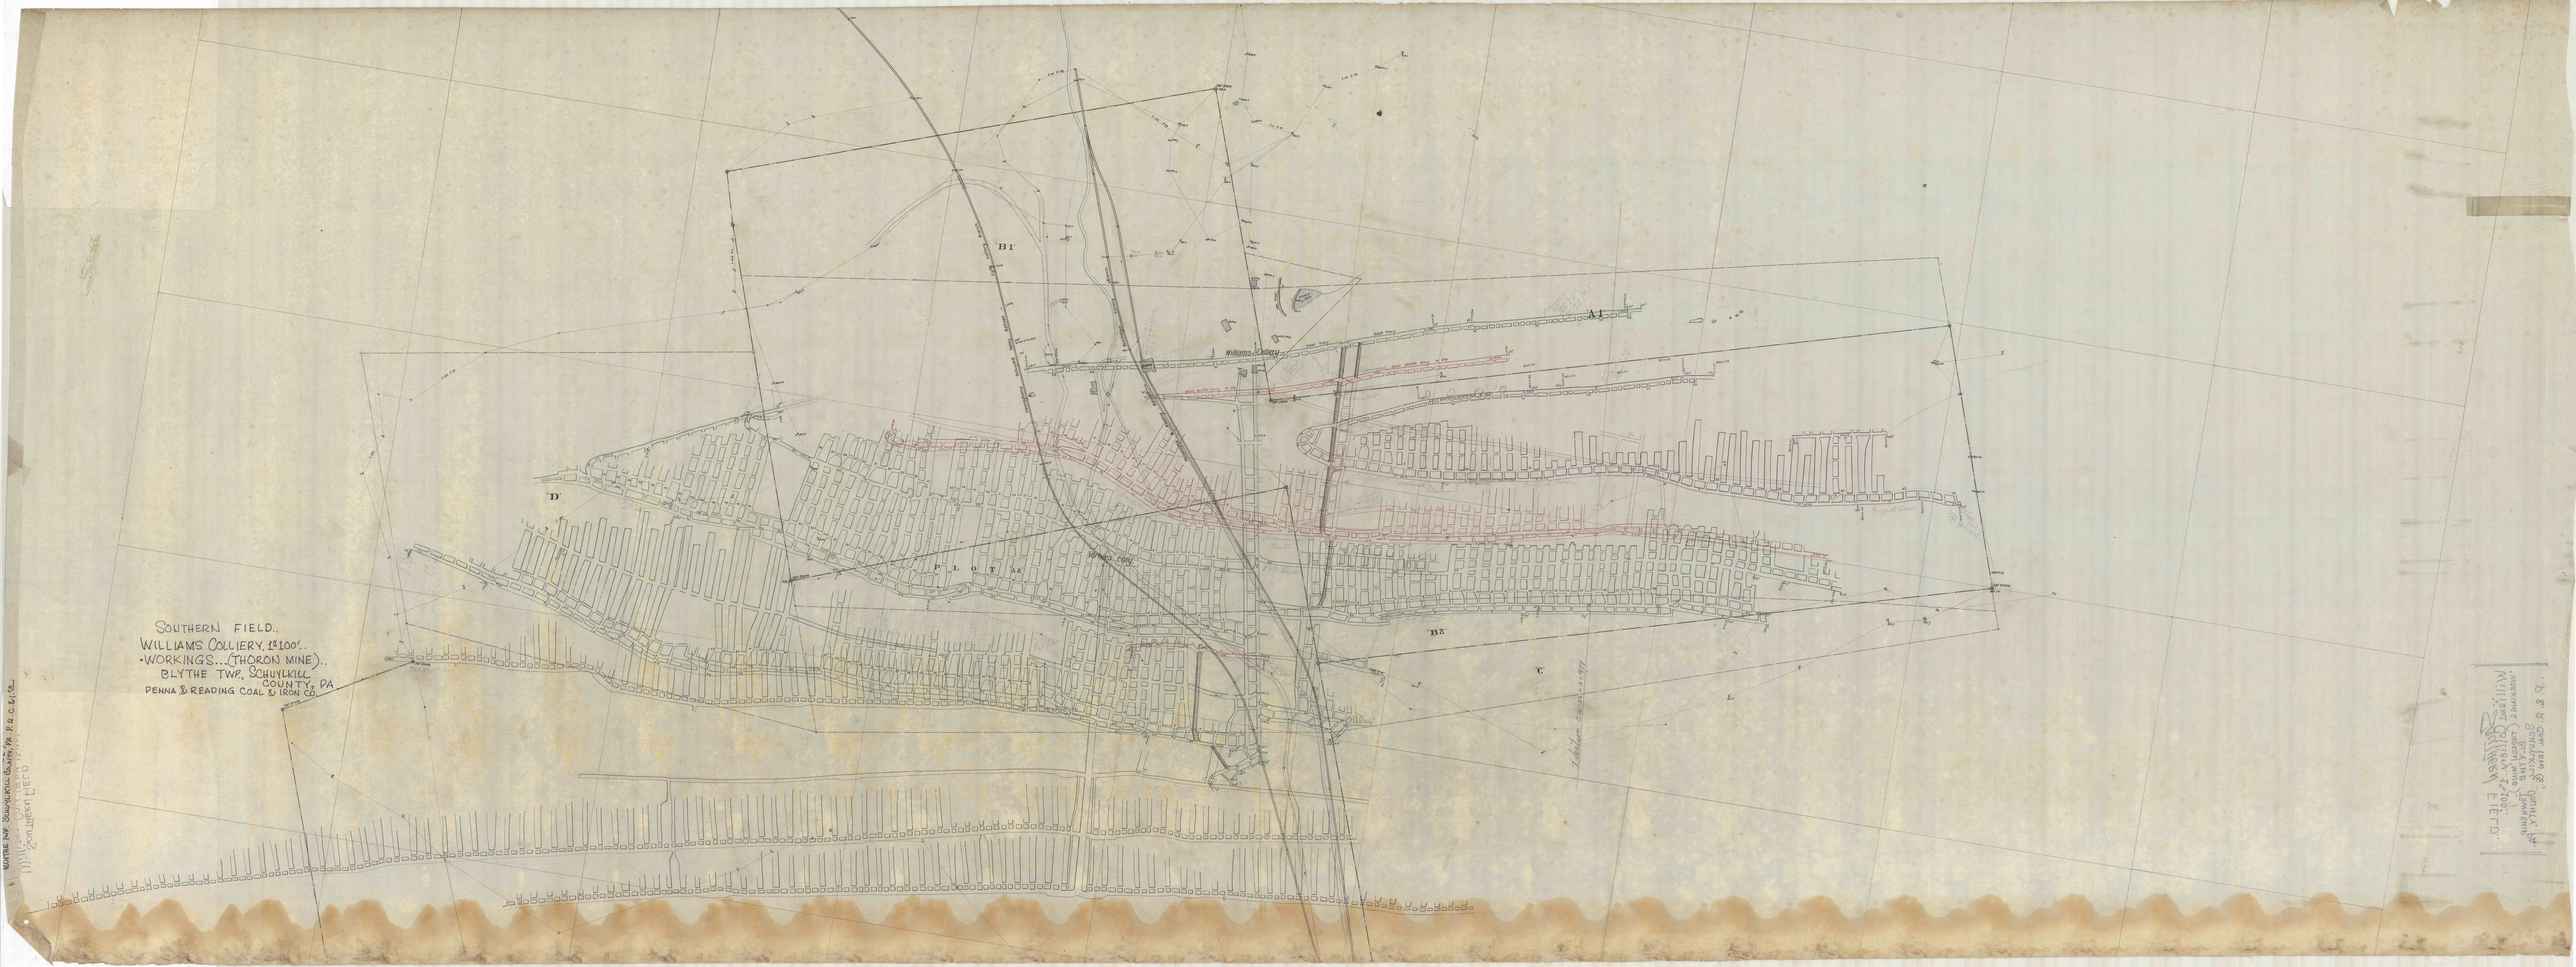

SOUTHERN FIELD..
WILLIAMS COLLIERY, 1" = 100'..
•WORKINGS...(THORON MINE)..
BLYTHE TWP., SCHUYLKILL
COUNTY, PA
PENNA. & READING COAL & IRON CO.

B1
A1
Williams Colliery
West Tracy
West Smith Gwy. N. Dip
Breaker
Boilers
Smith Shop
Fan
Office
Eng. Ho.
Present Dam
New Breast
Set Stone
Beechwood Colliery
Reading Railroad
D
PLOT "A2"
Vorhees Colly.
1st. East
B2
C

BLYTHE TWP. SCHUYLKILL COUNTY, PA. P.R.C.&I.Co.