
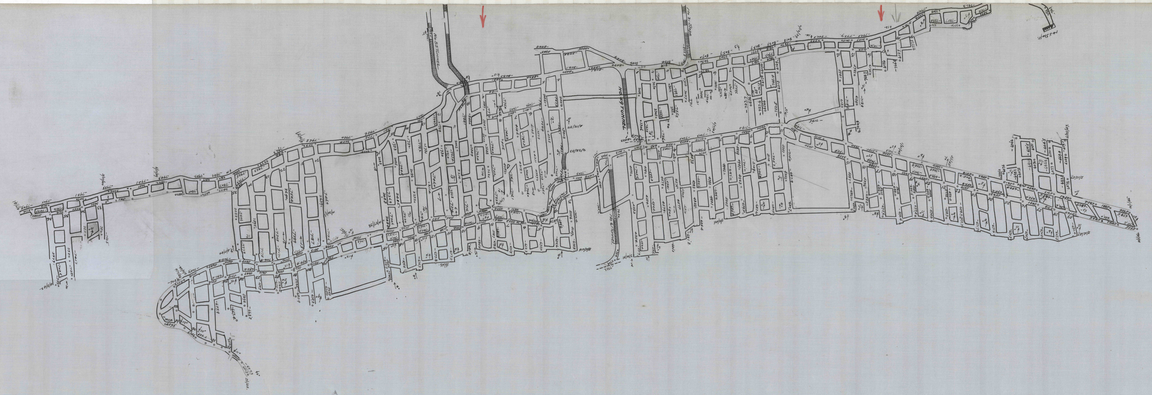


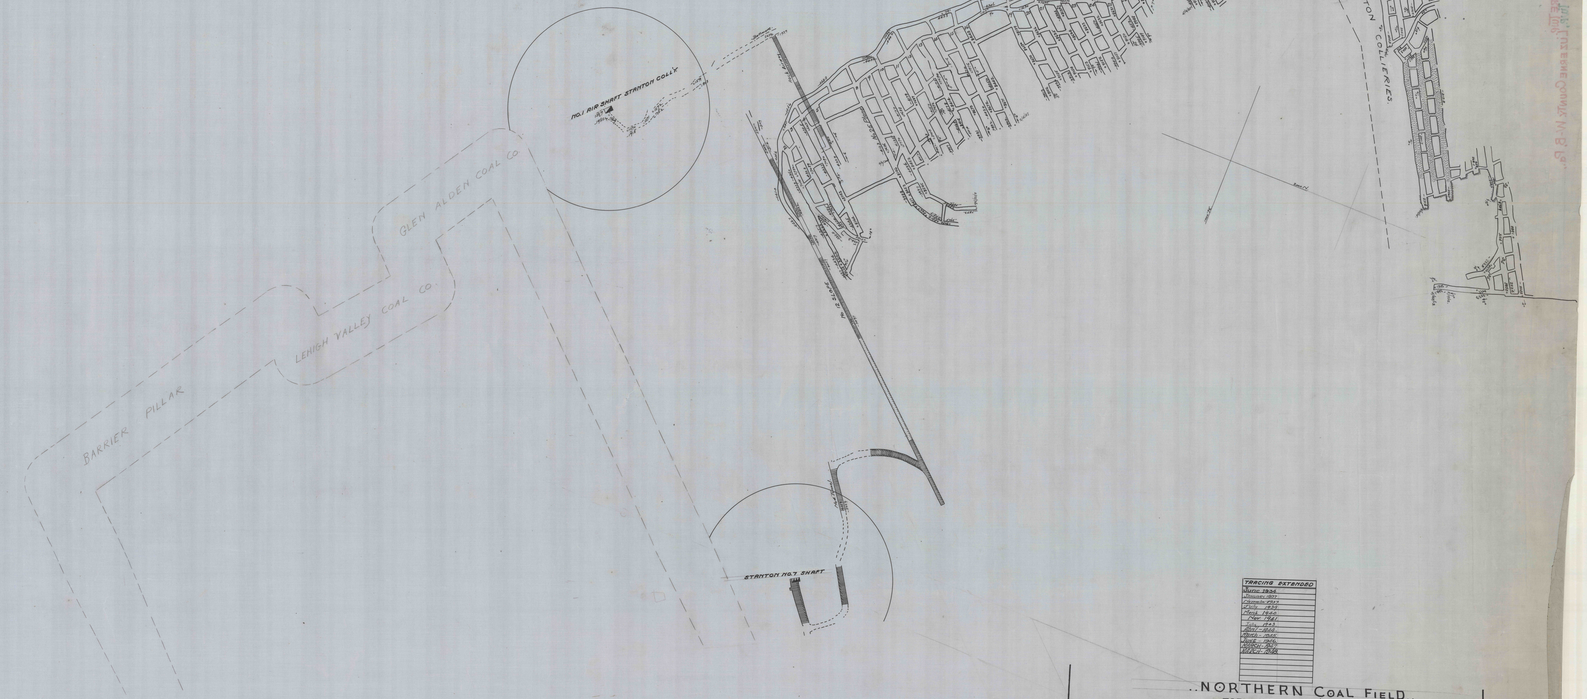


..NORTHERN COAL FIELD..

TOP RED ASH VEIN

SOUTH WILKES-BARRE NO. 5 & STANTON NO. 7 COLLIERIES

GLEN ALDEN COAL COMPANY

..SHEET 1 OF 2.. SCALE: 1 INCH = 100 FT OCT 1930

W-BARRE TWP.. LUZERNE COUNTY. 4-W-B DISTRICT. PA.,

..NORTHERN COAL FIELD..TOP RED ASH VEIN..SOUTH WILKES-BARRE NO. 5 & STANTON NO. 7 COLLIERIES..GLEN ALDEN COAL CO OCT 1930 W-BARRE TWP..LUZERNE COUNTY..4-W-B DISTRICT..PA.. SHEET 1 OF 2 SHEETS.