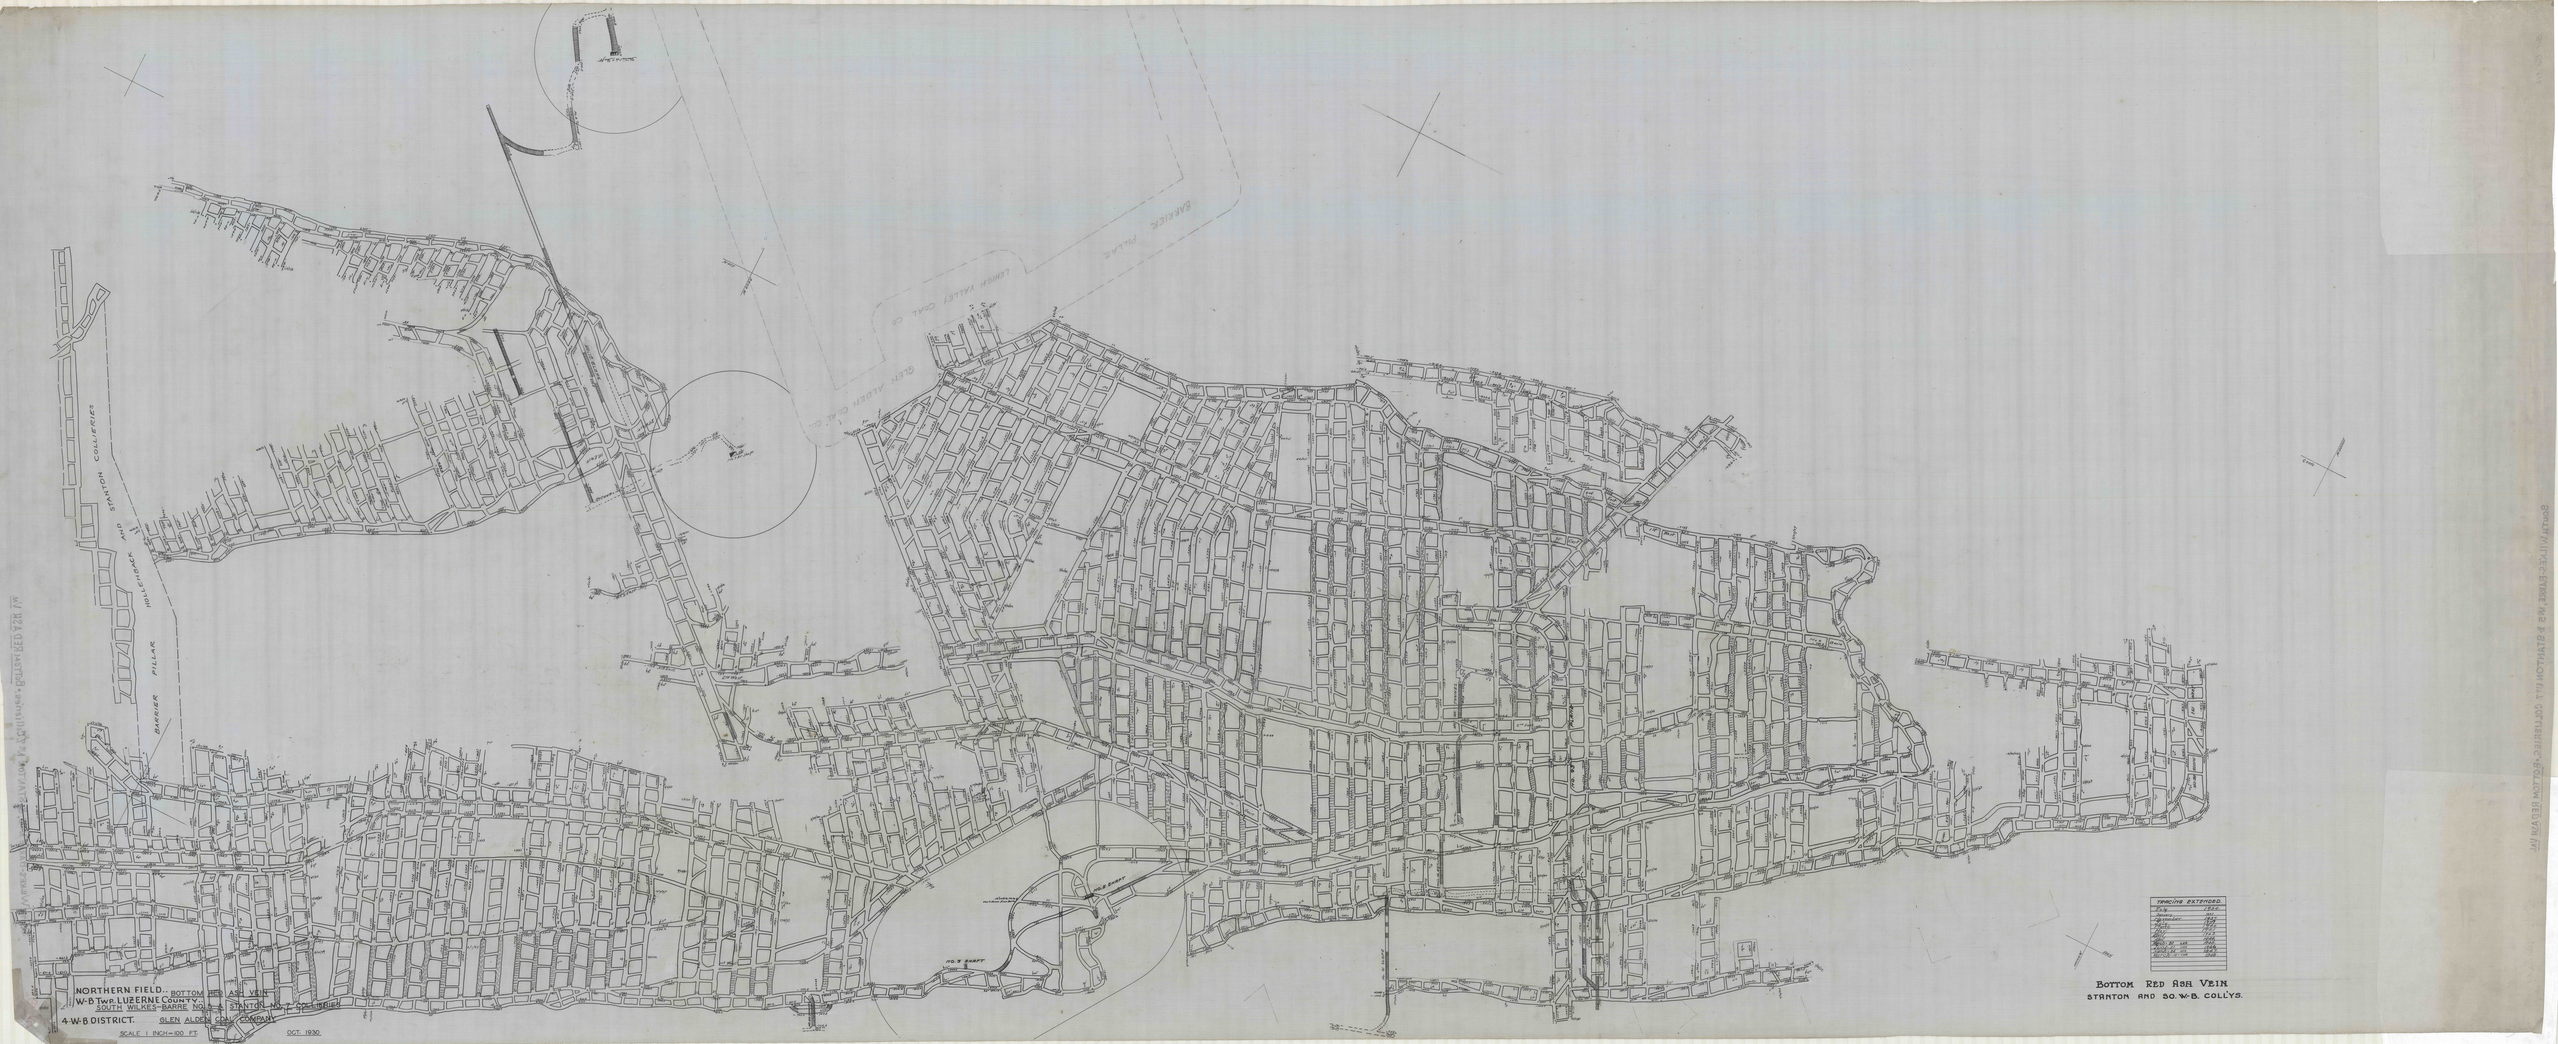

NORTHERN FIELD. - BOTTOM RED ASH VEIN
W-B Twp. LUZERNE COUNTY.
4-W-B DISTRICT. GLEN ALDEN COAL COMPANY
SCALE 1 INCH=100 FT OCT 1930
BOTTOM RED ASH VEIN
STANTON AND SO. W-B. COLLYS.
Feb 1932.
