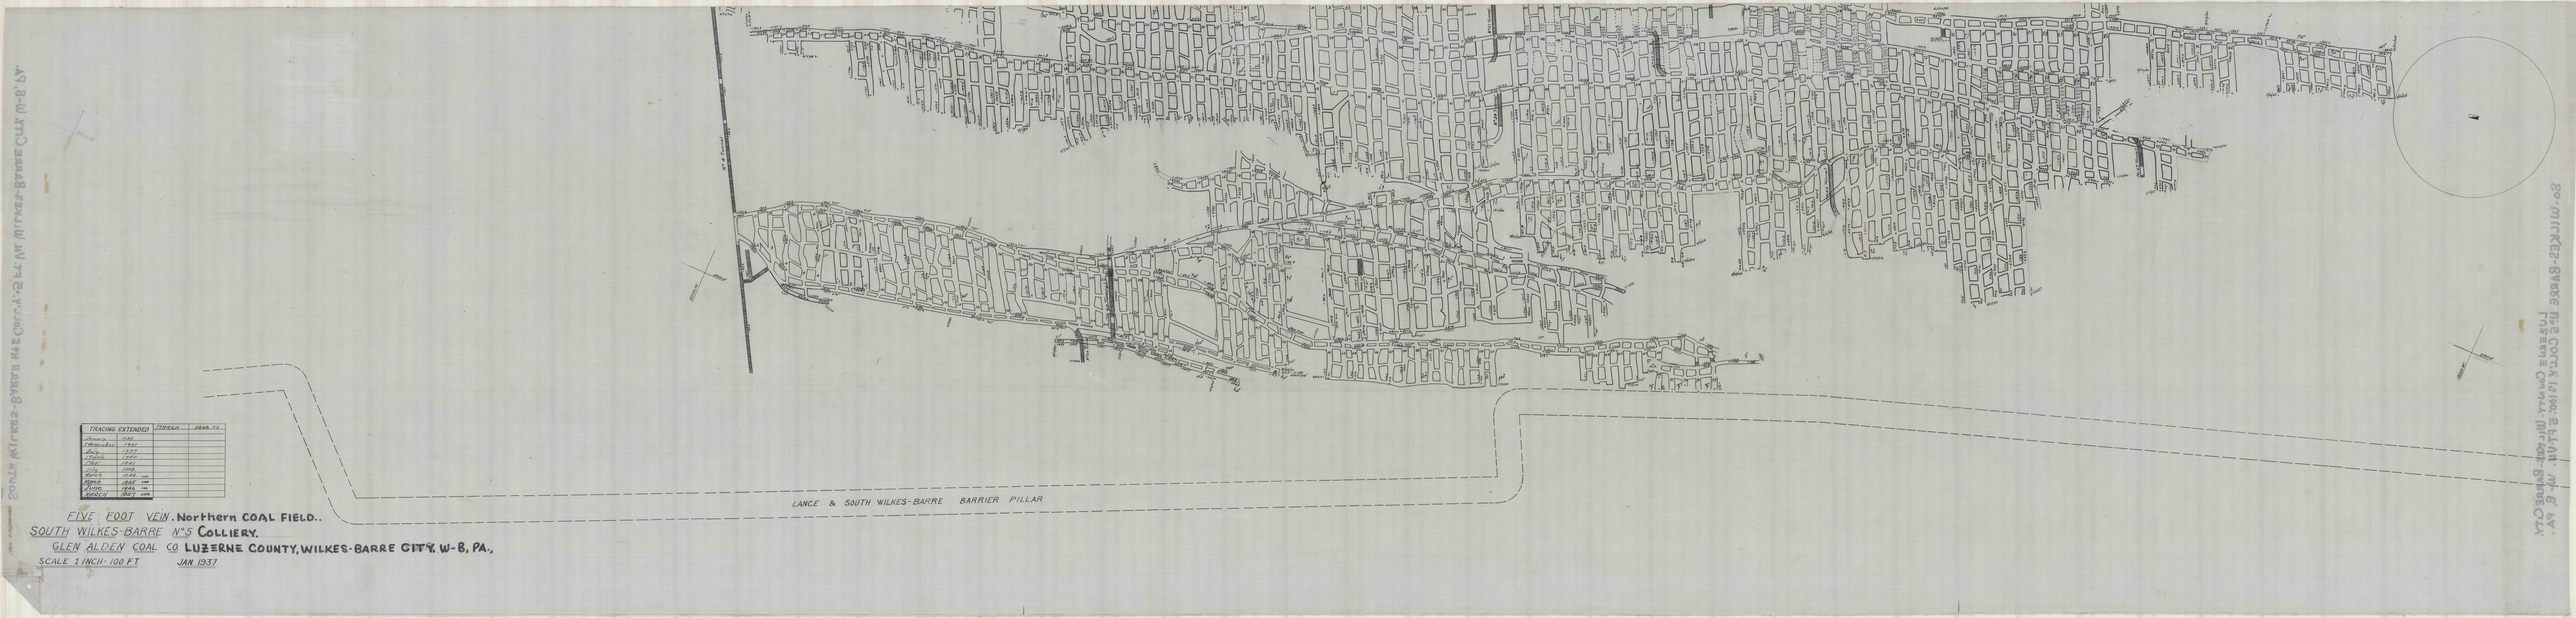

LANCE & SOUTH WILKES-BARRE BARRIER PILLAR

TRACING EXTENDED		MARCH	1948 T.J.
January	1937		
November	1937		
July	1939		
March	1940		
Nov.	1941		
July	1943.		
March	1944. CER		
March	1945 CER		
June	1946 CER		
MARCH	1947. CER.		

FIVE FOOT VEIN. **Northern COAL FIELD..**
SOUTH WILKES-BARRE N°5 **COLLIERY.**
GLEN ALDEN COAL CO. **LUZERNE COUNTY, WILKES-BARRE CITY. W-B, PA.,**
SCALE 1 INCH = 100 FT. JAN. 1937