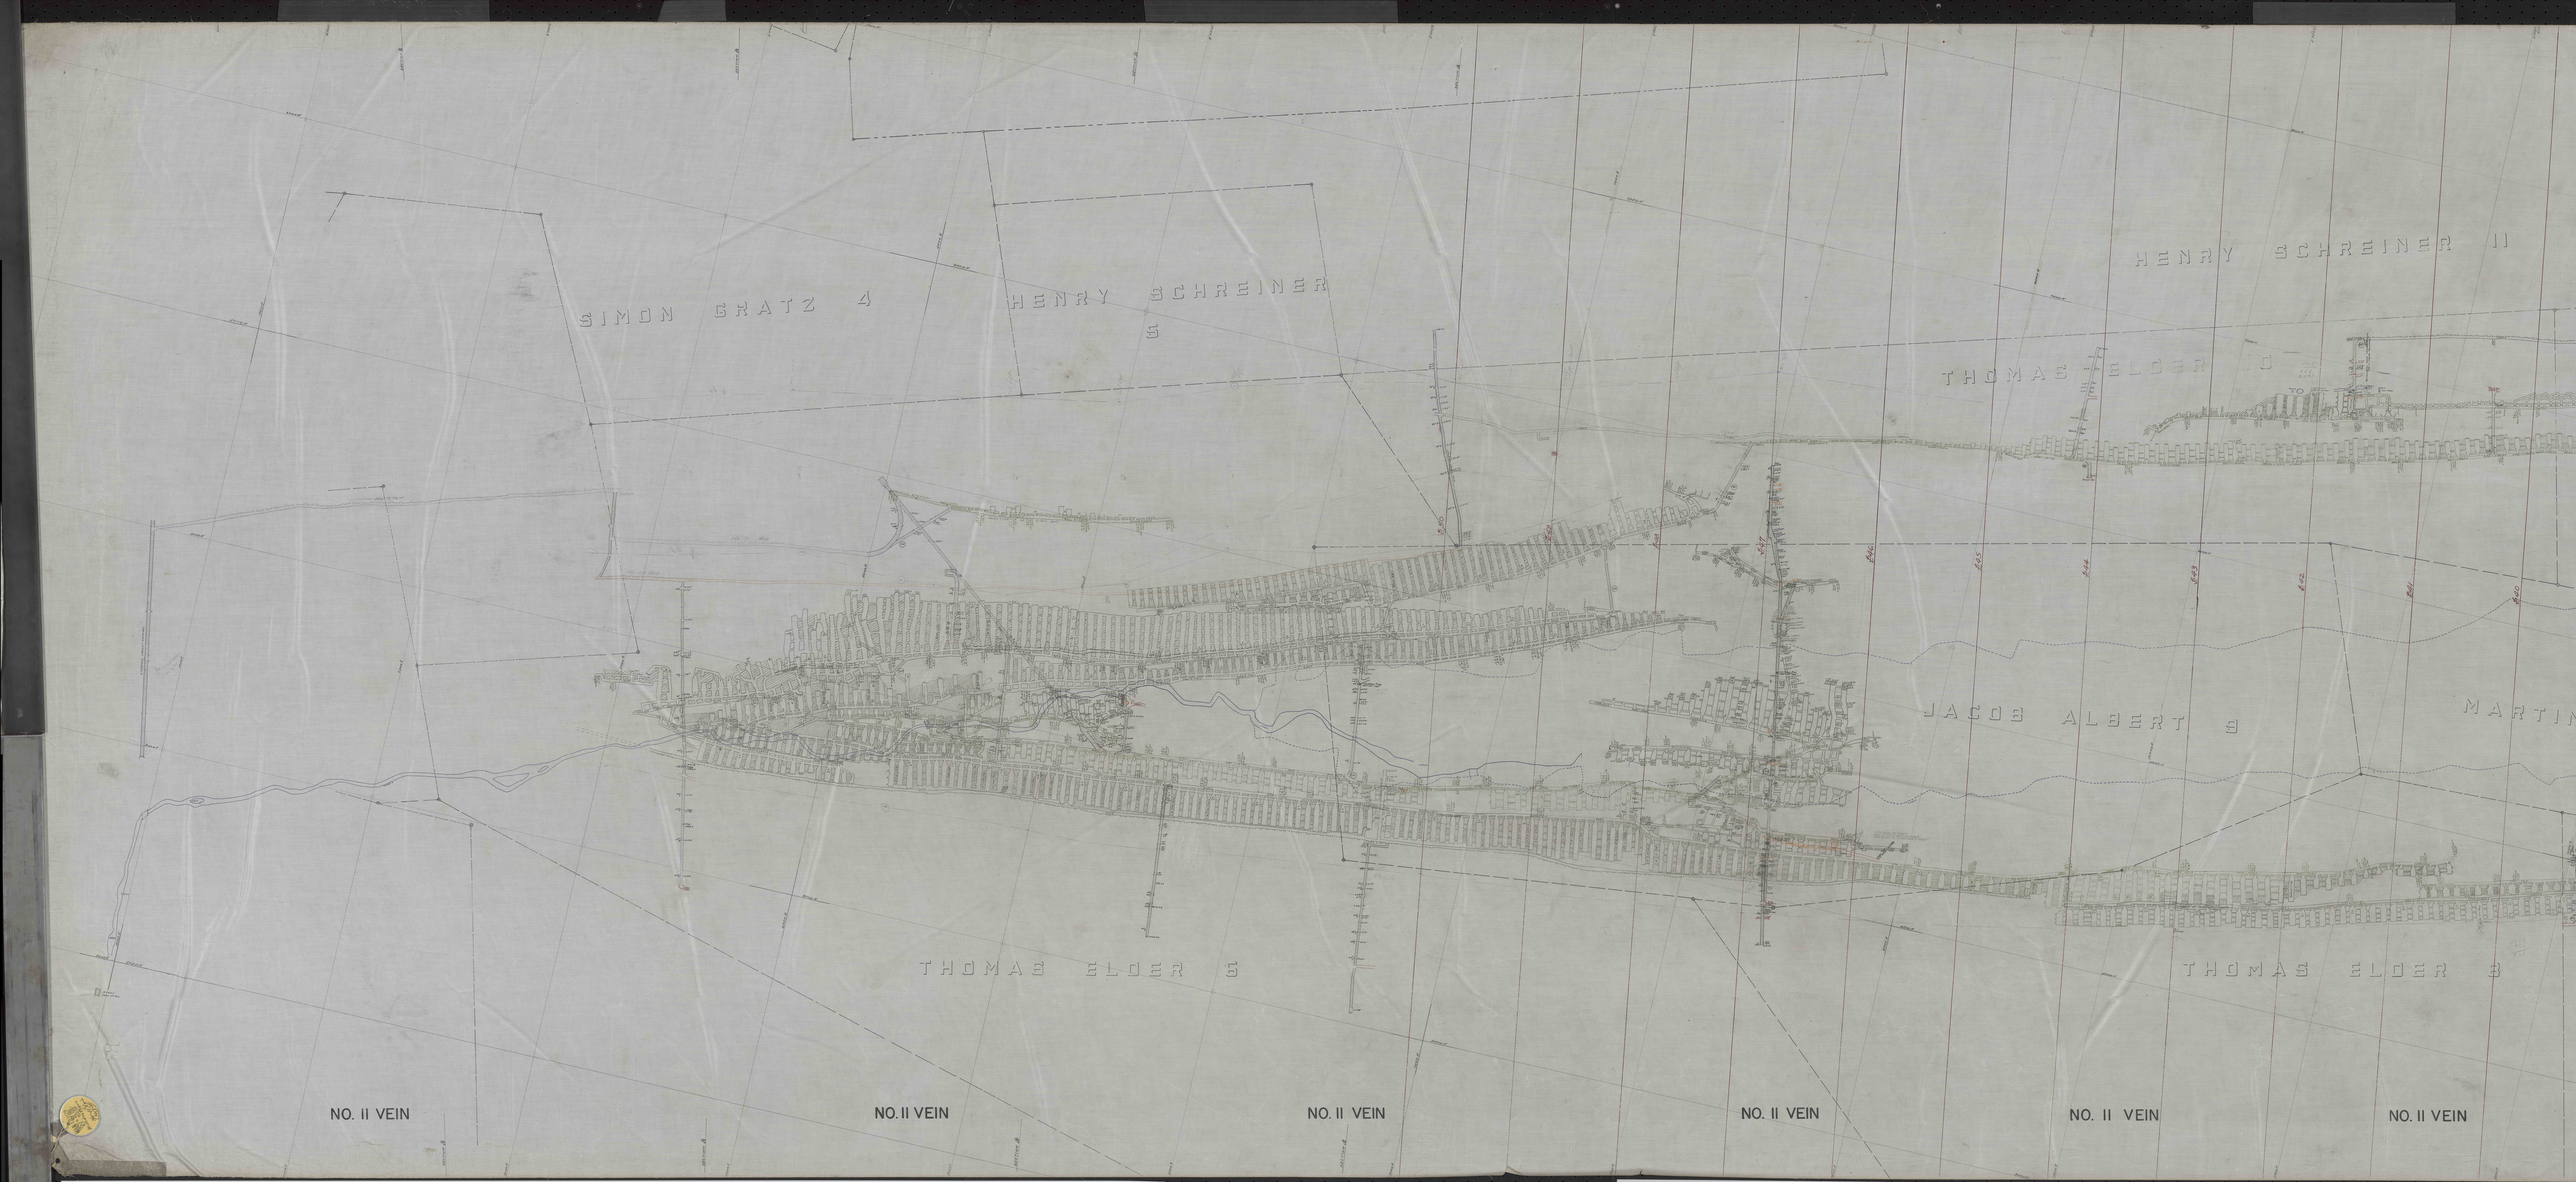

SIMON GRATZ 4
HENRY SCHREINER 5
HENRY SCHREINER 11
THOMAS ELDER 10
JACOB ALBERT 9
MARTIN
THOMAS ELDER 6
THOMAS ELDER 8
NO. II VEIN
NO. II VEIN
NO. II VEIN
NO. II VEIN
NO. II VEIN
NO. II VEIN