


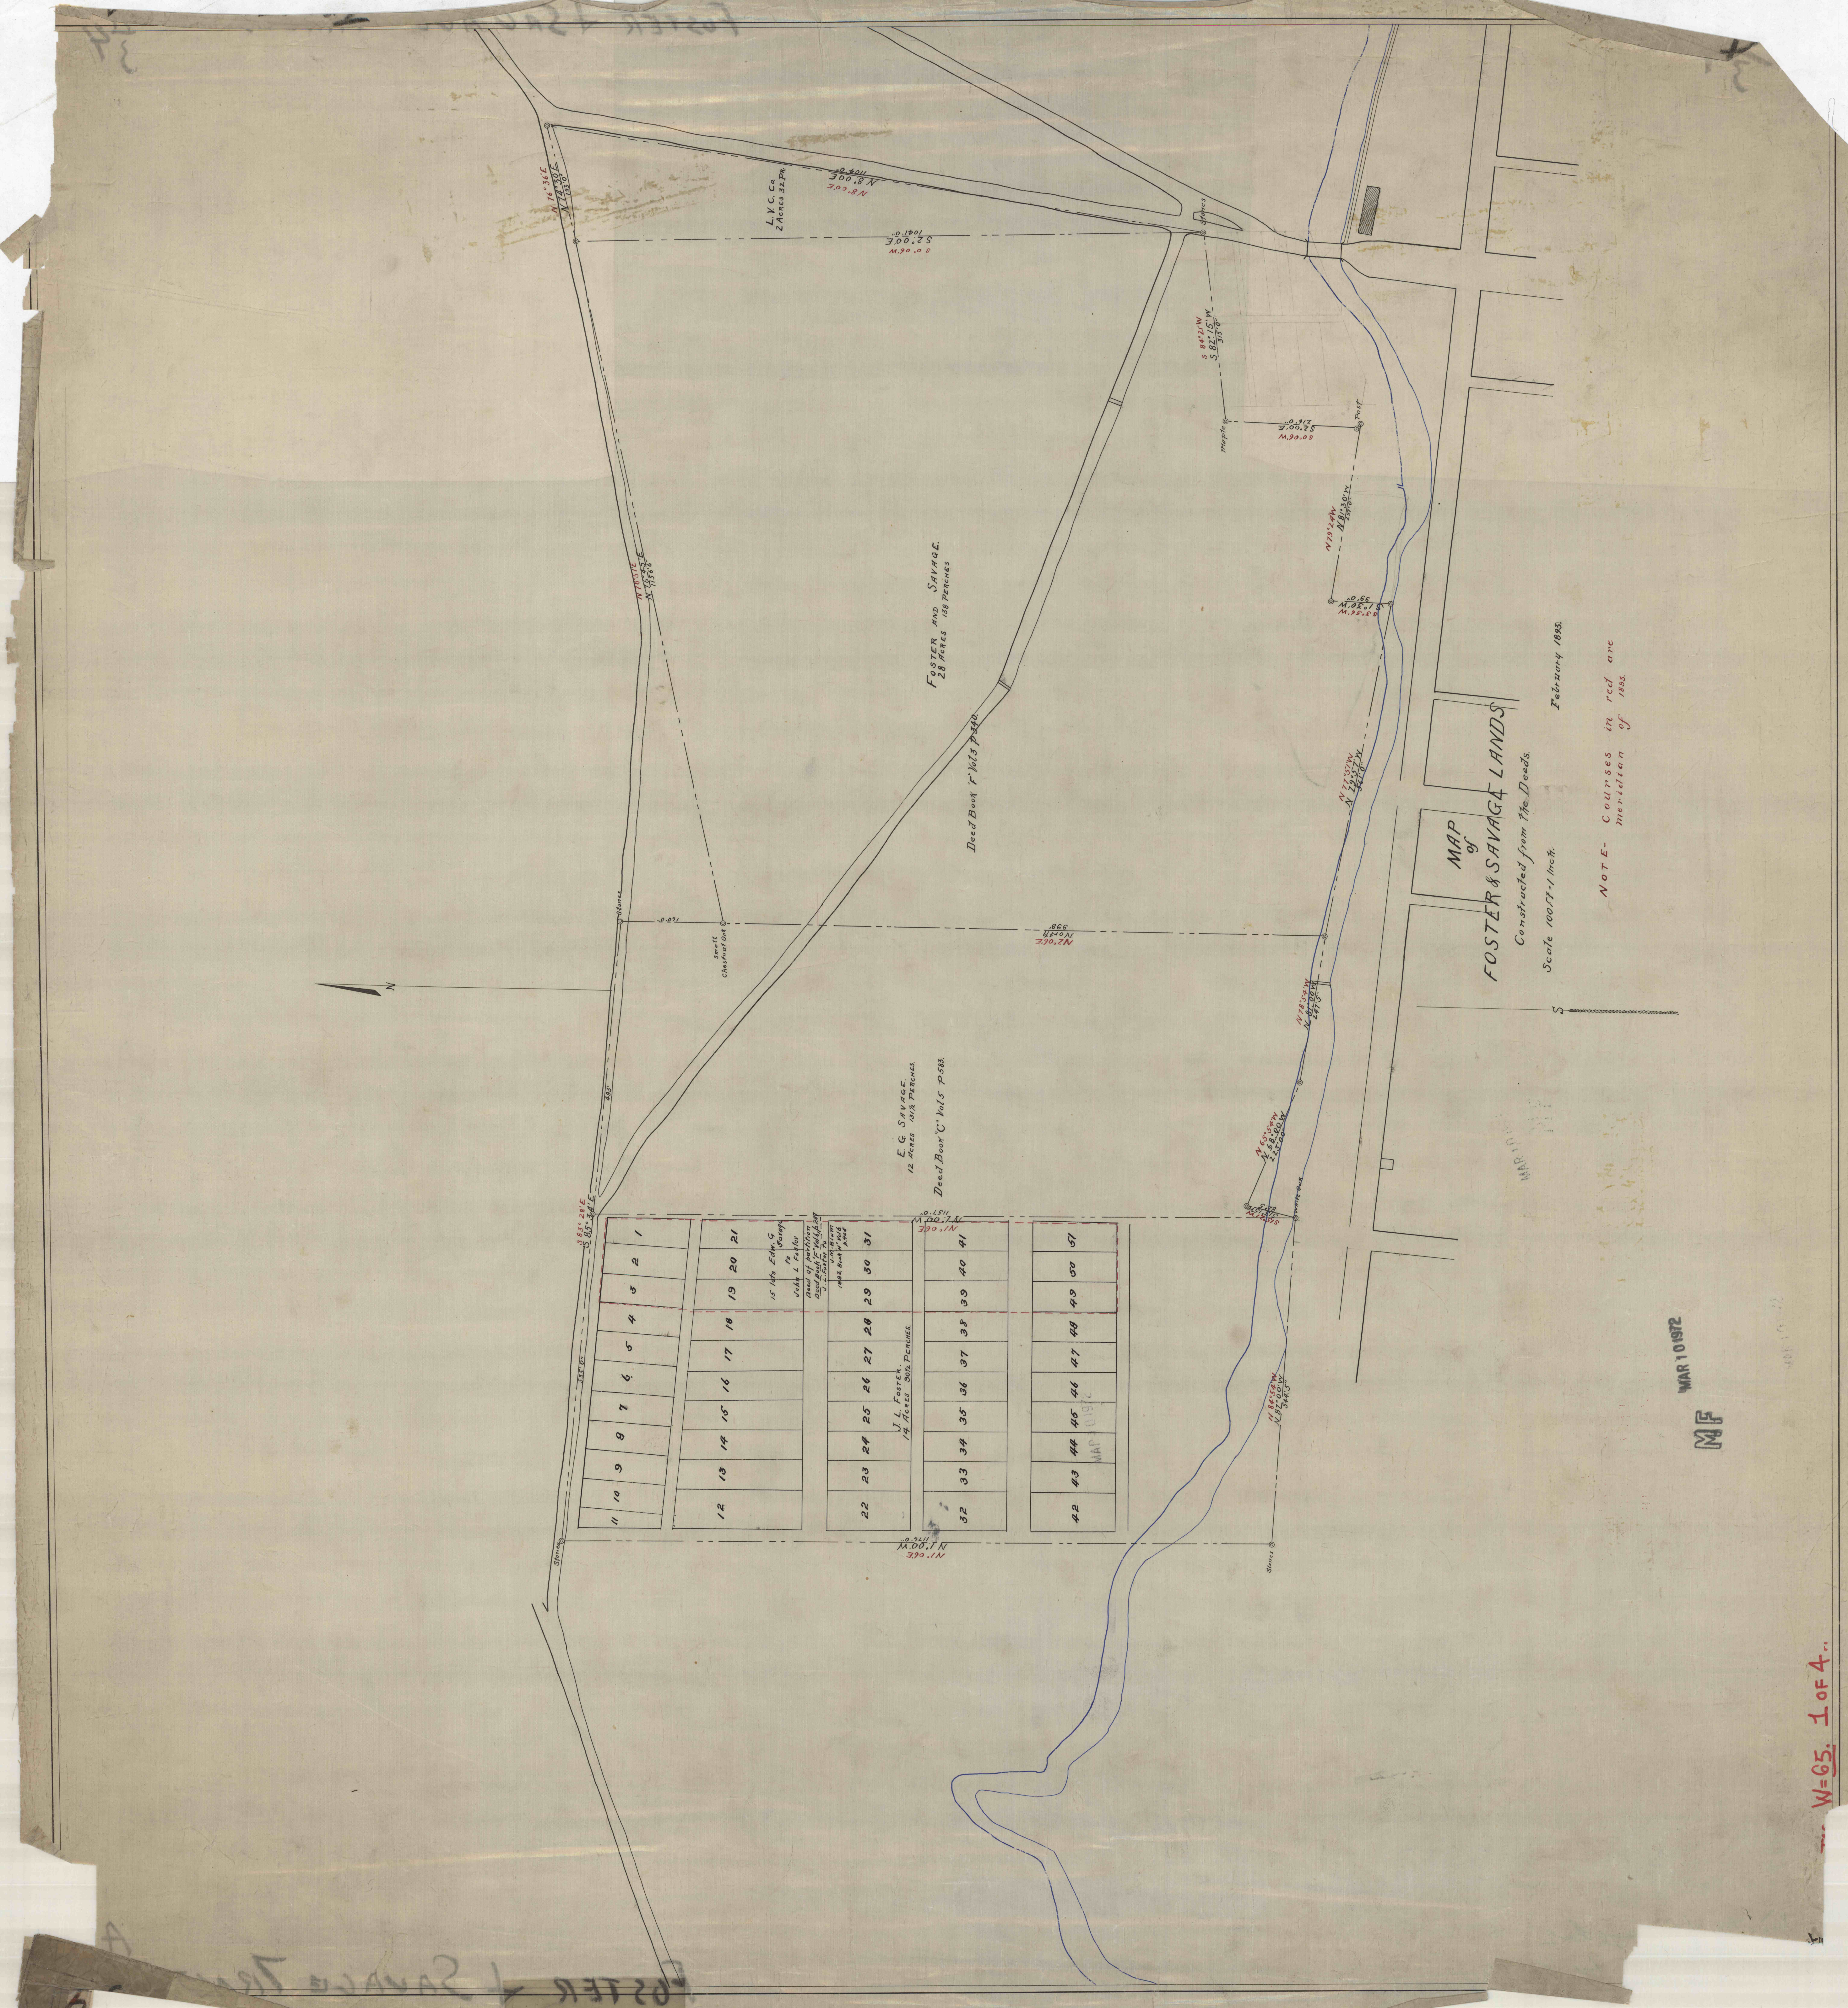

MF
