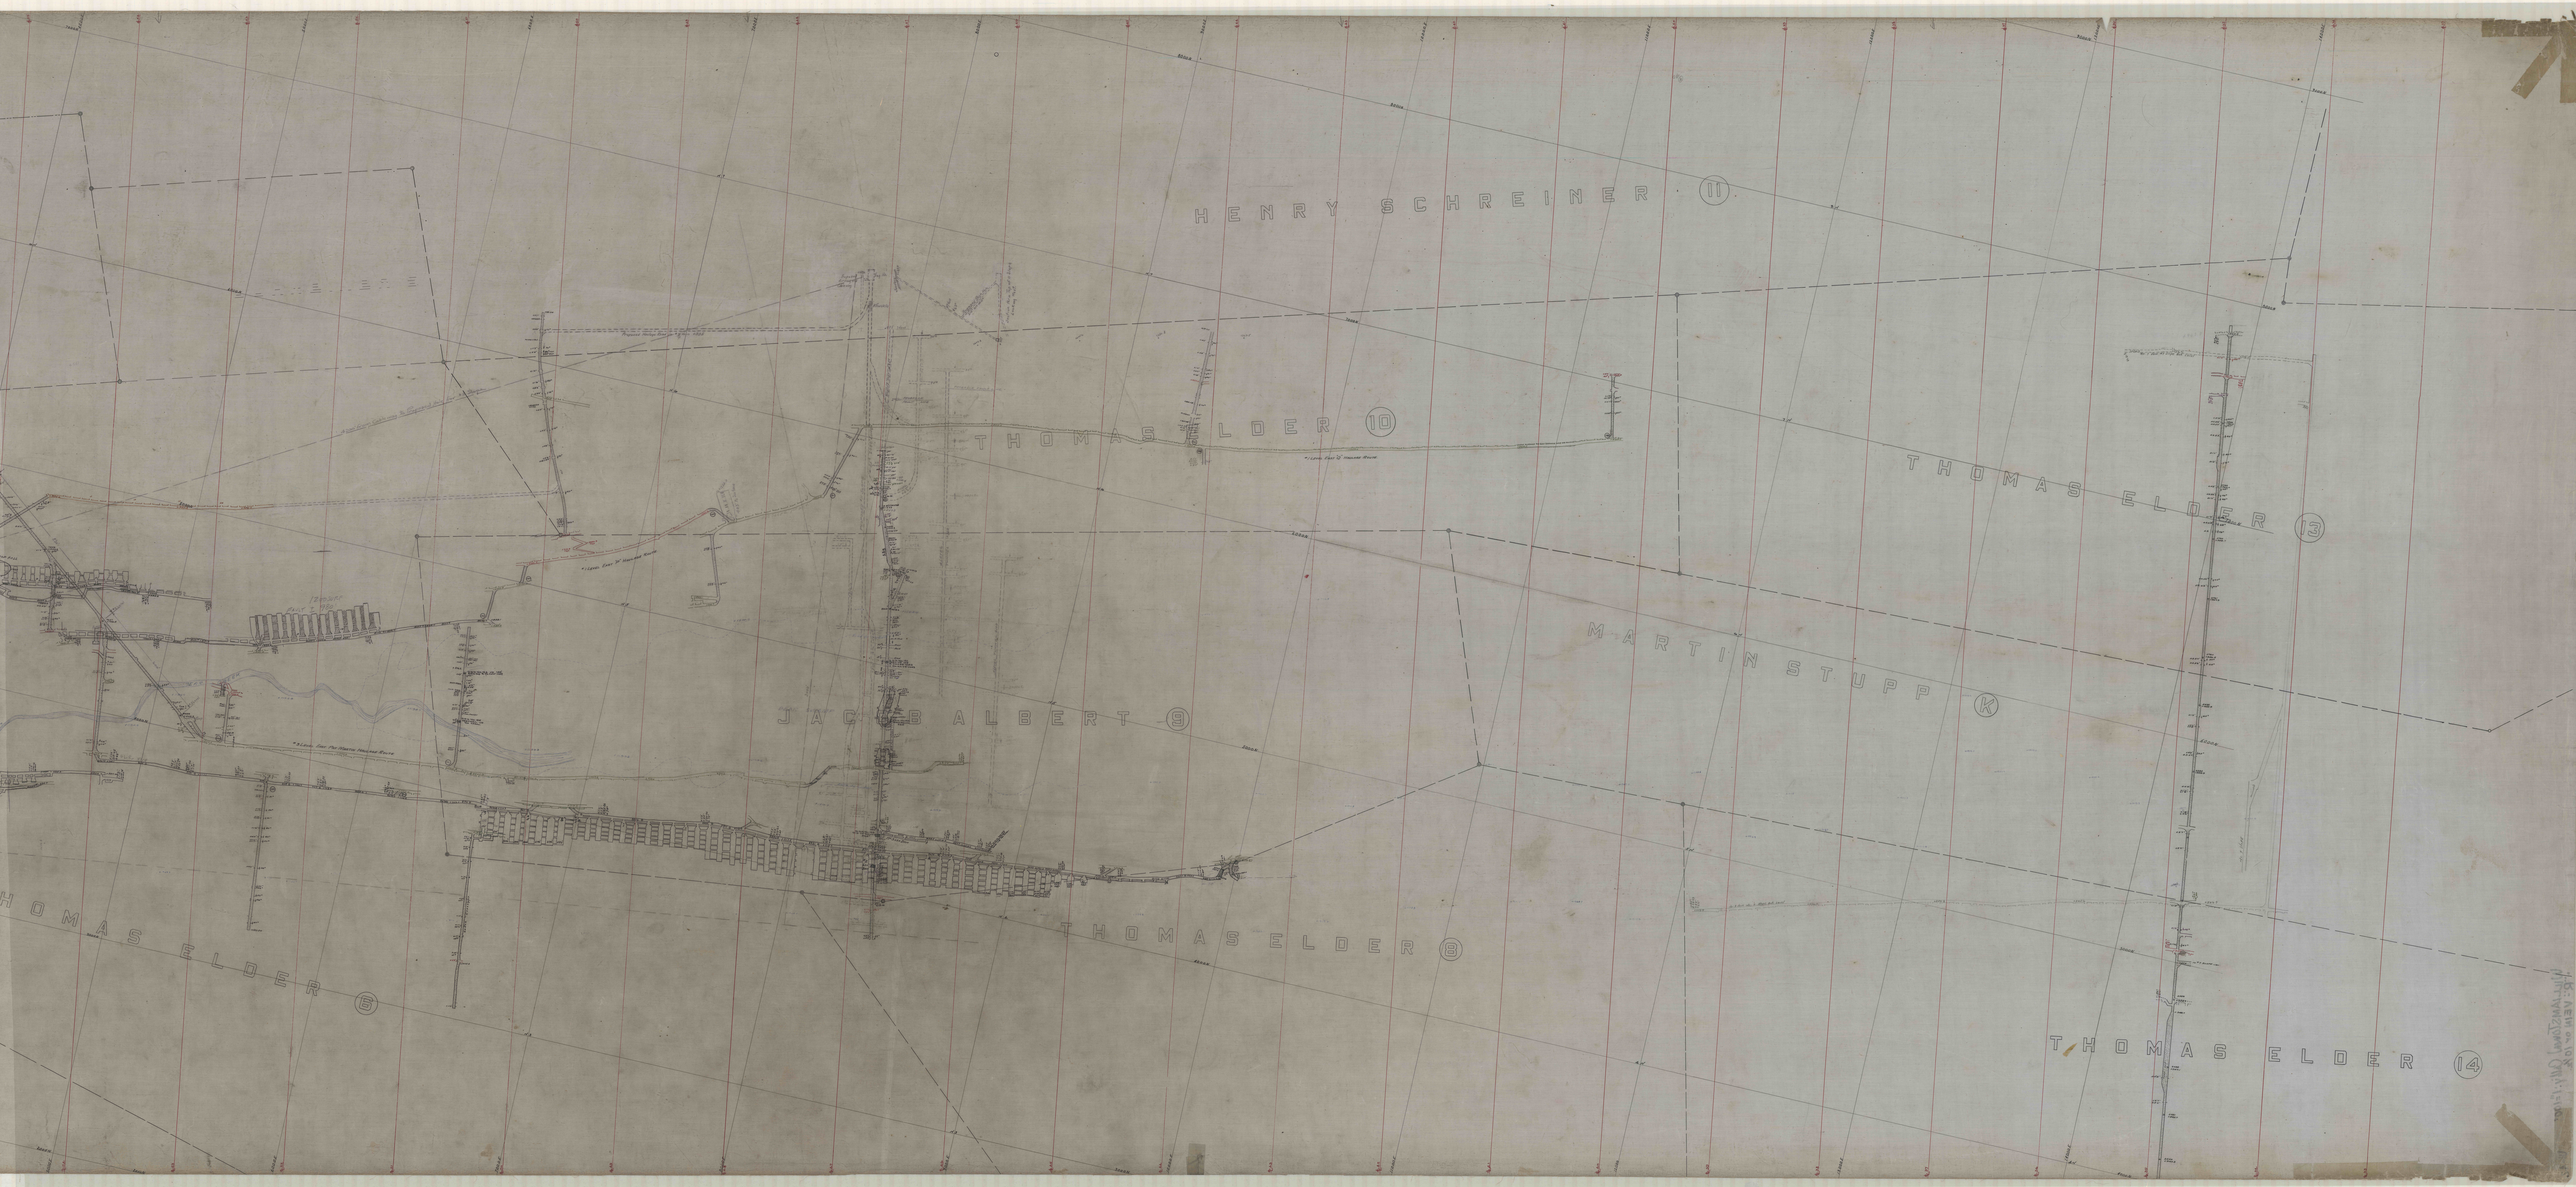

HENRY SCHREINER 11
THOMAS ELDER 10
THOMAS ELDER 13
MARTIN STUPP K
JACOB ALBERT 9
THOMAS ELDER 8
THOMAS ELDER 6
THOMAS ELDER 14