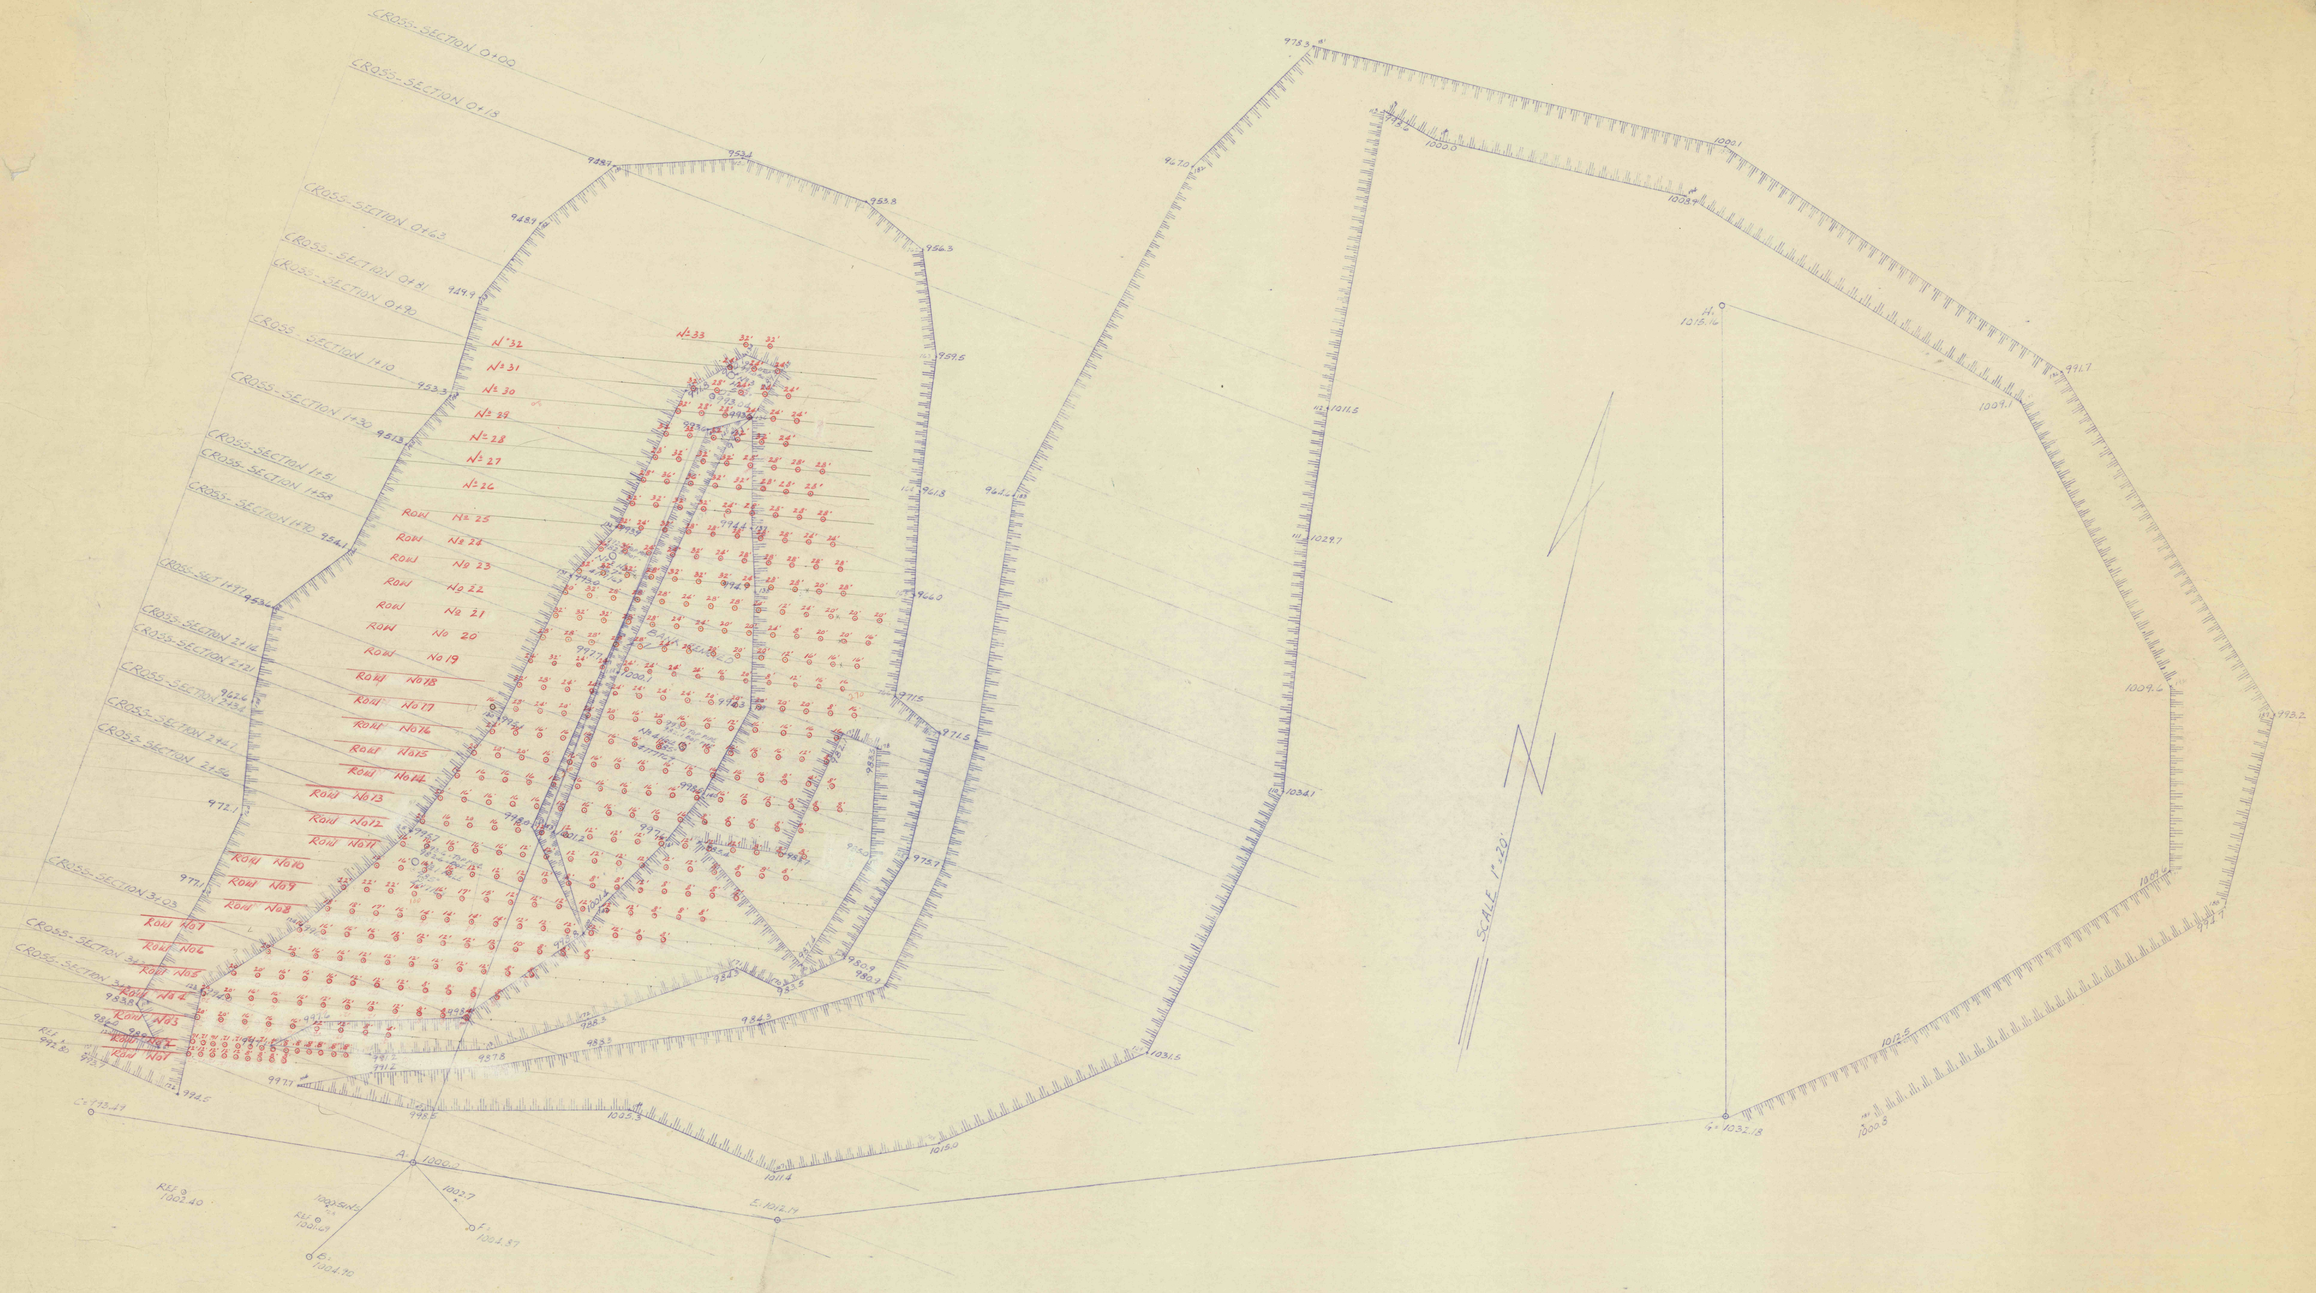

FALES SLOPE BURNING REFUSE BANK SCALE 1" = 20'

NOTE: 236 TOTAL LINEAL WELL TO JUNE 20, 1967

NOTE: 270 HOLES DRILLED TO JUNE 20, 1968

JUN 9 1972 MF