
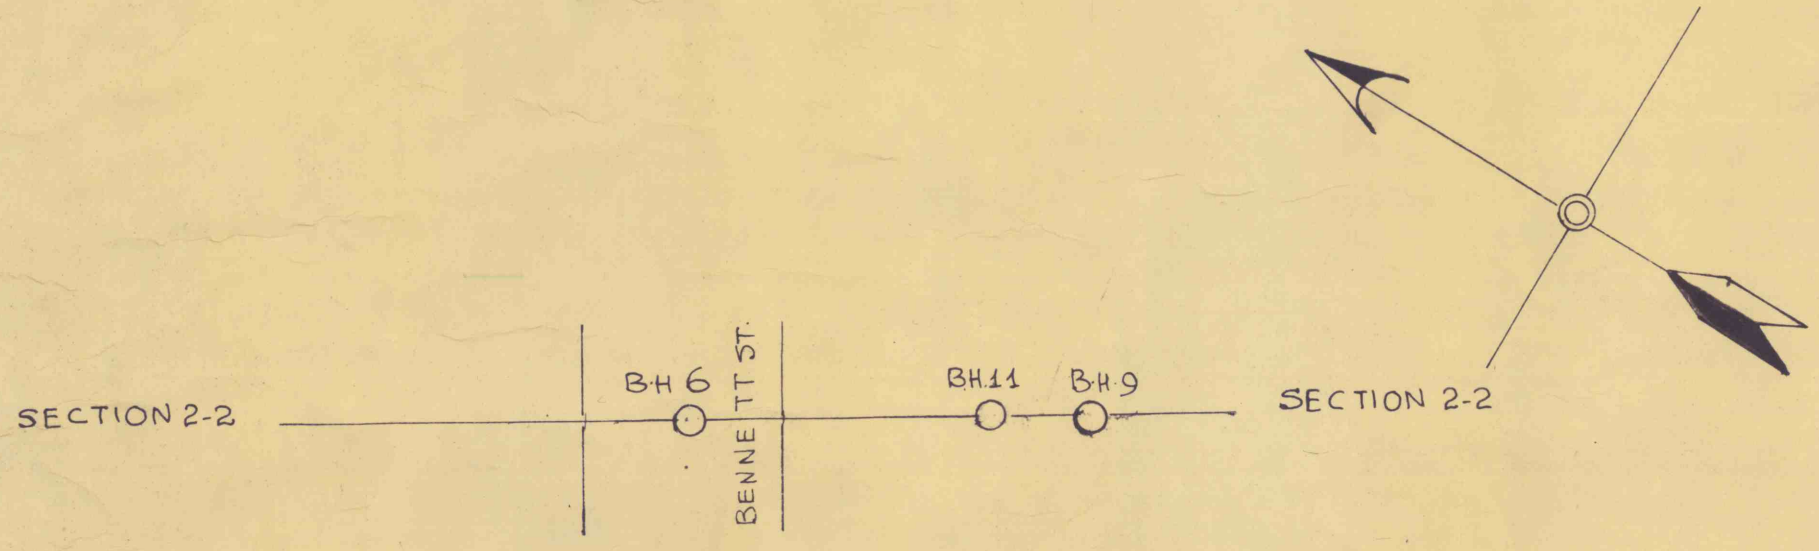
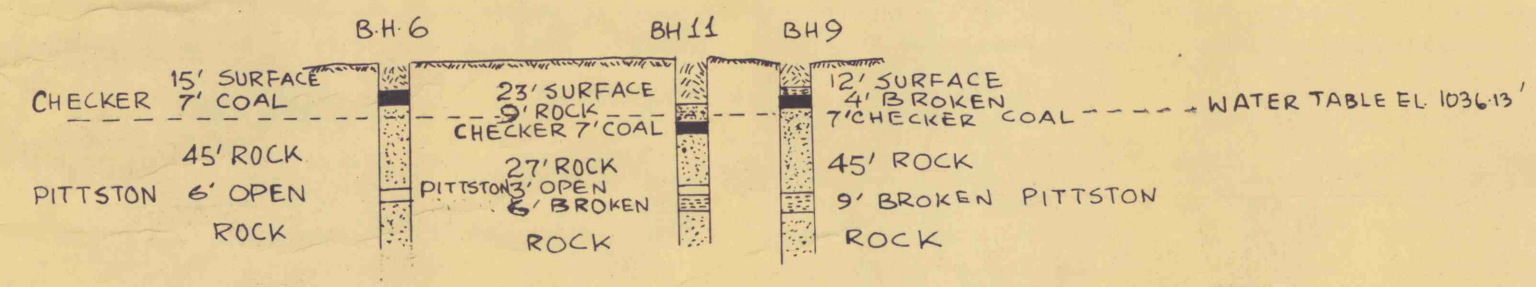
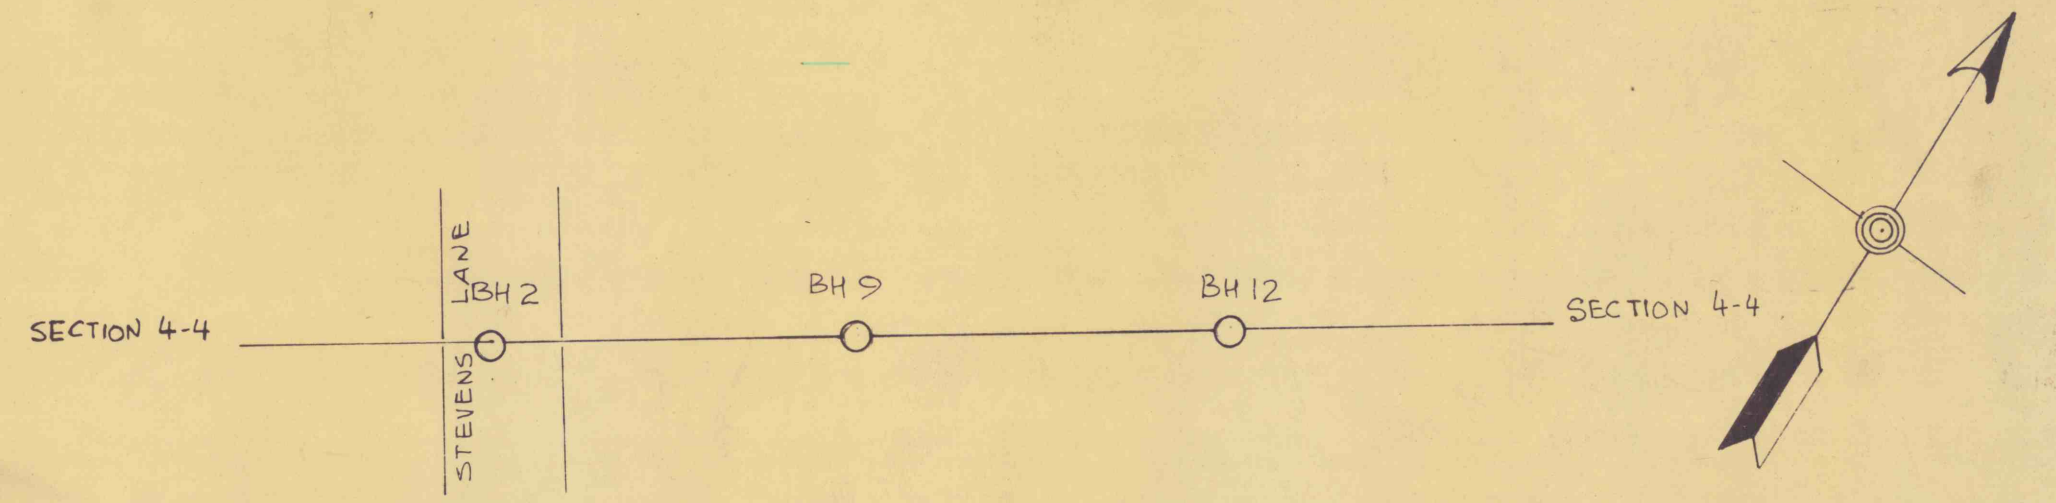
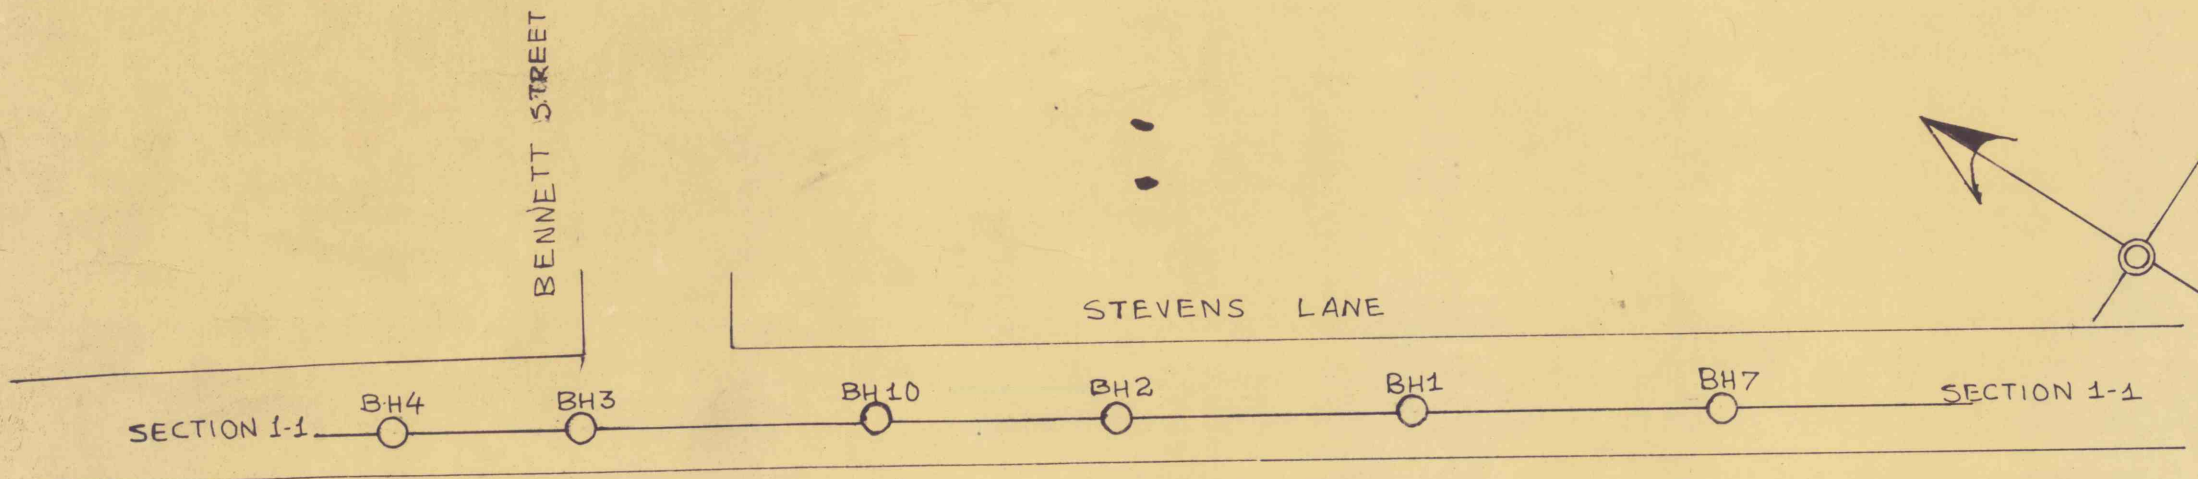
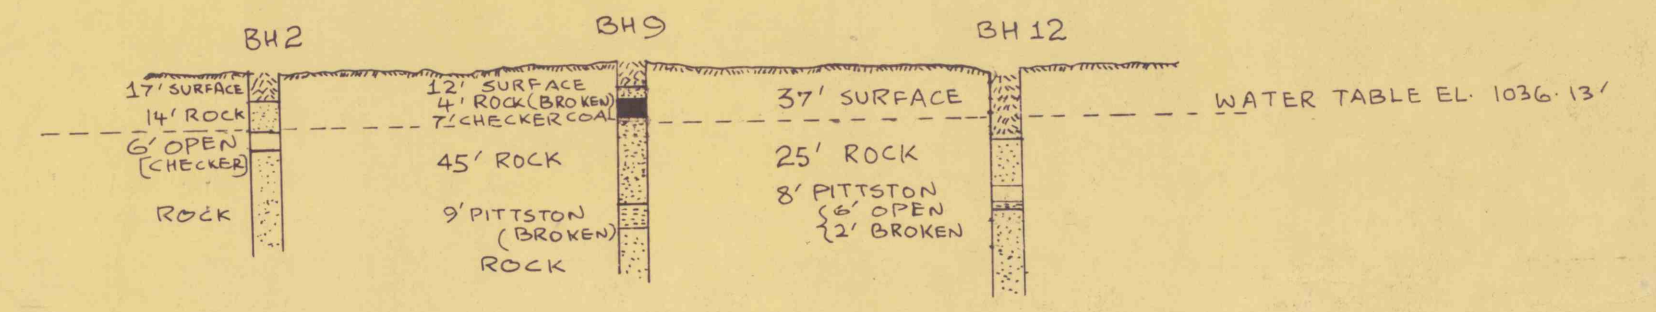
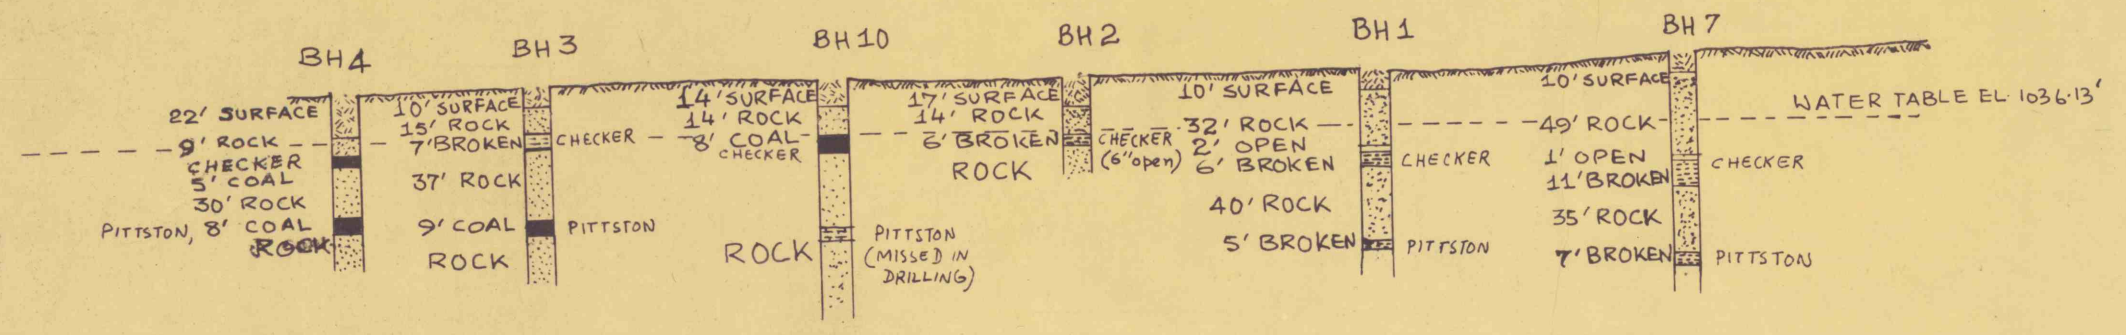


EXPLORATORY DRILLING
PROJECT No. SL 442-A
EXETER BOROUGH, LUZERNE COUNTY, PA.

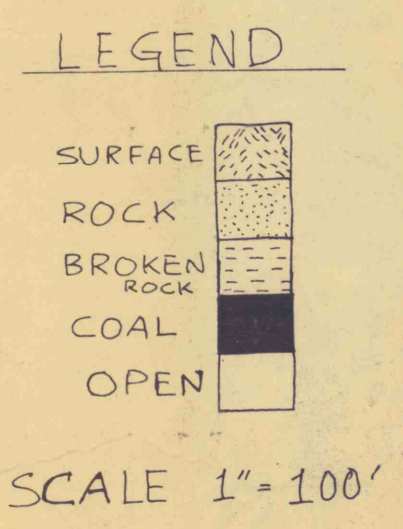

