


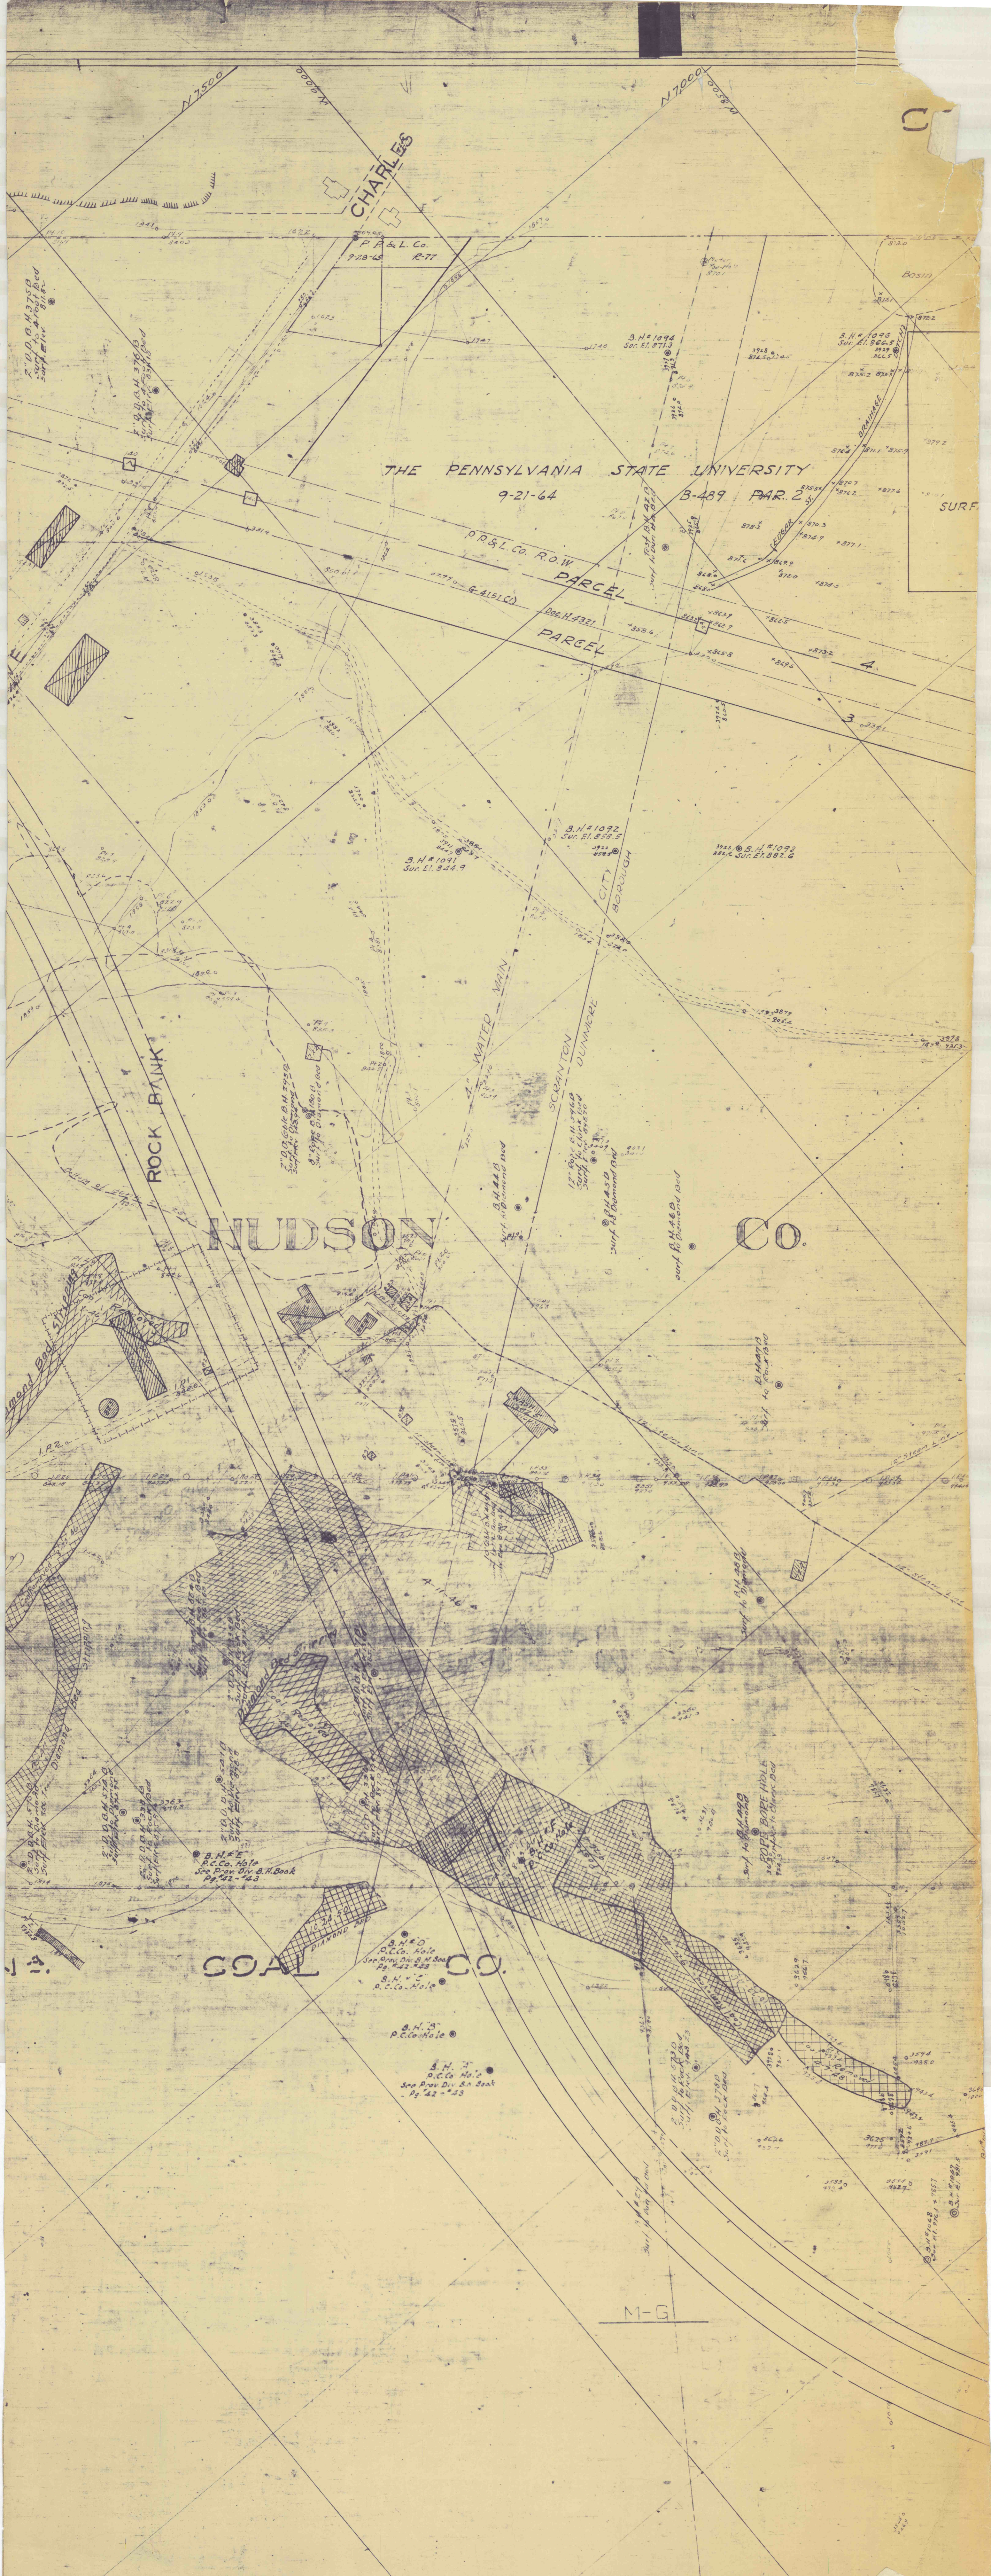

CHARLES

THE PENNSYLVANIA STATE UNIVERSITY
9-21-64

B-489 PAR. 2

P.R. & L. CO. R.O.W.

PARCEL

PARCEL

ROCK BANK

HUDSON

CO.

COAL

CO.

M-G

SURFACE CONVEYED CONGREGATIO