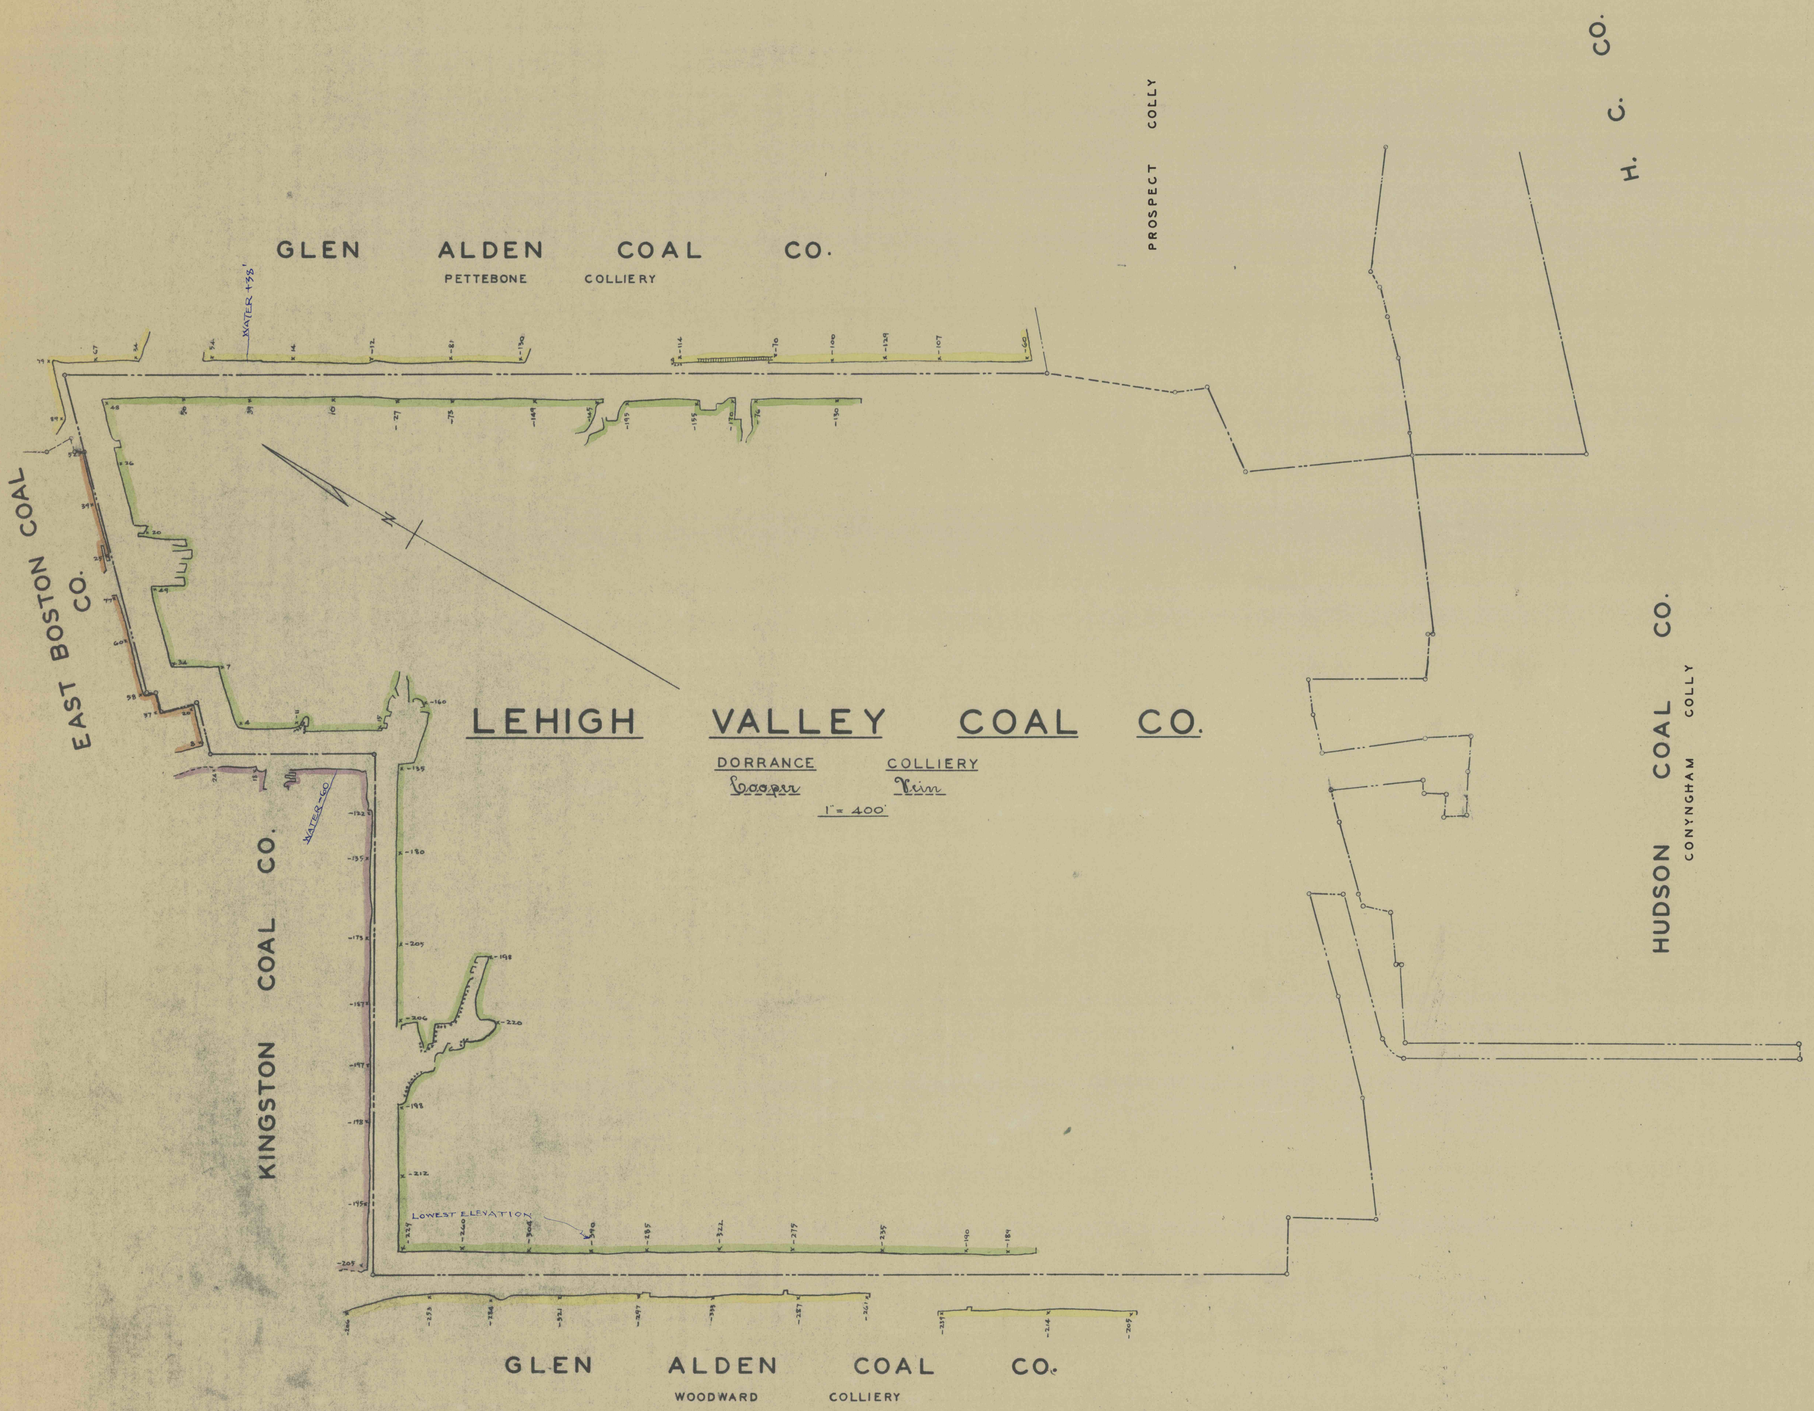
GLEN ALDEN COAL CO.
PETTEBONE COLLIERY
WATER 155'
PROSPECT COLLY
H. C. CO.
EAST BOSTON COAL CO.
LEHIGH VALLEY COAL CO.
DORRANCE COLLIERY
Cooper
Kim
1" = 400'
WATER 150
KINGSTON COAL CO.
HUDSON COAL CO.
CONYNGHAM COLLY
LOWEST ELEVATION
GLEN ALDEN COAL CO.
WOODWARD COLLIERY