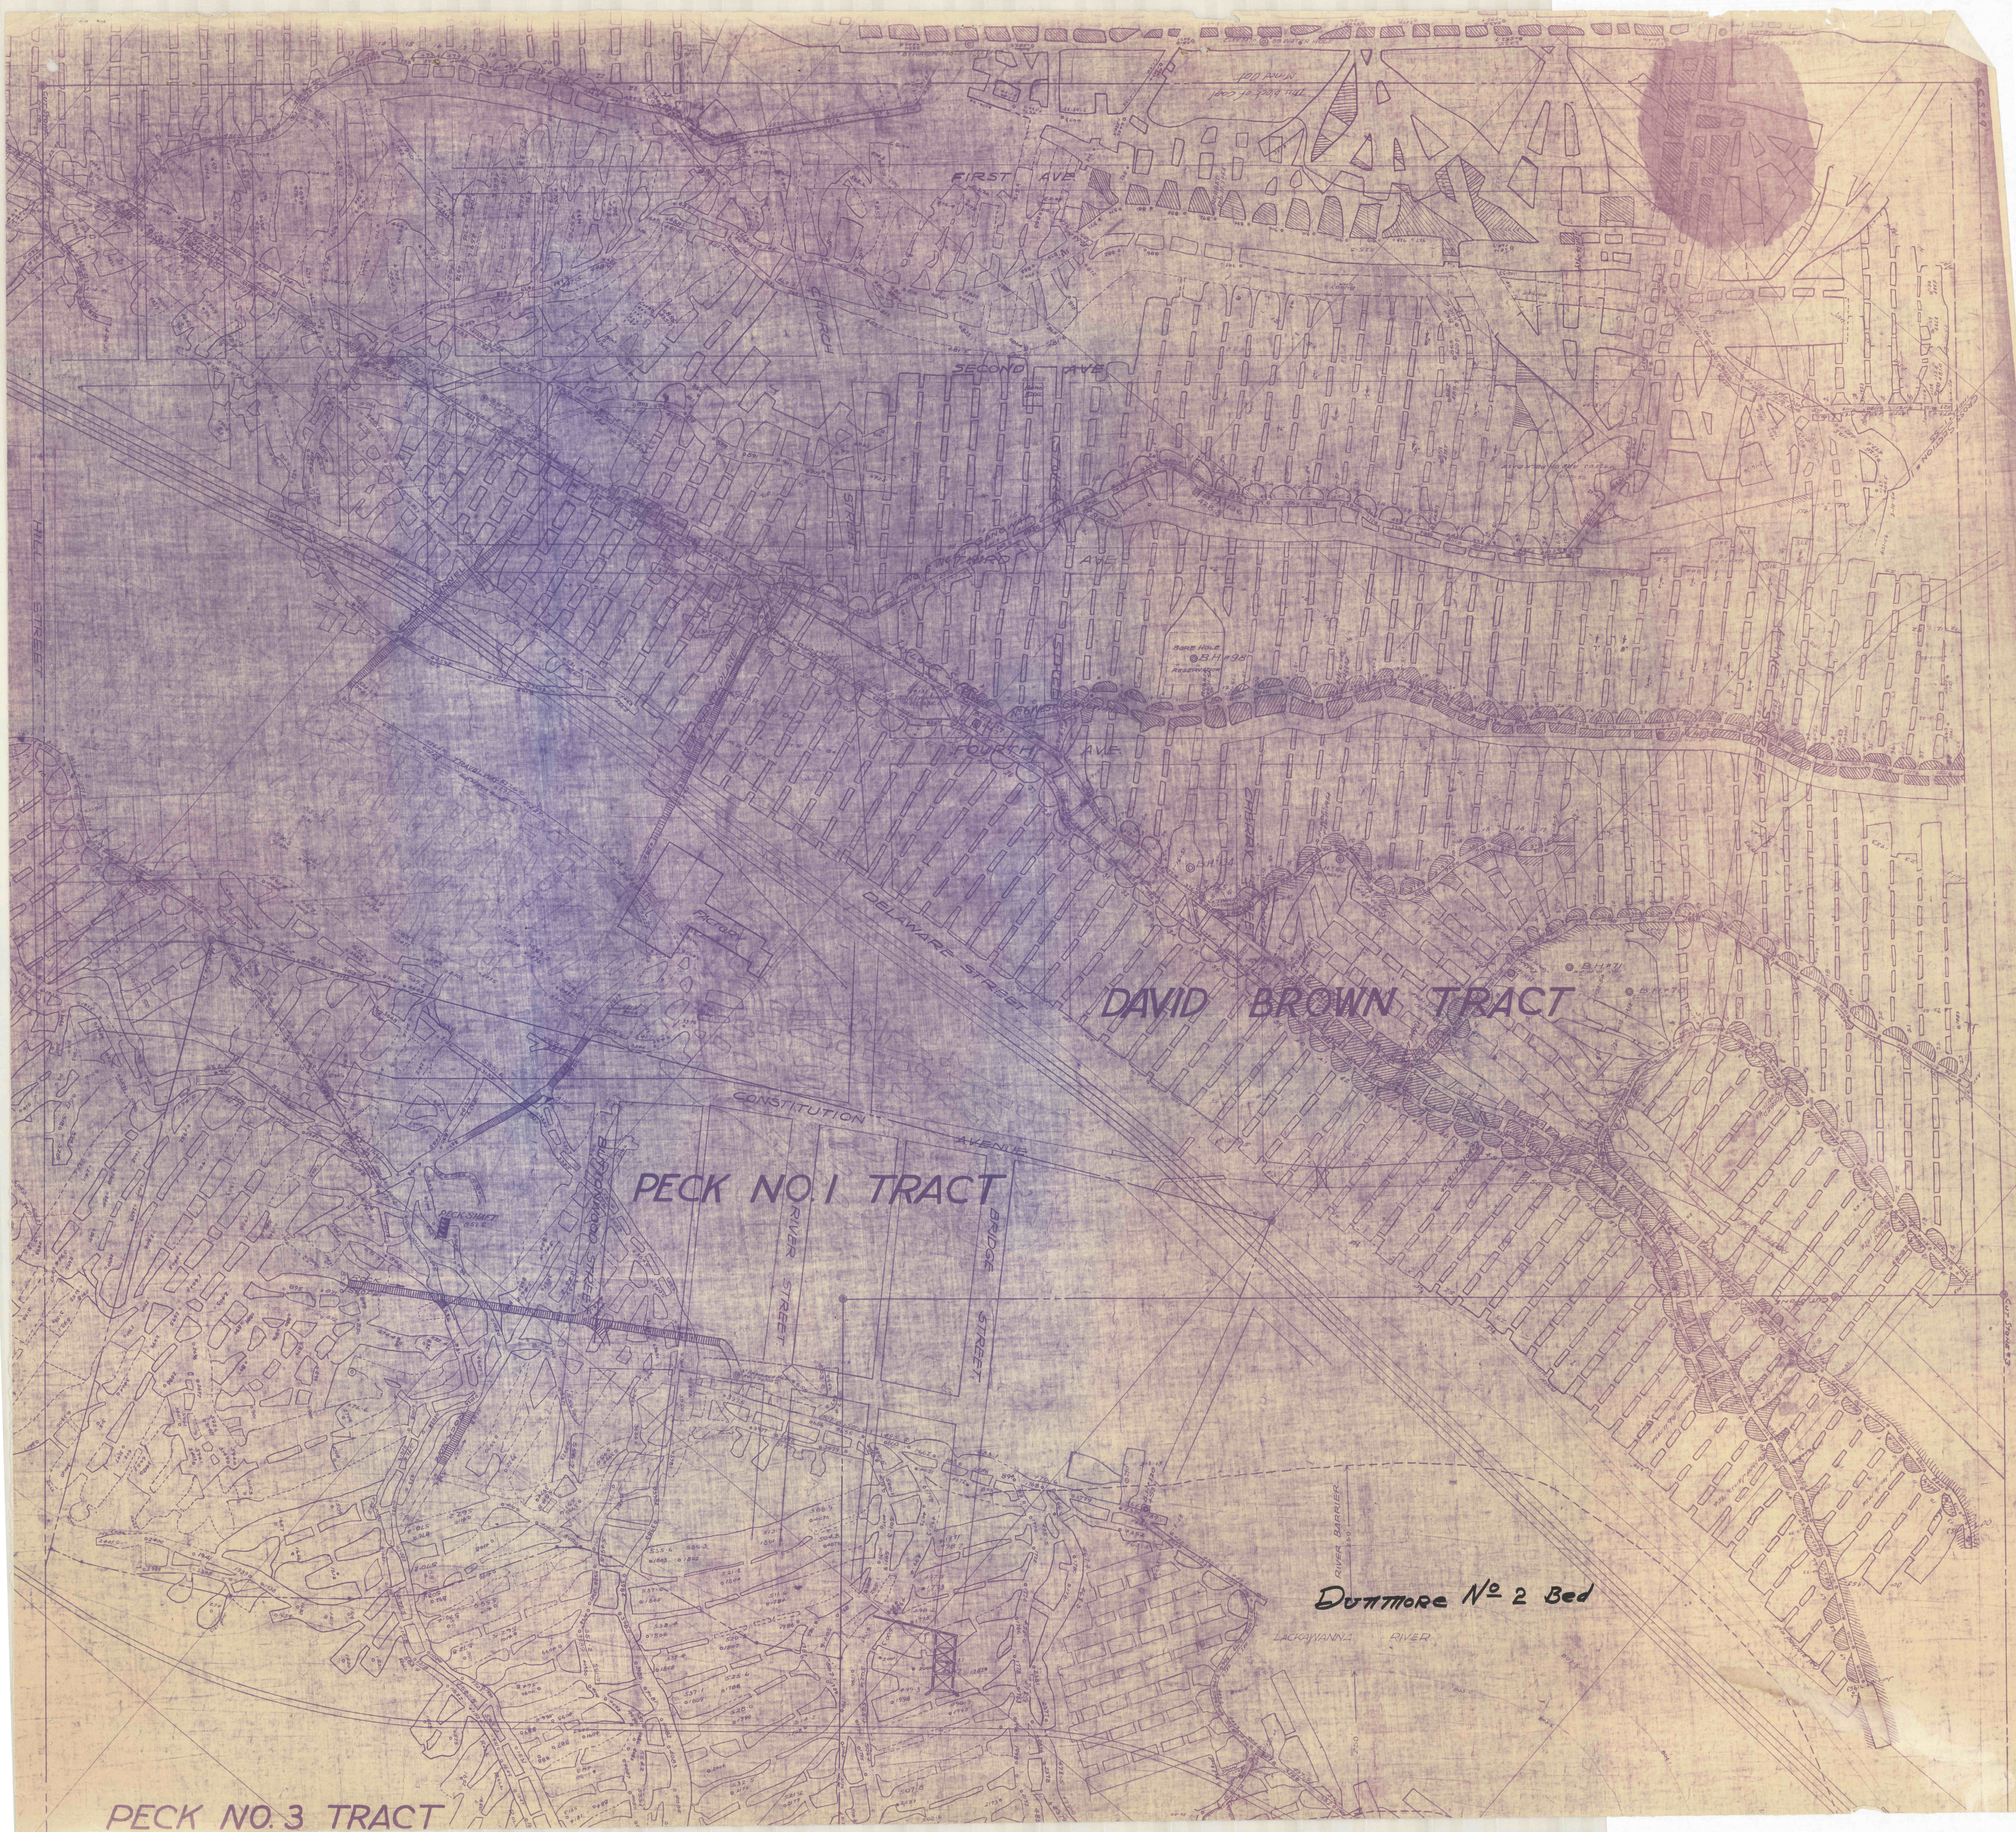
FIRST AVE
SECOND AVE
THIRD AVE
FOURTH AVE
CHURCH
HILL STREET
DELAWARE STREET
CONSTITUTION AVENUE
DAVID BROWN TRACT
PECK NO.1 TRACT
PECK NO.3 TRACT
BUTTONWOOD STREET
RIVER STREET
BRIDGE STREET
FACTORY
PECK SHAFT
BORE HOLE
B.H. #98
RESERVATION
B.H. #71
#87 WATER HOLE
ELEV. 347.0
#88 WATER HOLE
This block of coal
Mined Out
ROBBED Feb. 11, 1964
BUGGY CHA.
RIVER BARRIER
LACKAWANNA RIVER
Dunmore No 2 Bed