Grassy

Grassy Lackawanna Col (2)

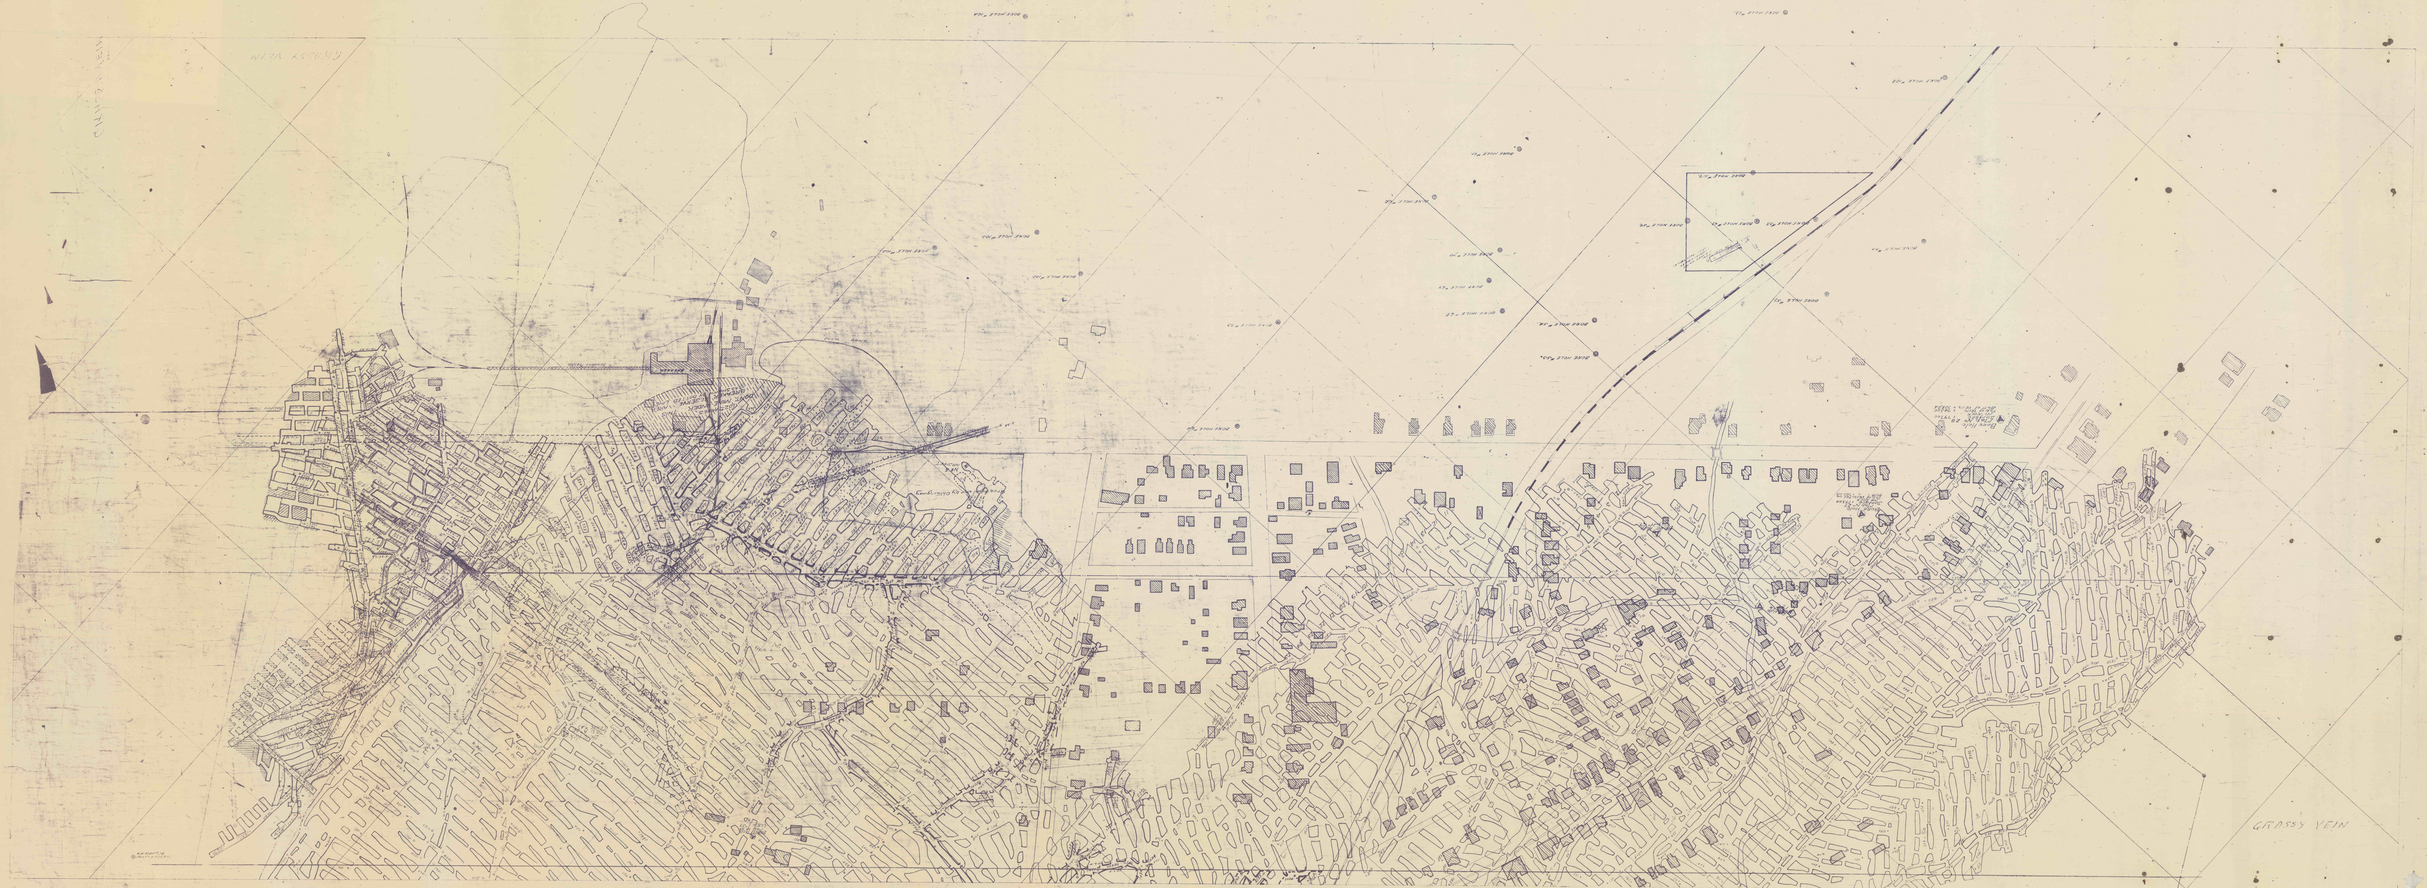

Grassy