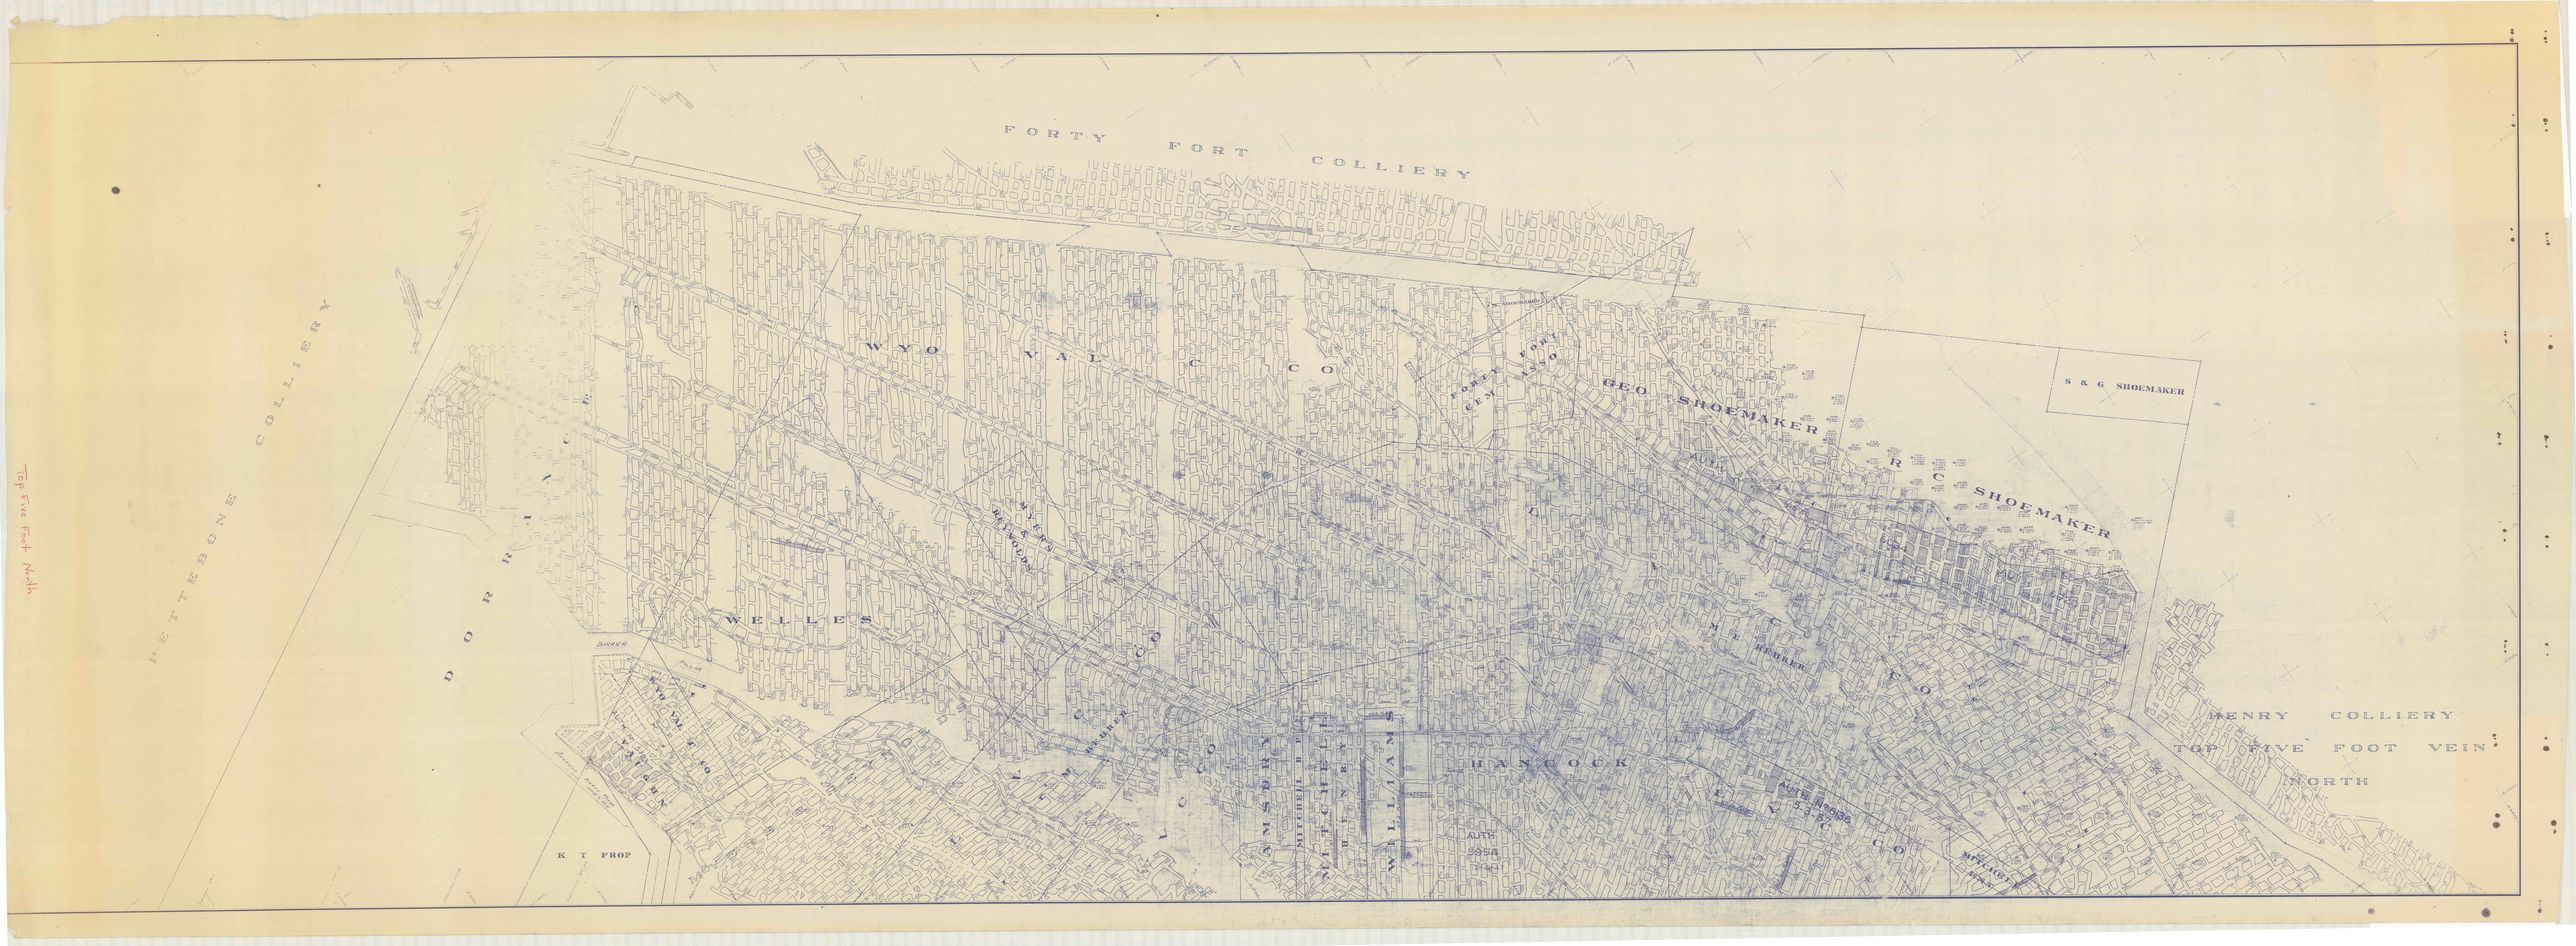


Top Five Foot North