


GLEN ALDEN COAL CO.
SO. WILKES-BARRE COLLIERY
Top Ross Vein

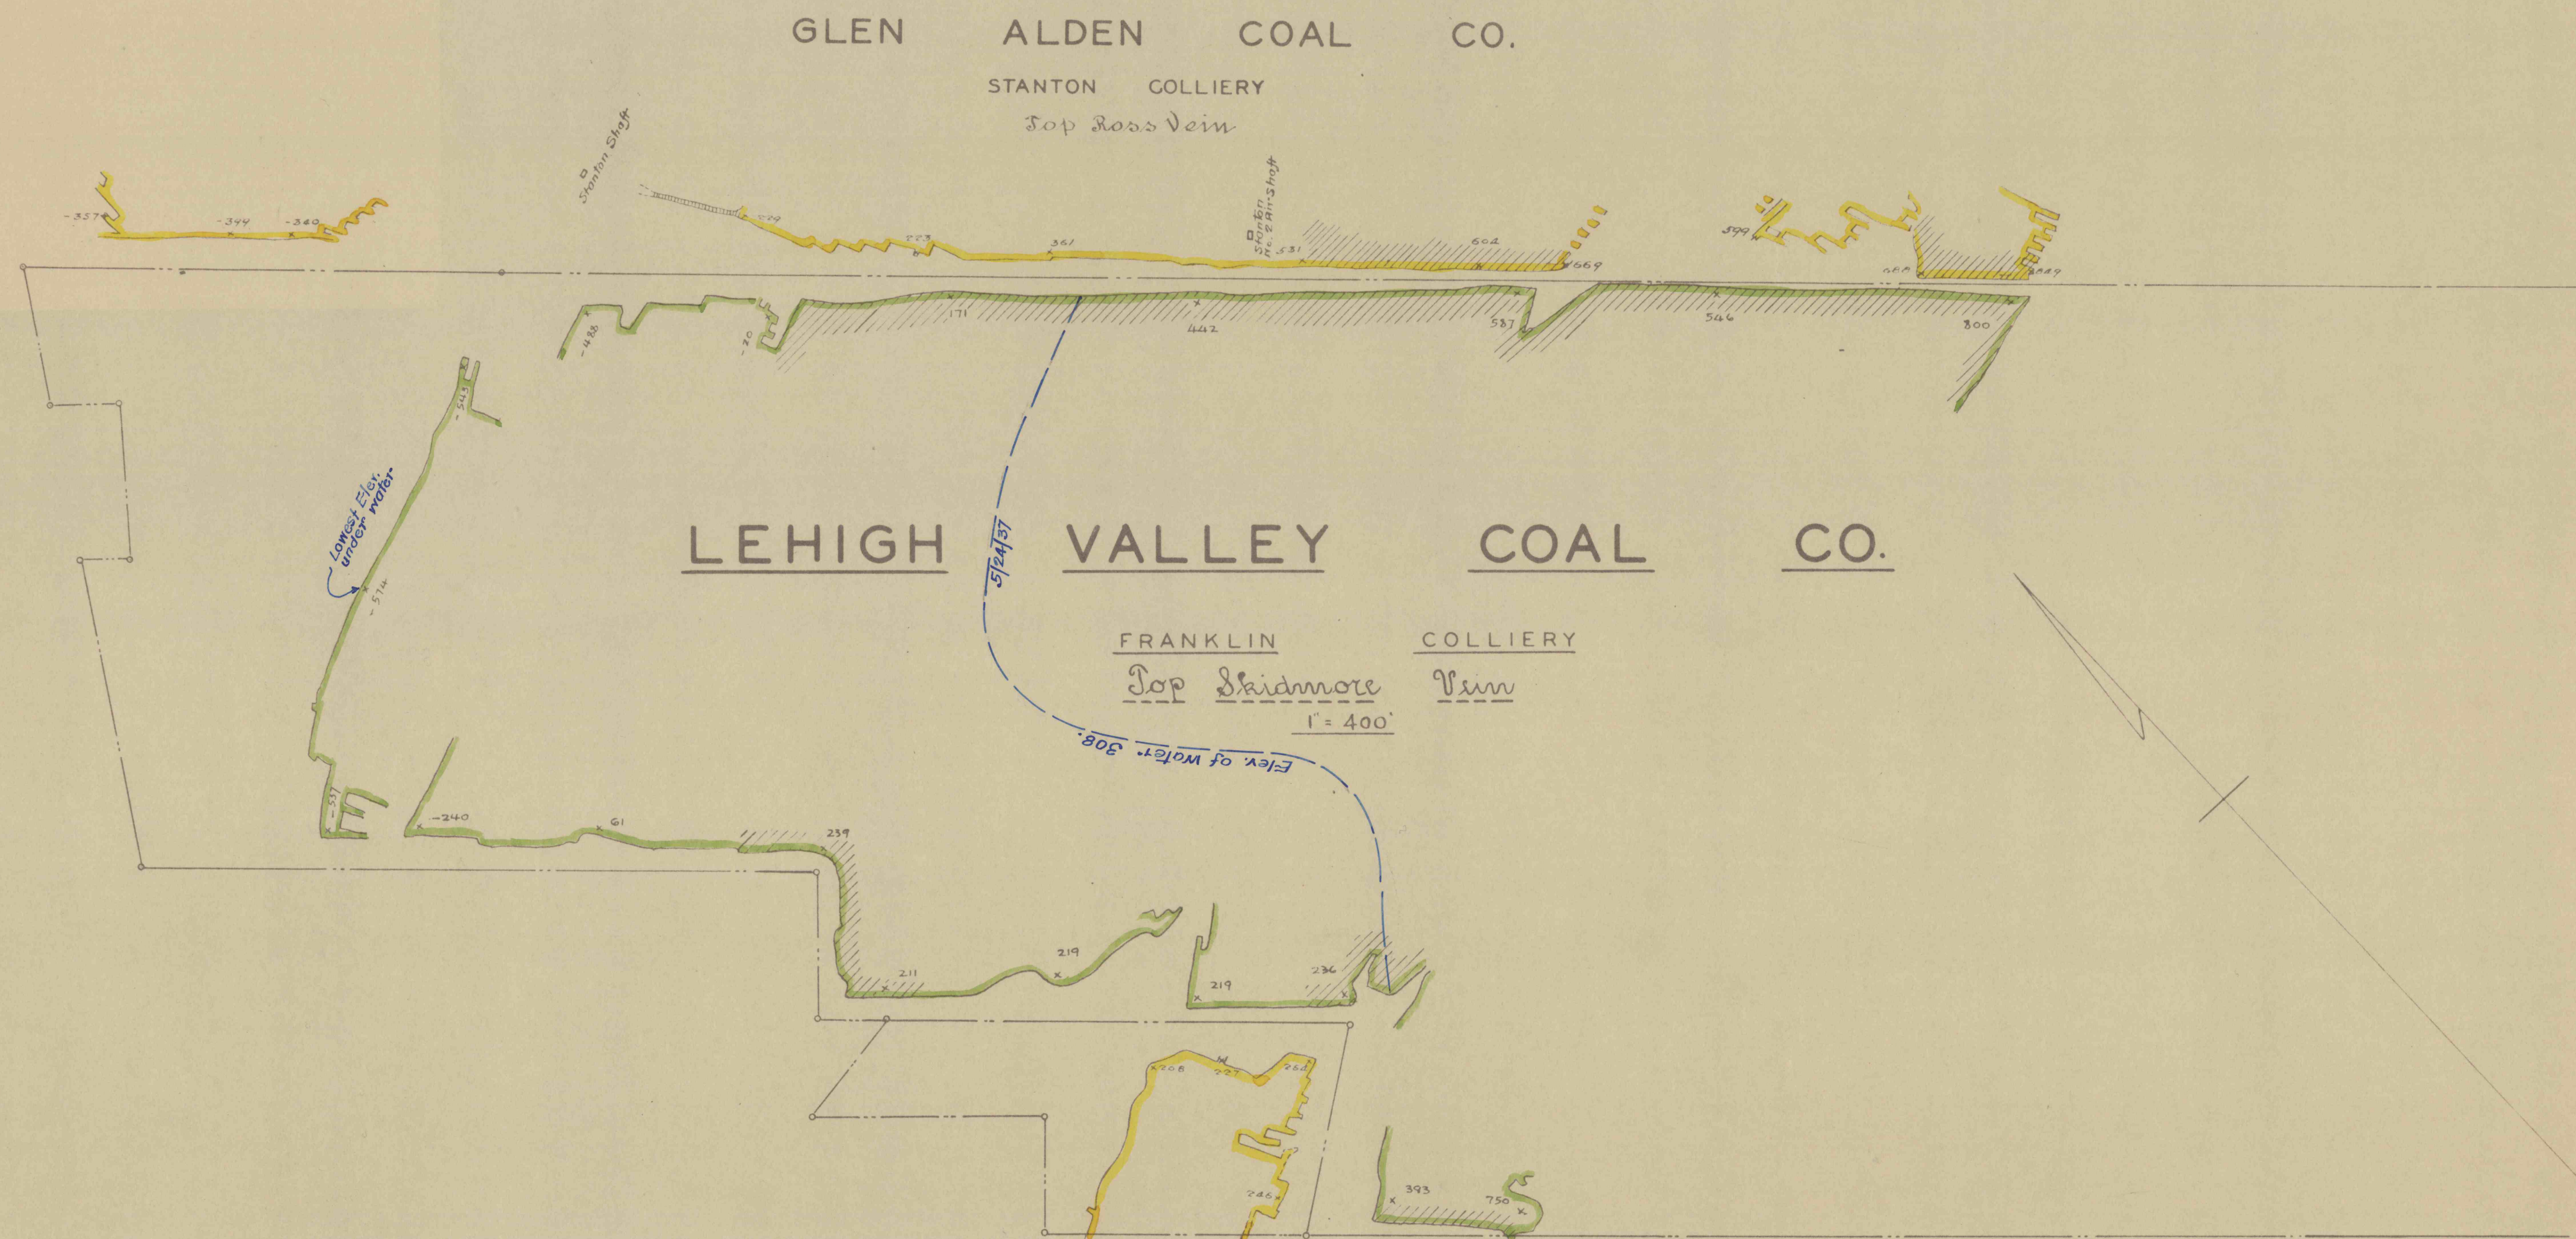

GLEN ALDEN COAL CO.
MAXWELL COLLIERY
Top Ross Vein