


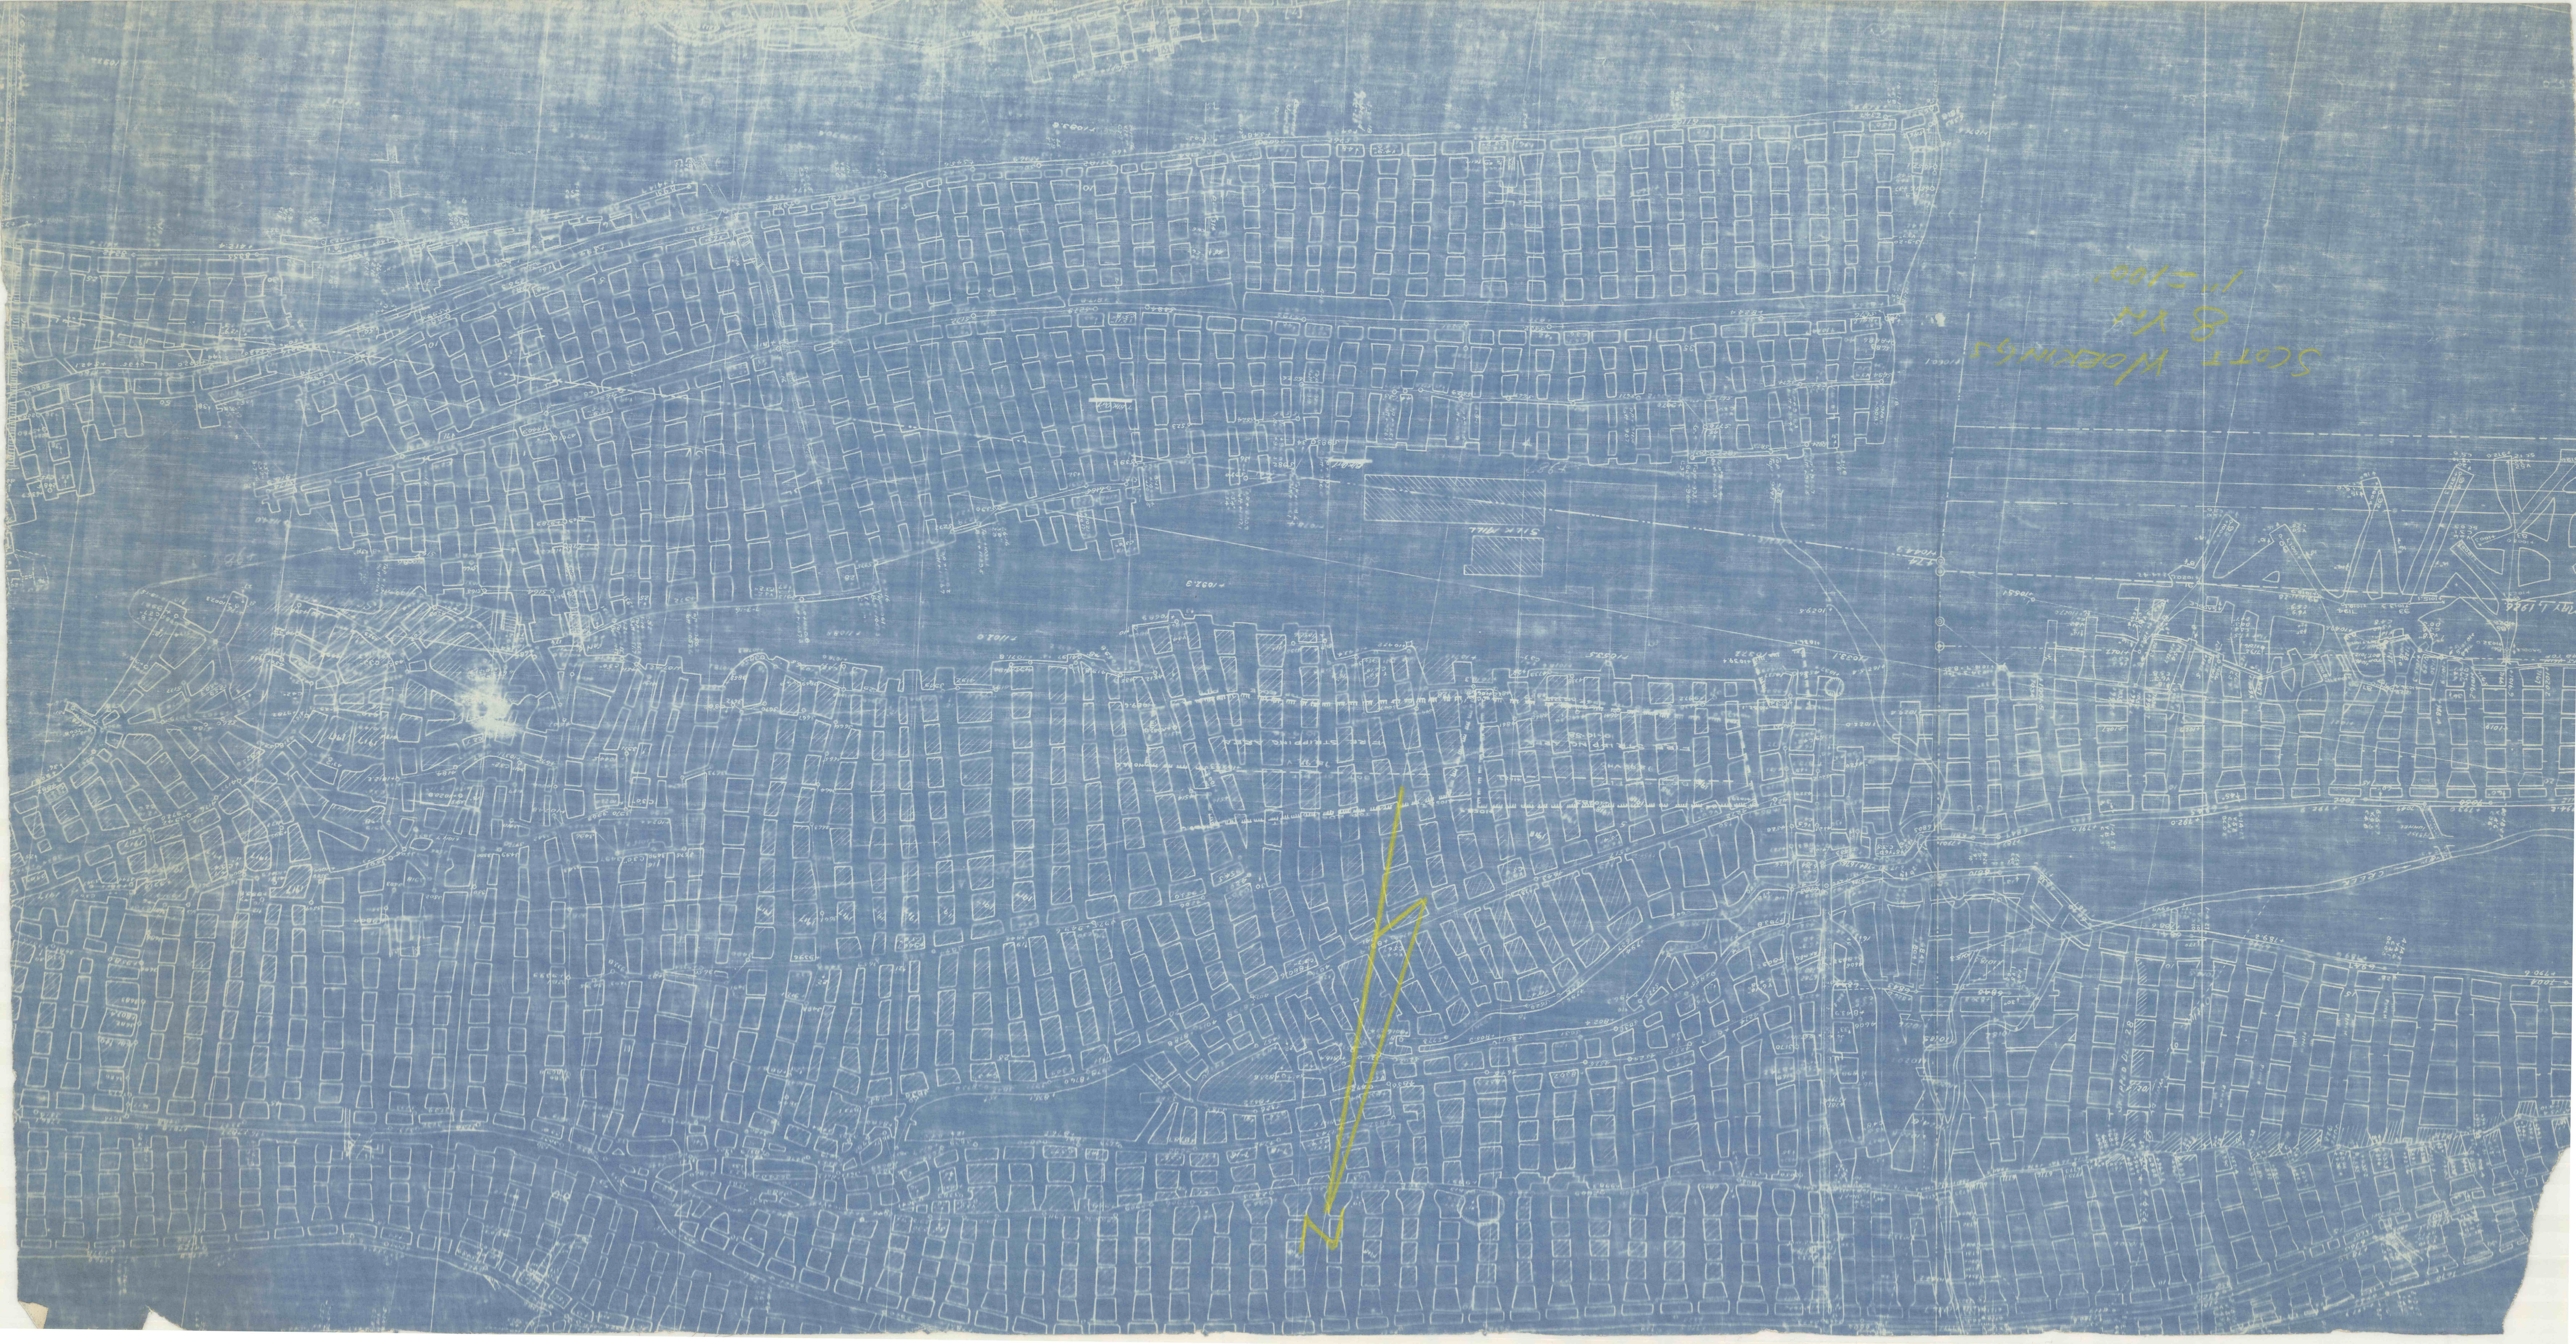

SCOTT WORKINGS
8th
11-2100

11-2100