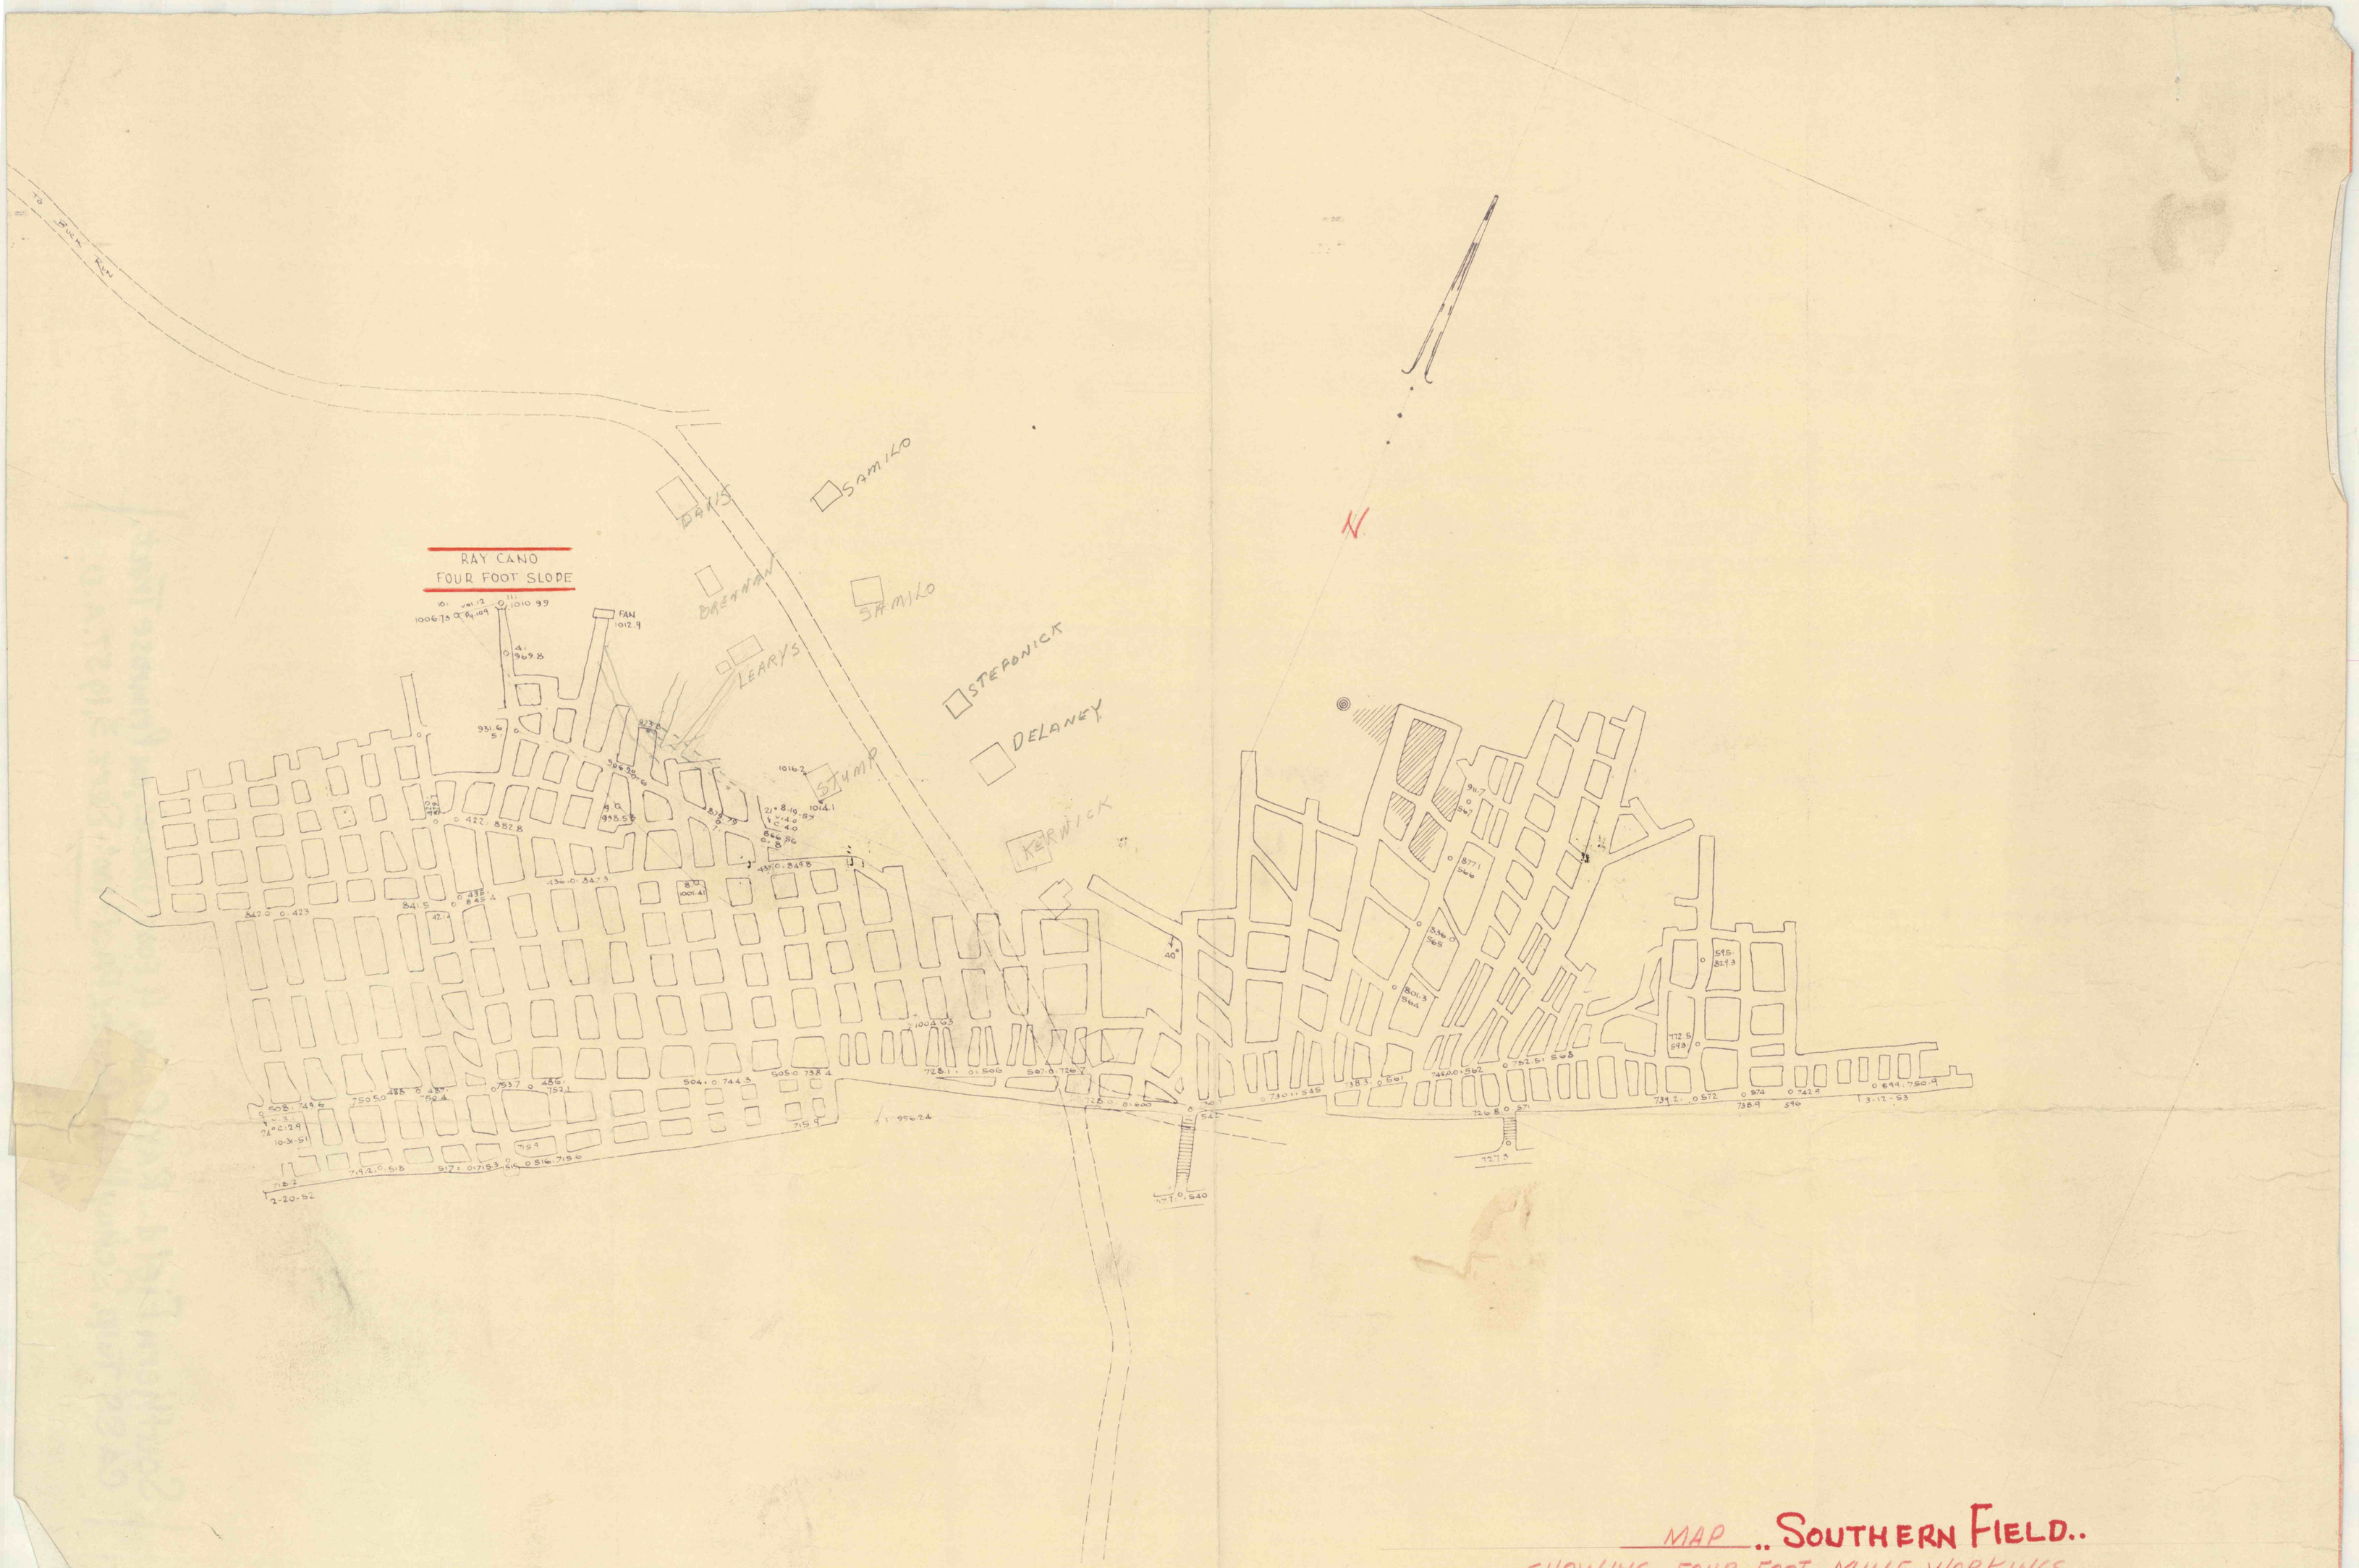

MAP .. SOUTHERN FIELD..
SHOWING FOUR FOOT MINE WORKINGS
OF RAY CANO ON THE PRIMROSE TRACT
IN CASS TOWNSHIP, SCHUYLKILL COUNTY, PA.,
SCALE 1" = 100'
SEPT 3, 1957
J. CURRAN
L. BURMEISTER ENGR'S.