


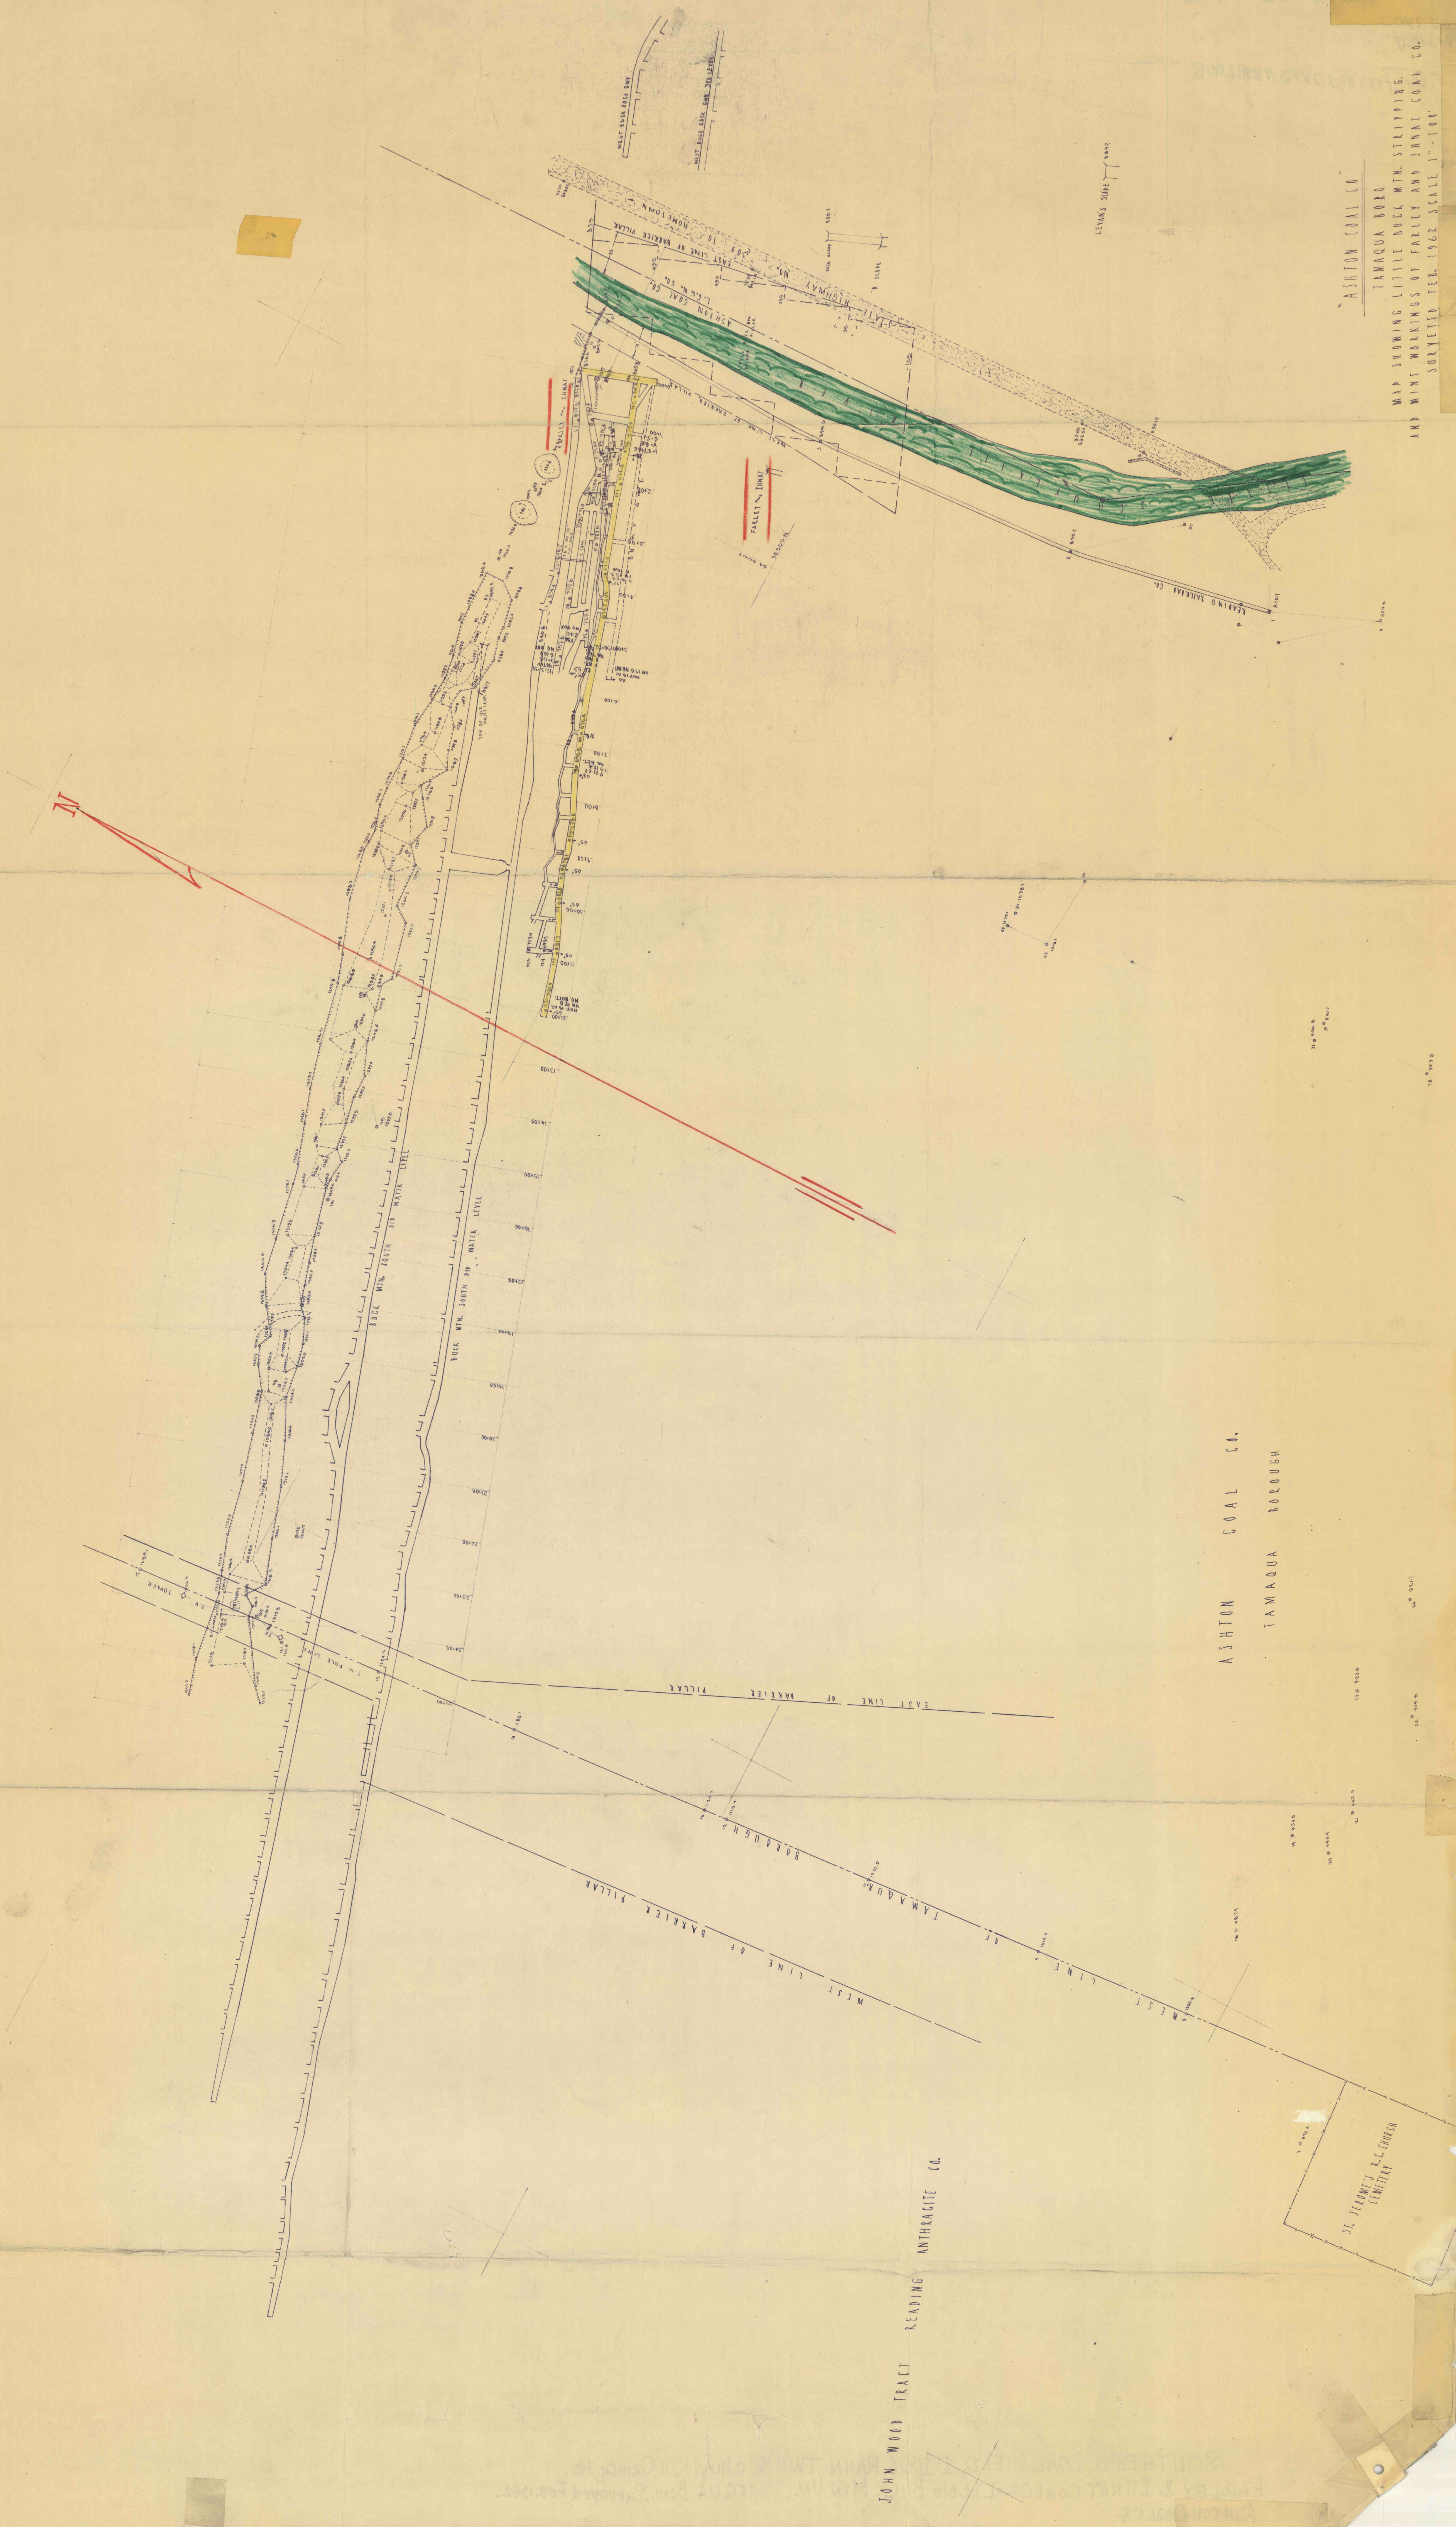

ASHTON COAL CO.
TAMAQUA BOROUGH
SURVEYED FEB. 1962 SCALE 1"=100'

ASHTON COAL CO.
TAMAQUA BOROUGH

JOHN WOOD TRACT
READING ANTHRACITE CO.

TAMAQUA