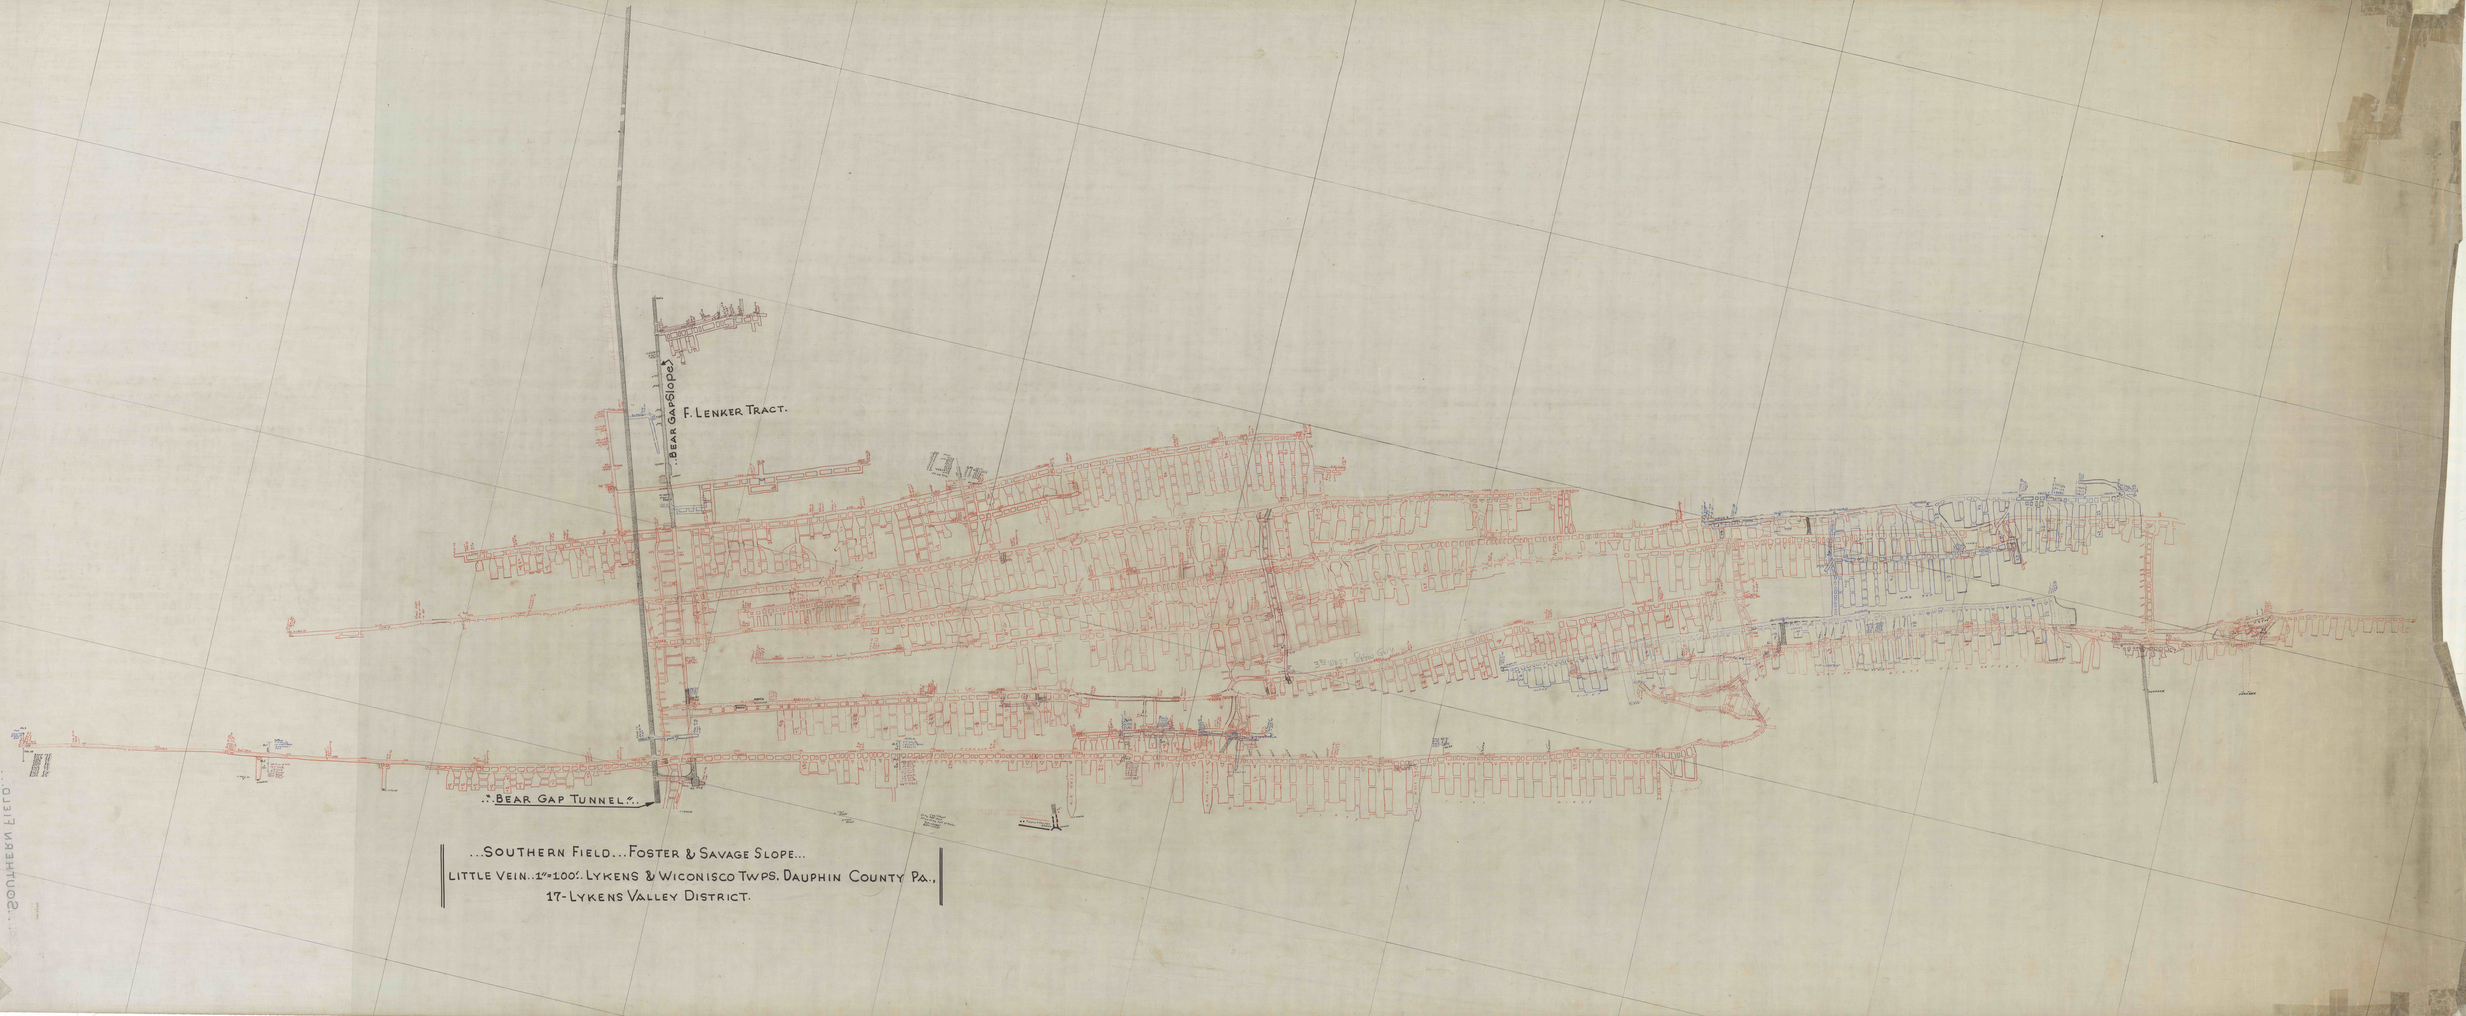

F. LENKER TRACT.
BEAR GAP SLOPE
BEAR GAP TUNNEL
SOUTHERN FIELD...FOSTER & SAVAGE SLOPE...
LITTLE VEIN..1"=100'. LYKENS & WICONISCO TWPS. DAUPHIN COUNTY PA.,
17-LYKENS VALLEY DISTRICT.