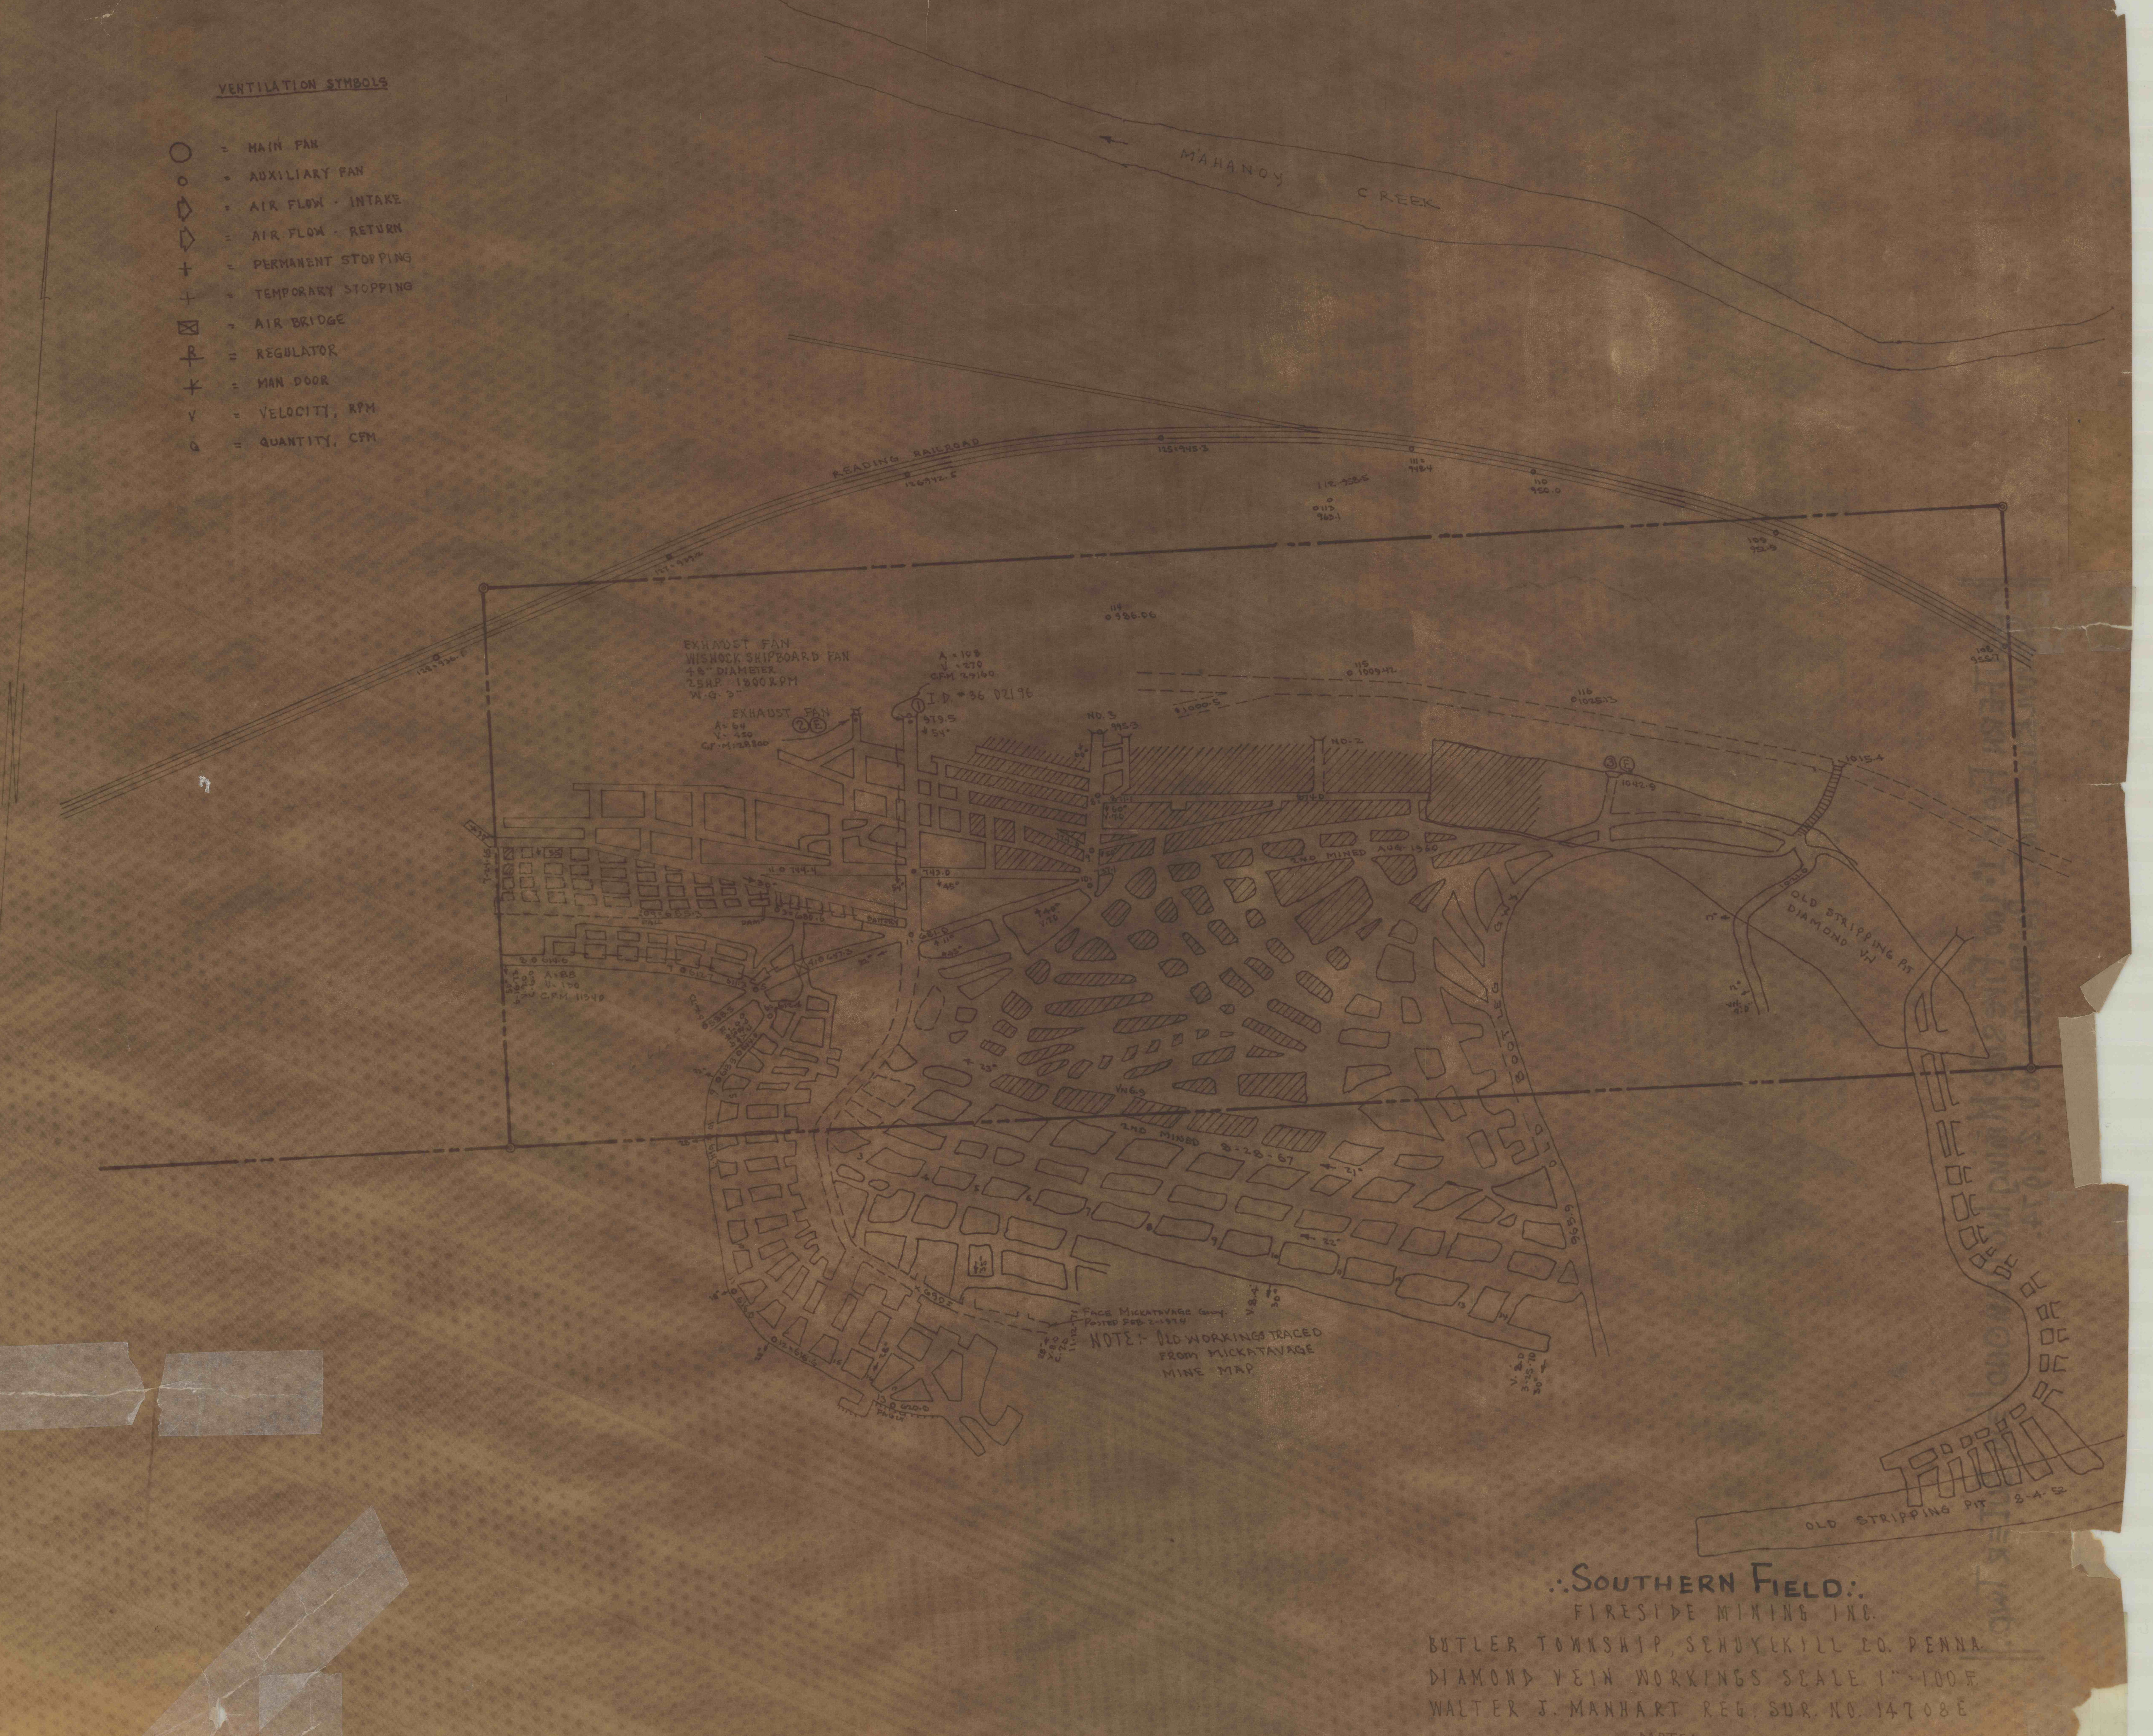
VENTILATION SYMBOLS
○ = MAIN FAN
○ = AUXILIARY FAN
= AIR FLOW - INTAKE
= AIR FLOW - RETURN
+ = PERMANENT STOPPING
+ = TEMPORARY STOPPING
⊠ = AIR BRIDGE
R = REGULATOR
= MAN DOOR
V = VELOCITY, RPM
Q = QUANTITY, CFM
MAHANOY CREEK
READING RAILROAD
126 942.5
125 945.3
127 939.2
128 936.8
112 958.5
113 963.1
111 948.4
110 950.0
109 952.9
108 955.7
114 986.06
115 1009.42
116 1025.13
1000.5
EXHAUST FAN
WISHOCK SKIPBOARD FAN
48" DIAMETER
25HP 1800RPM
W.G. 3"
A = 108
V = 270
CFM 29160
I.D. #36 DZ196
EXHAUST FAN
2E
A = 64
V = 450
CFM = 28800
979.5
54°
NO. 3
995.3
NO. 2
874.0
871.1
60°
V. 70
3E
1042.9
1015.4
1022.0
2ND MINED AUG. 1960
11 744.4
743.0
45°
30°
54°
209 685.3
FALL
DAM
680.6
BATTERY
681.0
11°
45°
40°
V. 70
41 0647.3
22°
8 614.6
A = 88
V = 130
CFM 11340
7 612.7
611.3
588.3
613.3
23°
VN 6.9
2ND MINED 8-28-67
21°
22°
28°
616.0
612 616.6
620.0
FAULT
690.3
FACE MICKATAVAGE COLLY.
POSTED FEB. 2-1974
NOTE:- OLD WORKINGS TRACED
FROM MICKATAVAGE
MINE MAP
V. 8.4
30°
V. 8.0
3-25-70
30°
965.9
OLD BOOT LEG
OLD STRIPPING PIT
DIAMOND VN
OLD STRIPPING PIT 8-4-52

.·.SOUTHERN FIELD.·.

FIRESIDE MINING INC.
BUTLER TOWNSHIP, SCHUYLKILL CO. PENNA.
DIAMOND VEIN WORKINGS SCALE 1" = 100 FT.
WALTER J. MANHART REG. SUR. NO. 14708E
POSTED
6-16-73
2-2-74