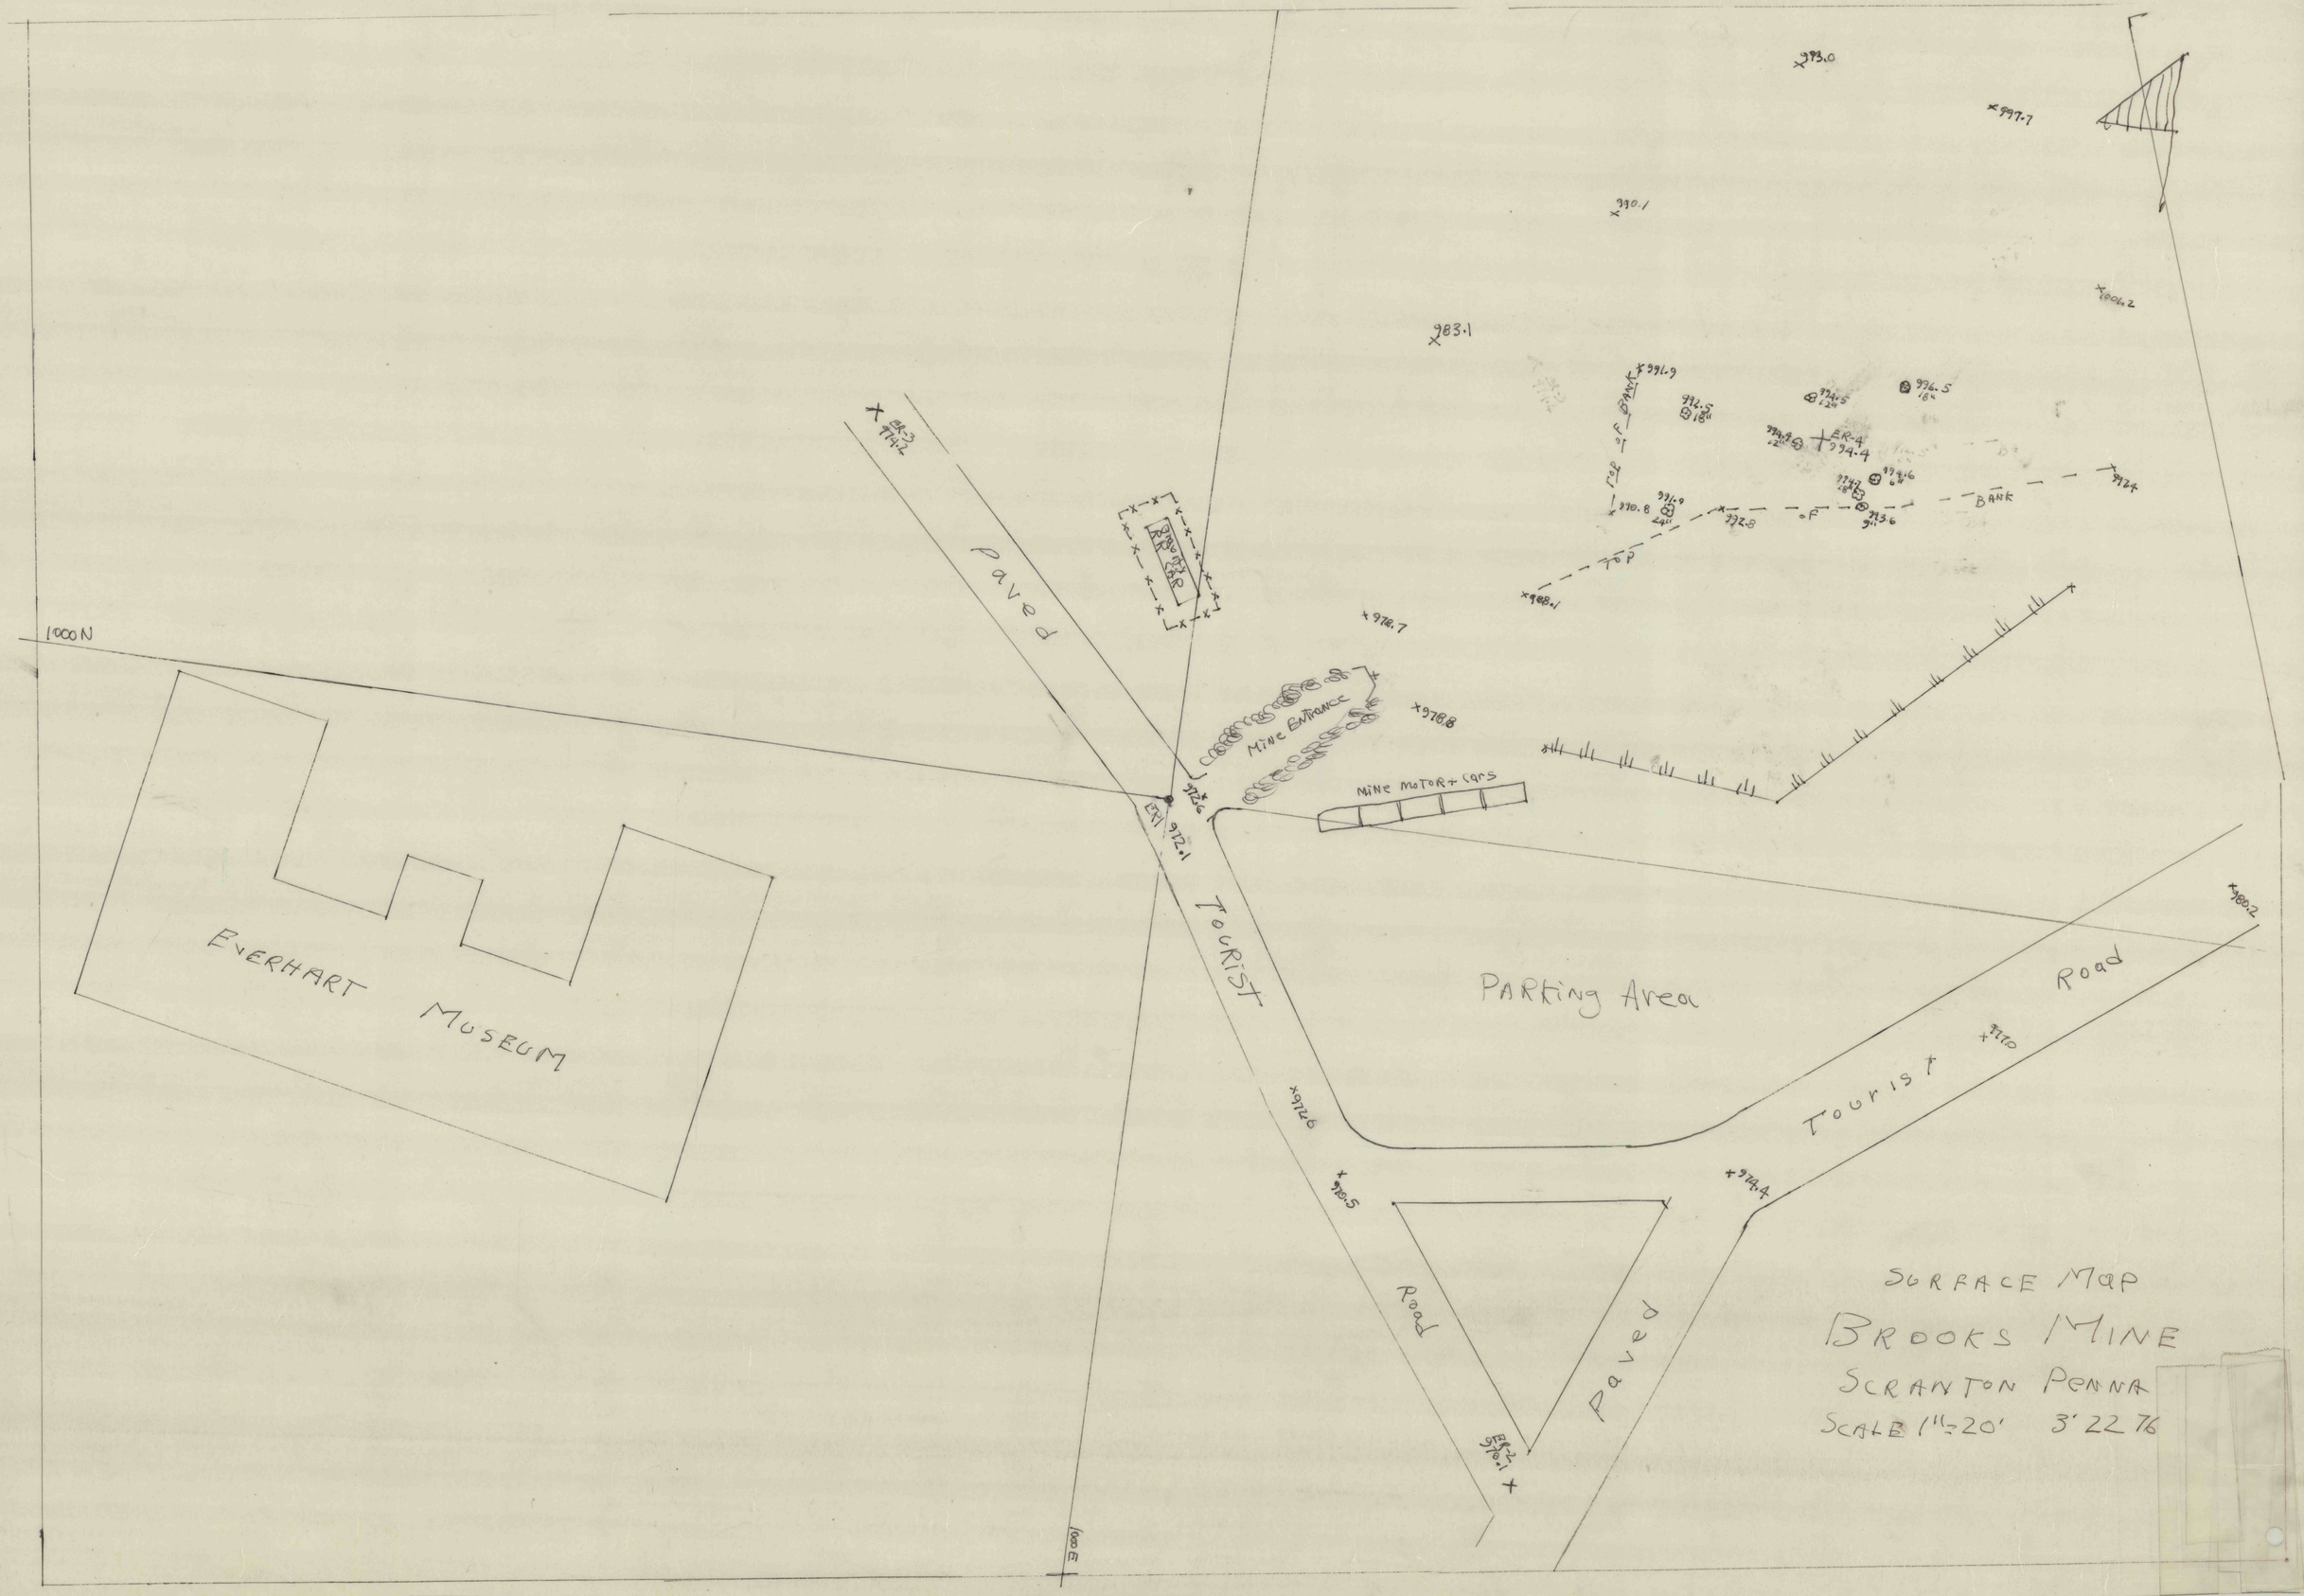
1000 N
1000 E
EVERHART MUSEUM
Paved
Mine Entrance
Mine Motor + cars
TOURIST
Road
PARKING Area
TOURIST
Road
Paved
Road
BANK
BANK
TOP
TOP
ER-4
994.4
ER-1
912.1
ER-2
970.1
SURFACE MAP
BROOKS MINE
SCRANTON PENNA
SCALE 1"=20' 3'22'76