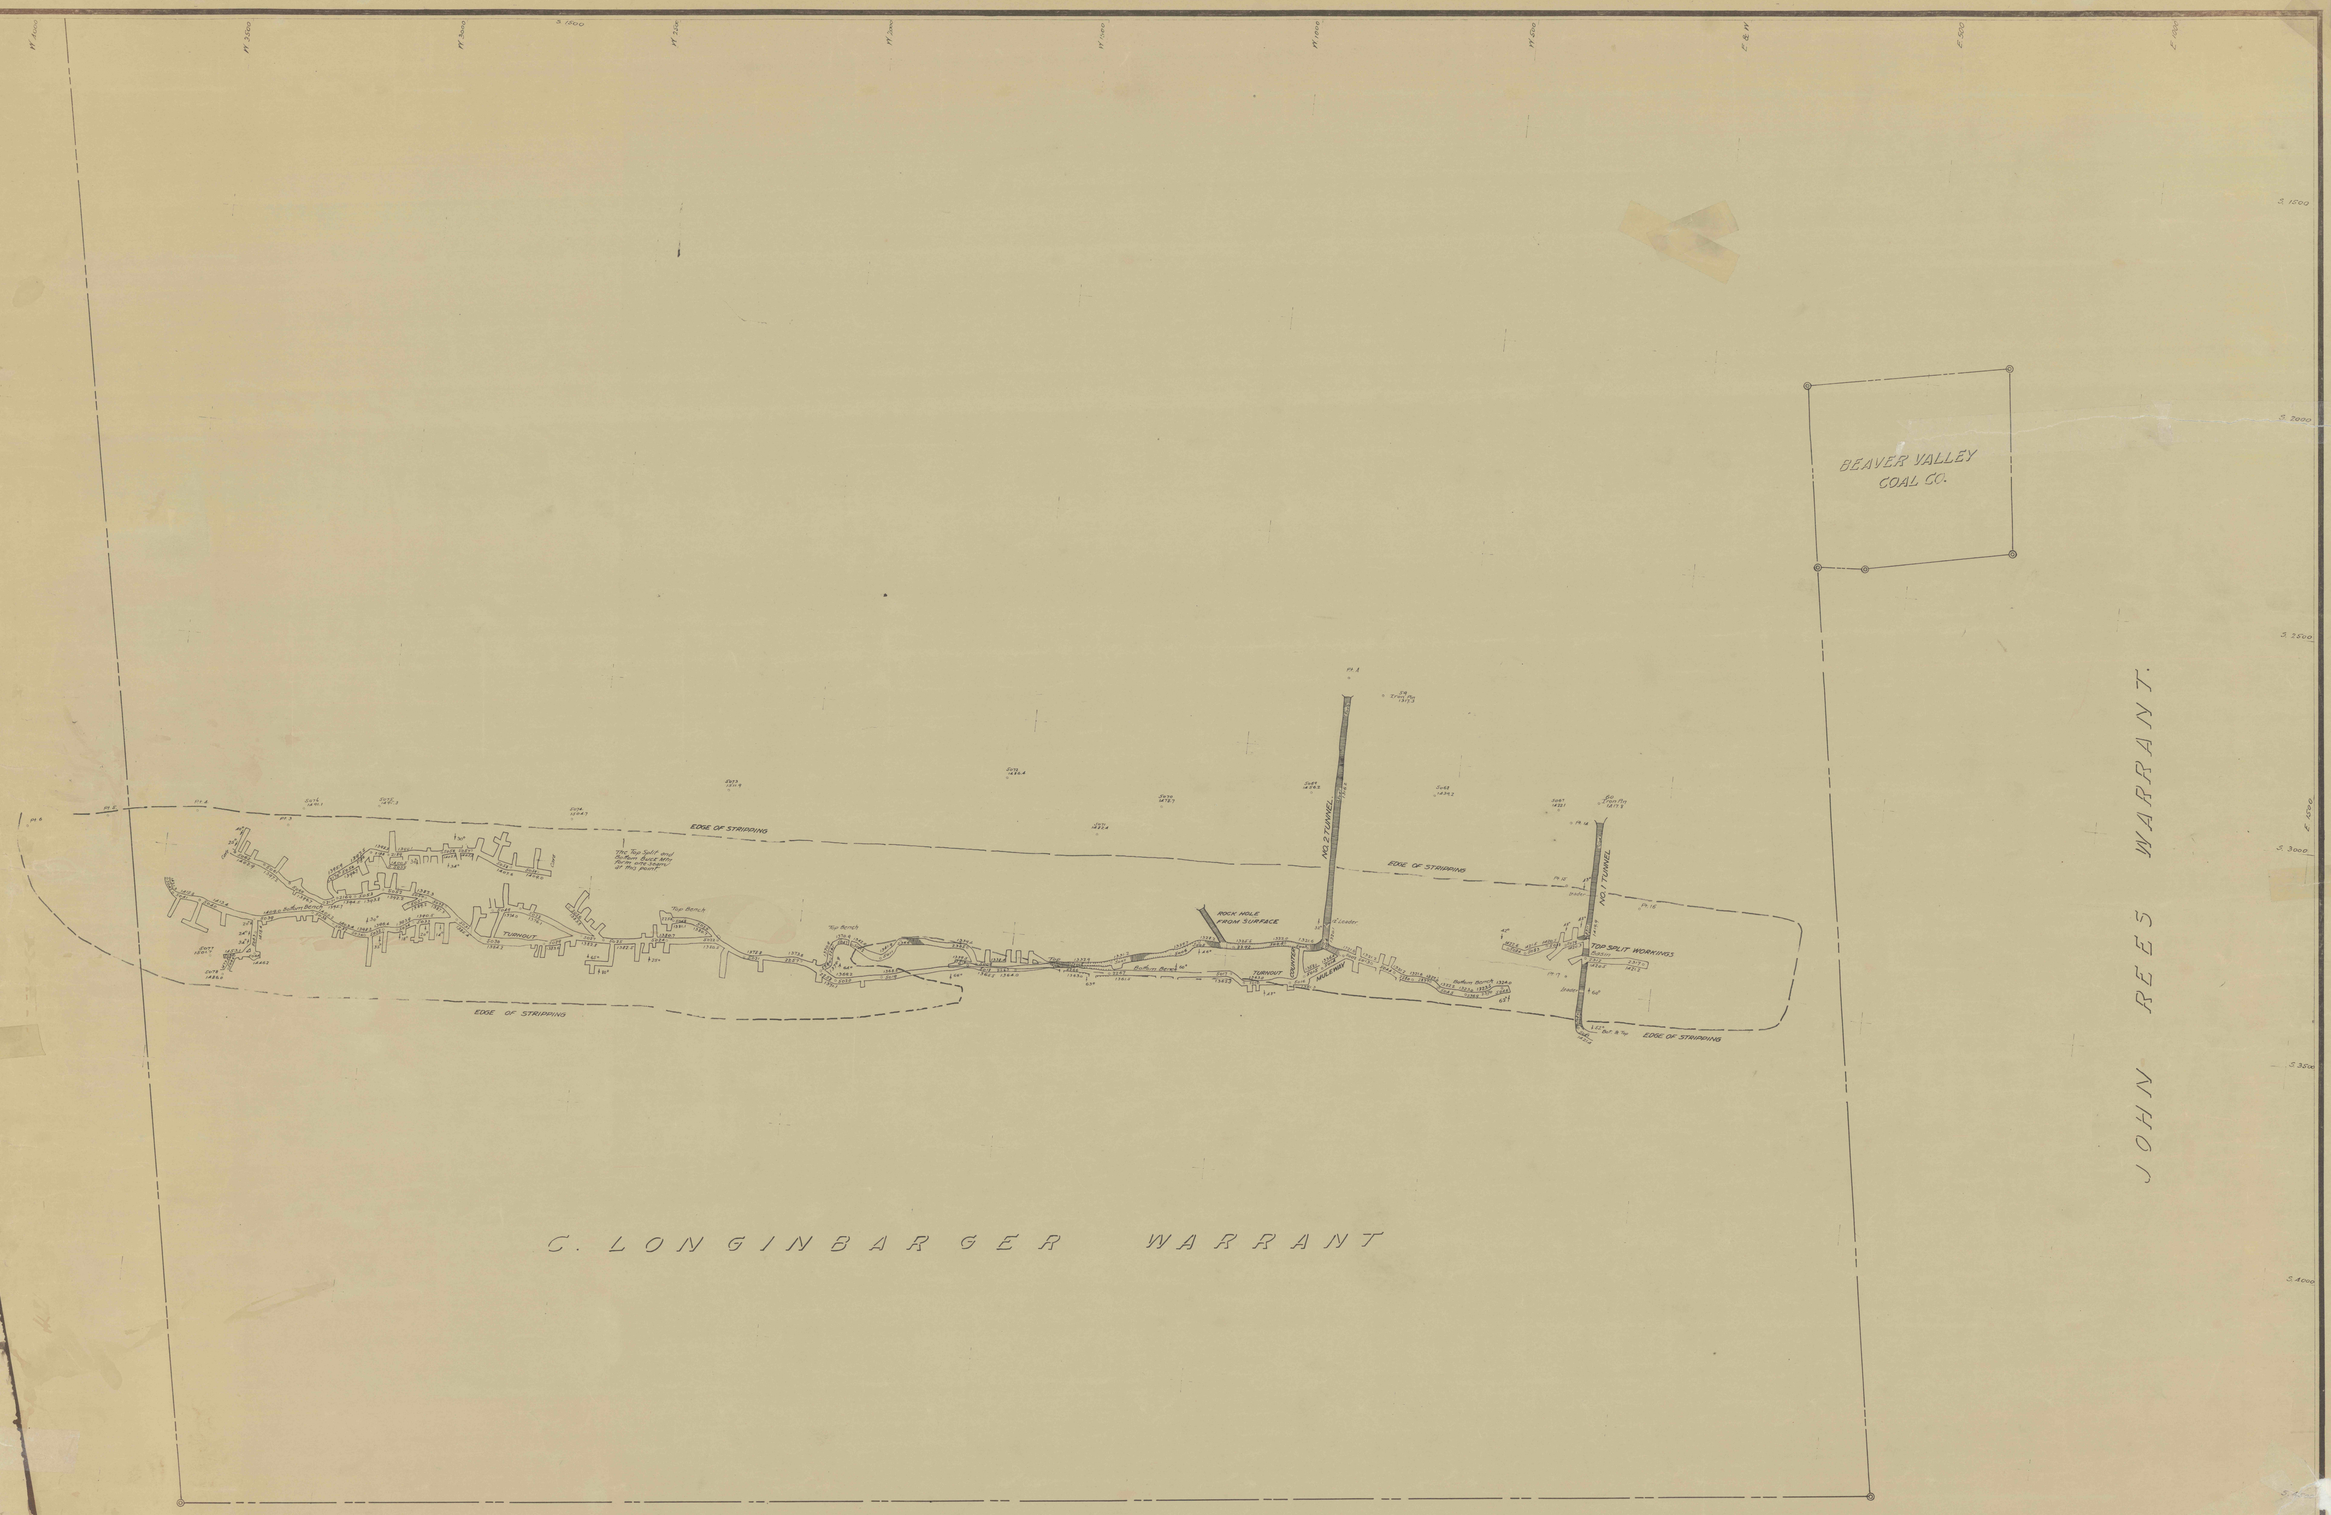

EASTERN MIDDLE FIELD. Beaver Twp.
BUCK MOUNTAIN VEIN.
COLUMBIA COUNTY.
BEAVER VALLEY COAL CO.

SCOTCH VALLEY, PENN'A. SCALE, 1 INCH = 100 FEET.

Datum = Mean Tidal Elevation.

OCT 11 1972 MF

MF OCT 11 1972 3-OF-4