


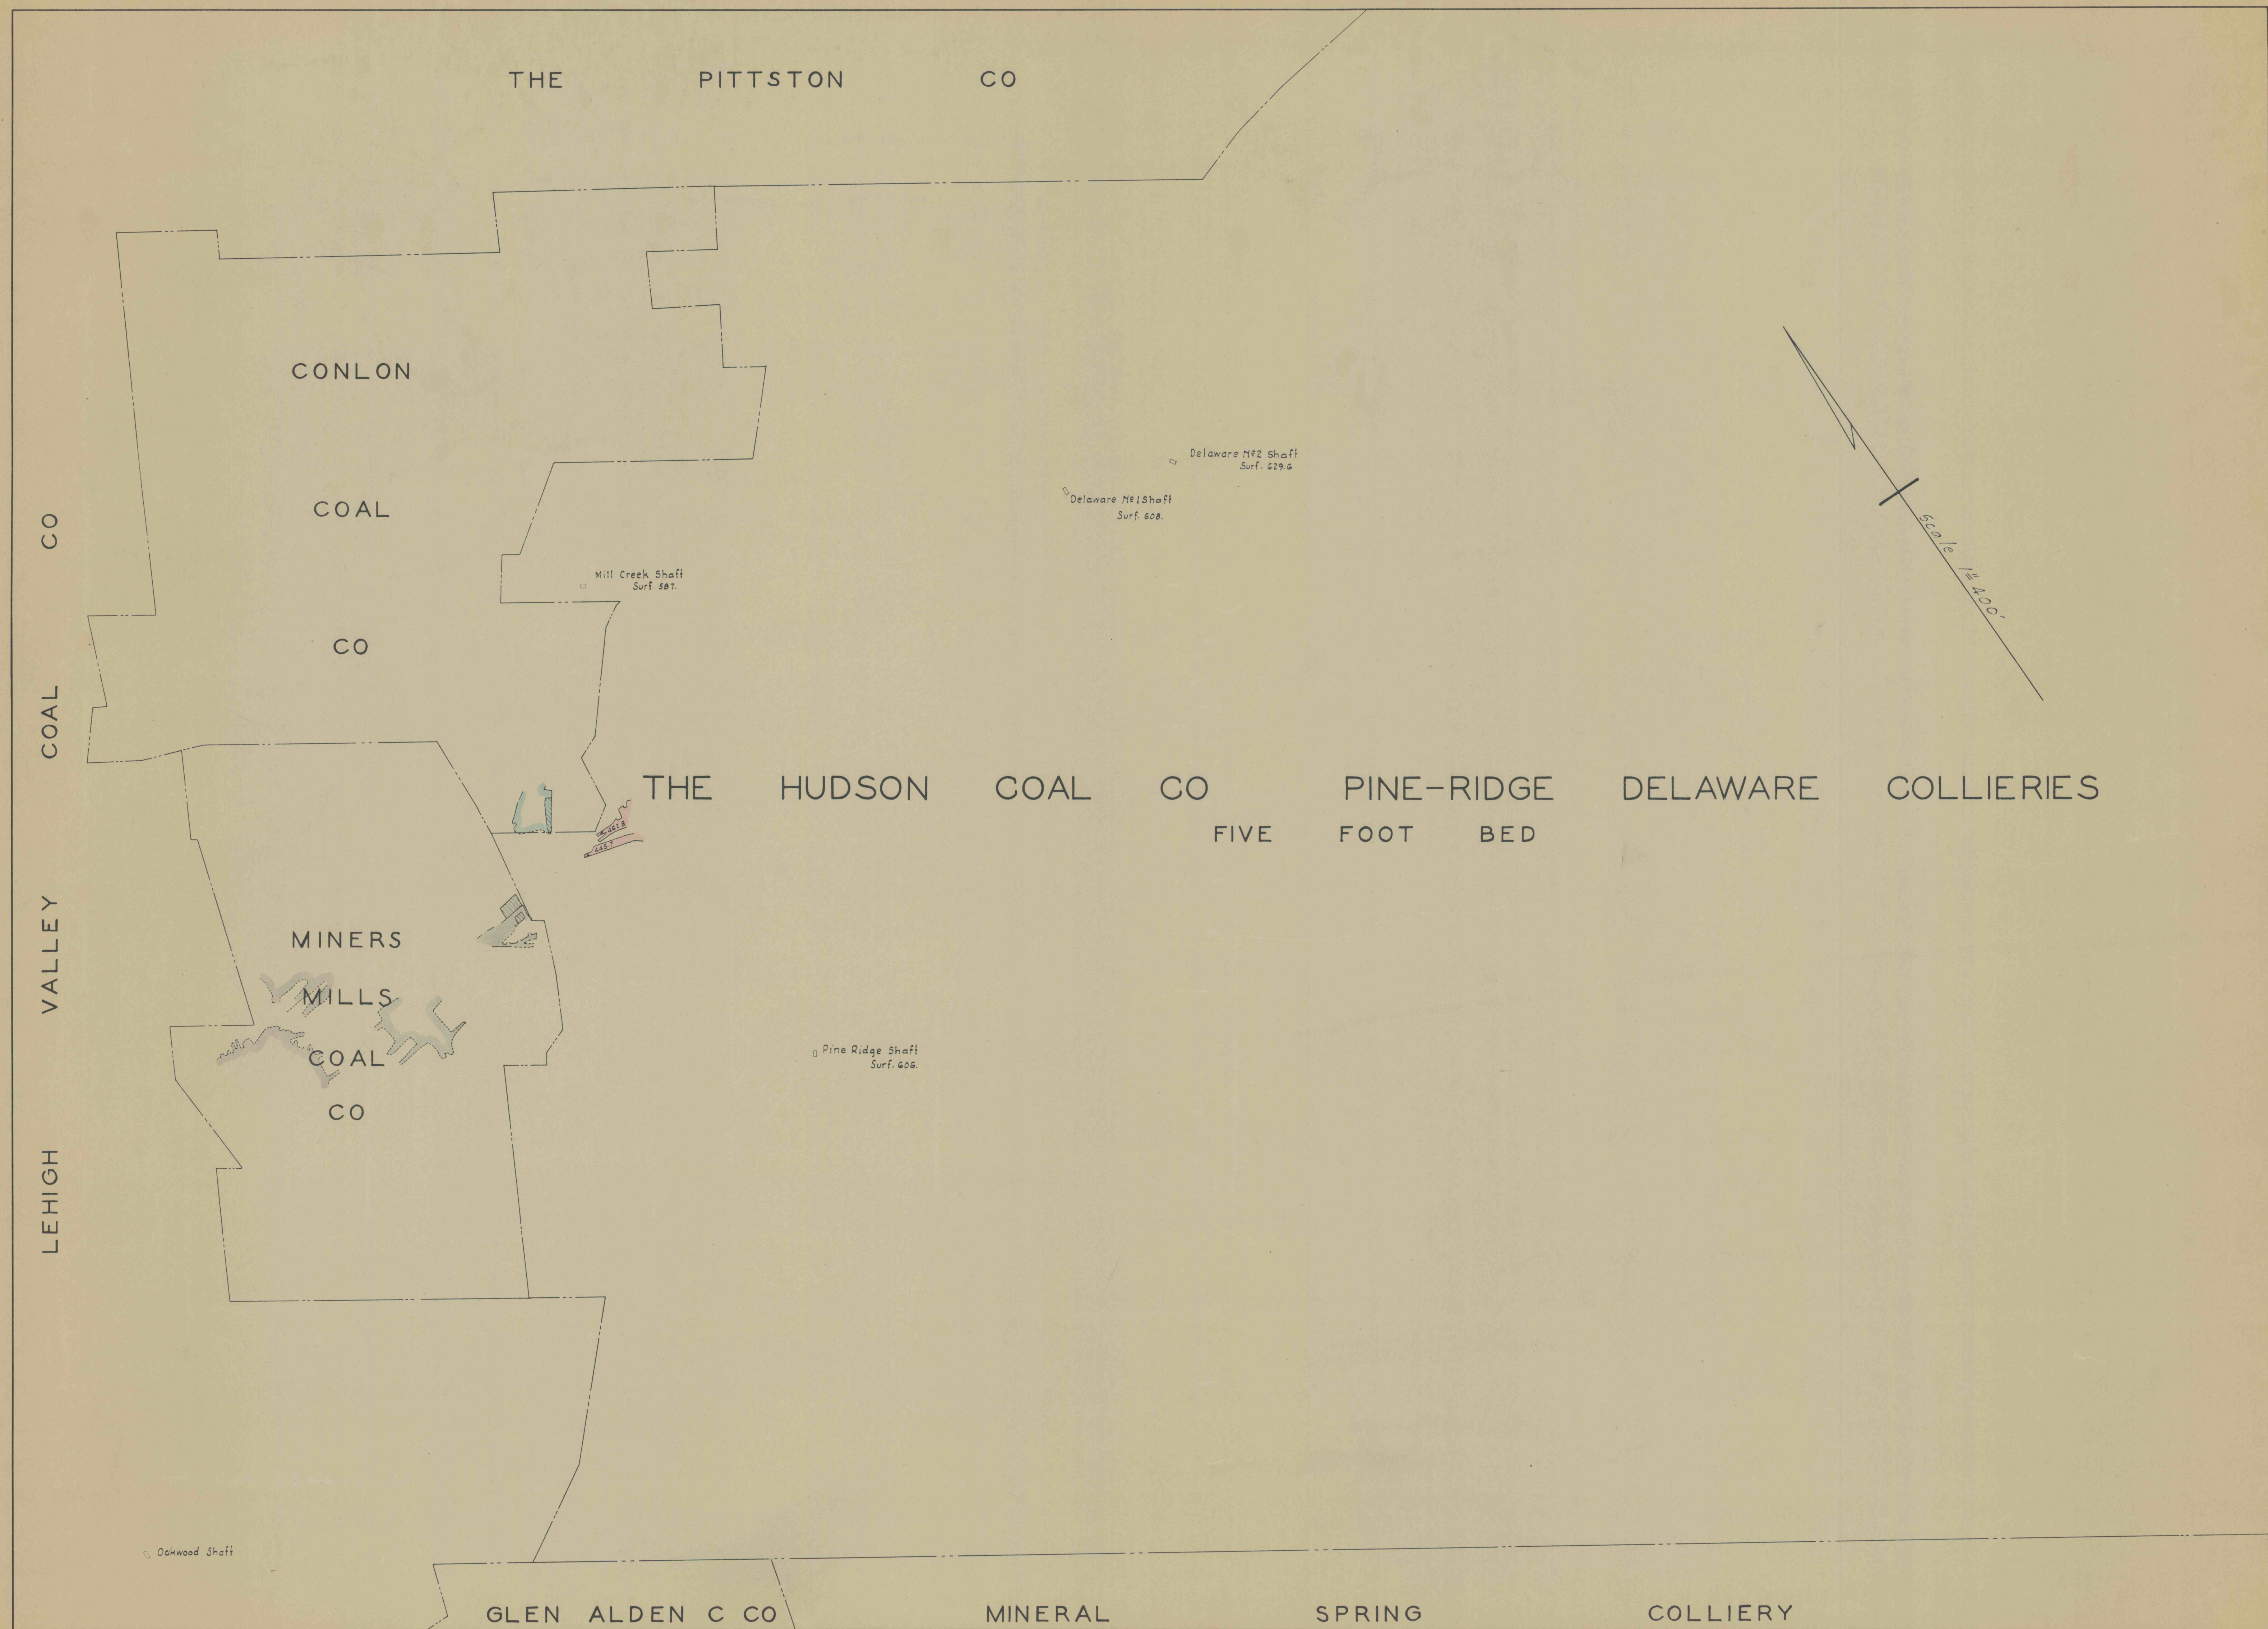

THE PITTSTON CO

CONLON

COAL

CO

THE HUDSON COAL CO

PINE-RIDGE

DELAWARE

COLLIERIES

FIVE

FOOT

BED

MINERS

MILLS

COAL

CO

Pine Ridge Shaft
Surf. 606.

Delaware #1 Shaft
Surf. 608.

Delaware #2 Shaft
Surf. 629.6

Mill Creek Shaft
Surf. 587.

Oakwood Shaft

GLEN ALDEN C CO

MINERAL

SPRING

COLLIERY

CO

COAL

VALLEY

LEHIGH

Scale 1" = 400'