



SECTIONS Looking West

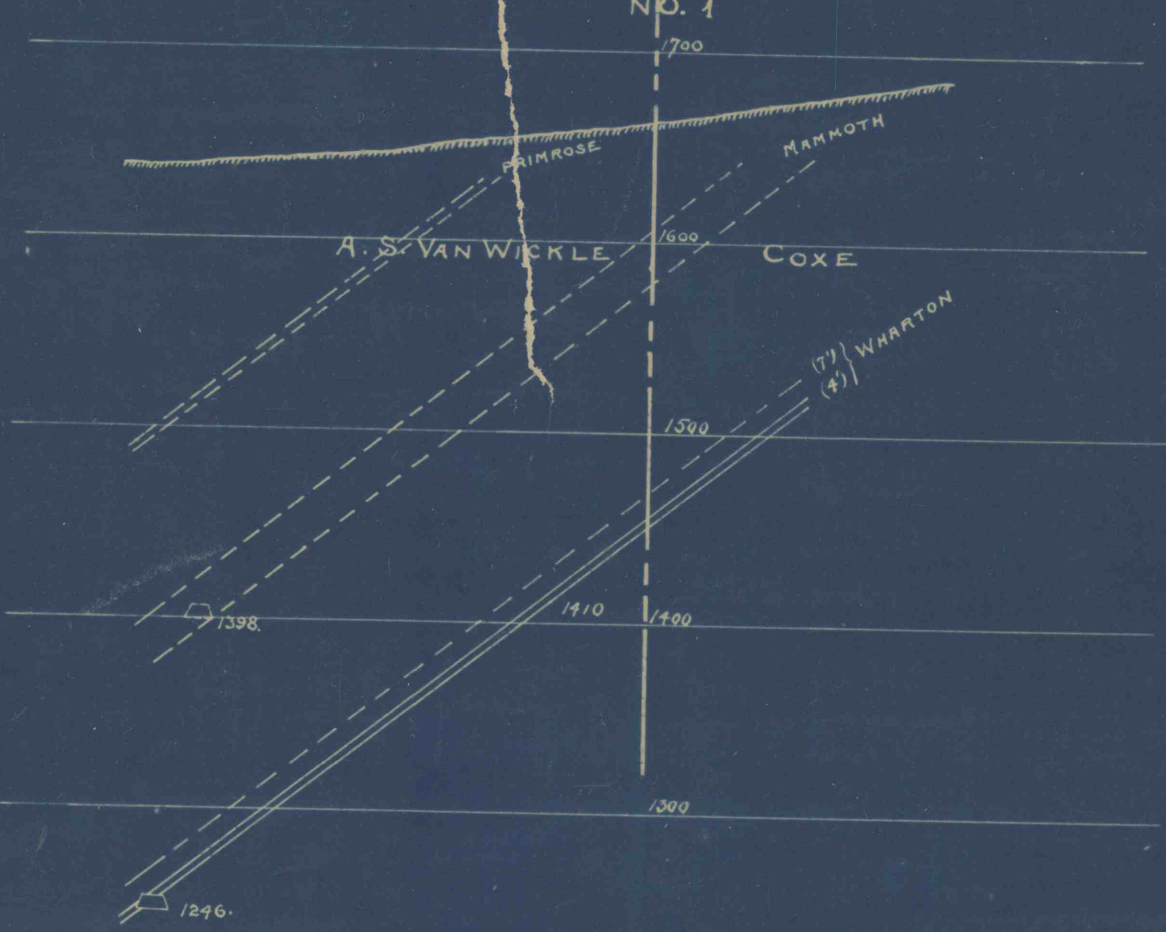


No 2 NEW SLOPE

SECTION 2 WAS FURNISHED WITH PREVIOUS AGREEMENT


SECTION 3

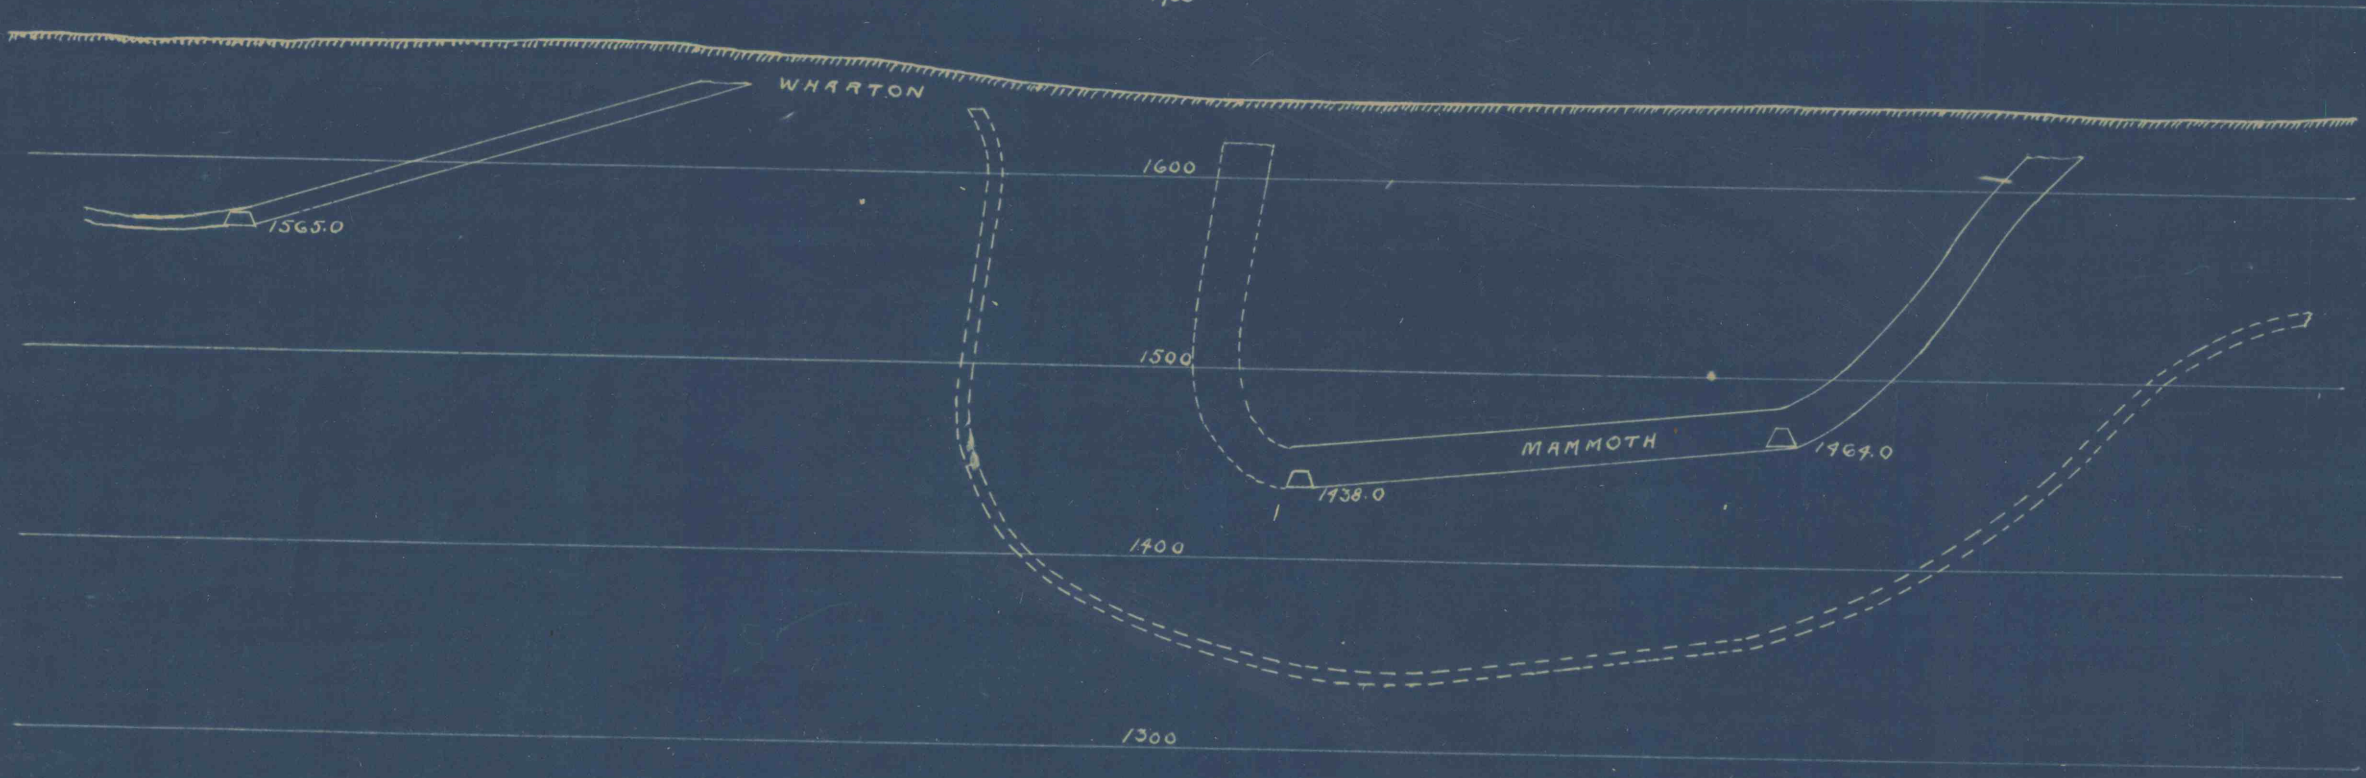


SECTION 4

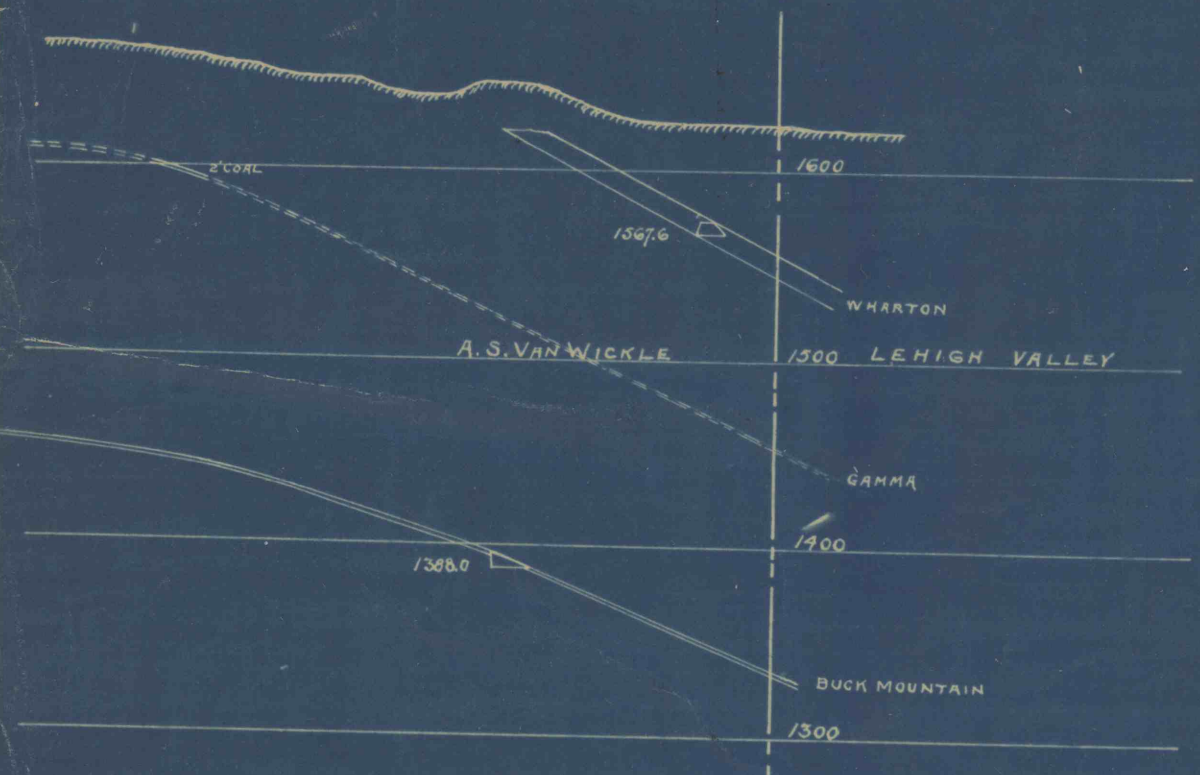


SECTION 5

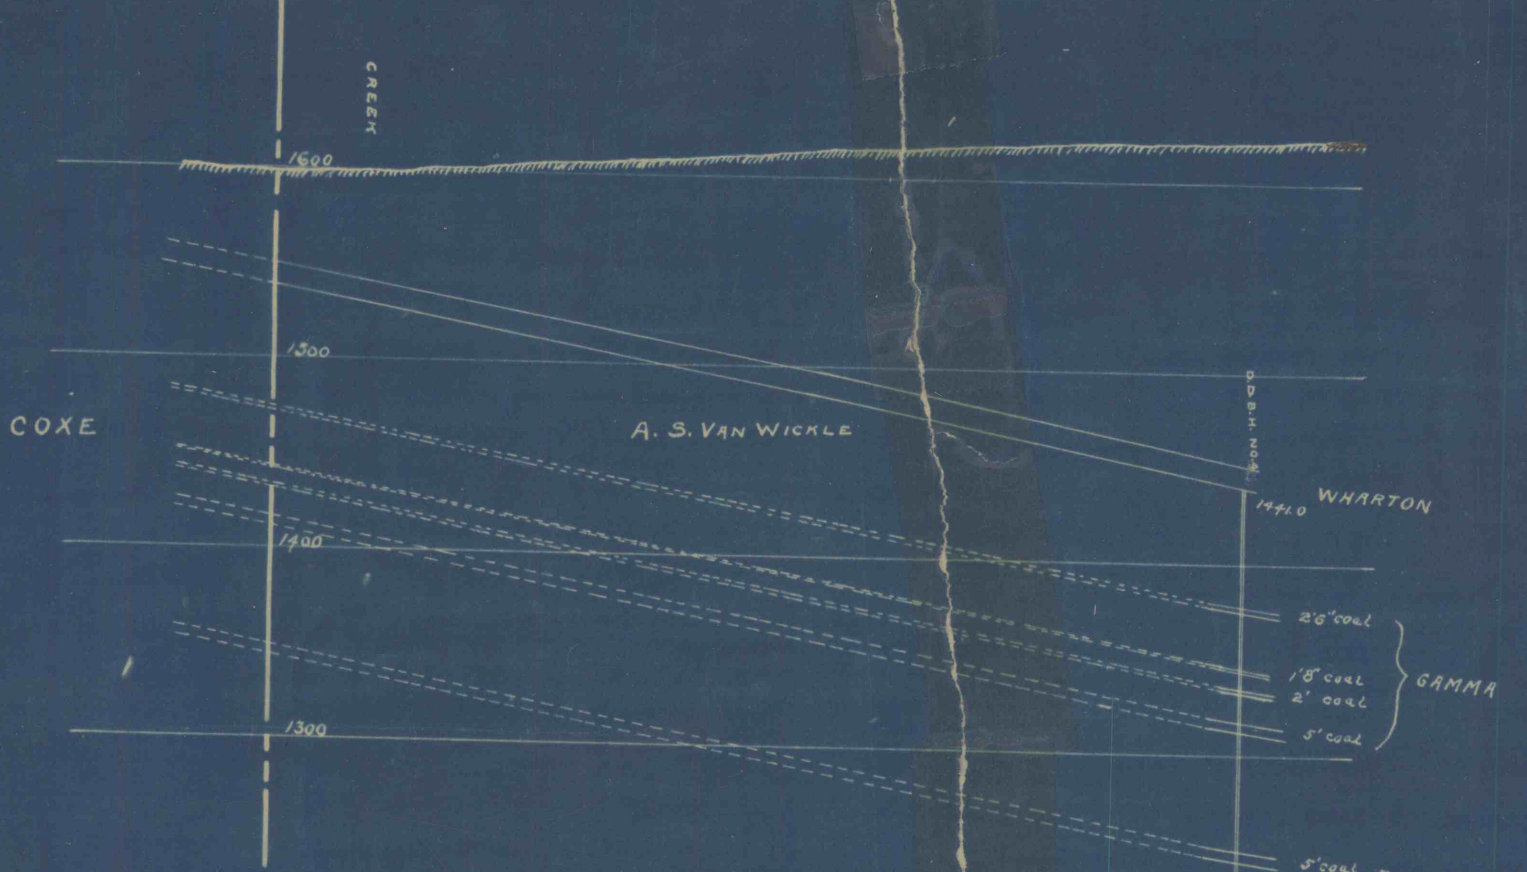

SECTION 6

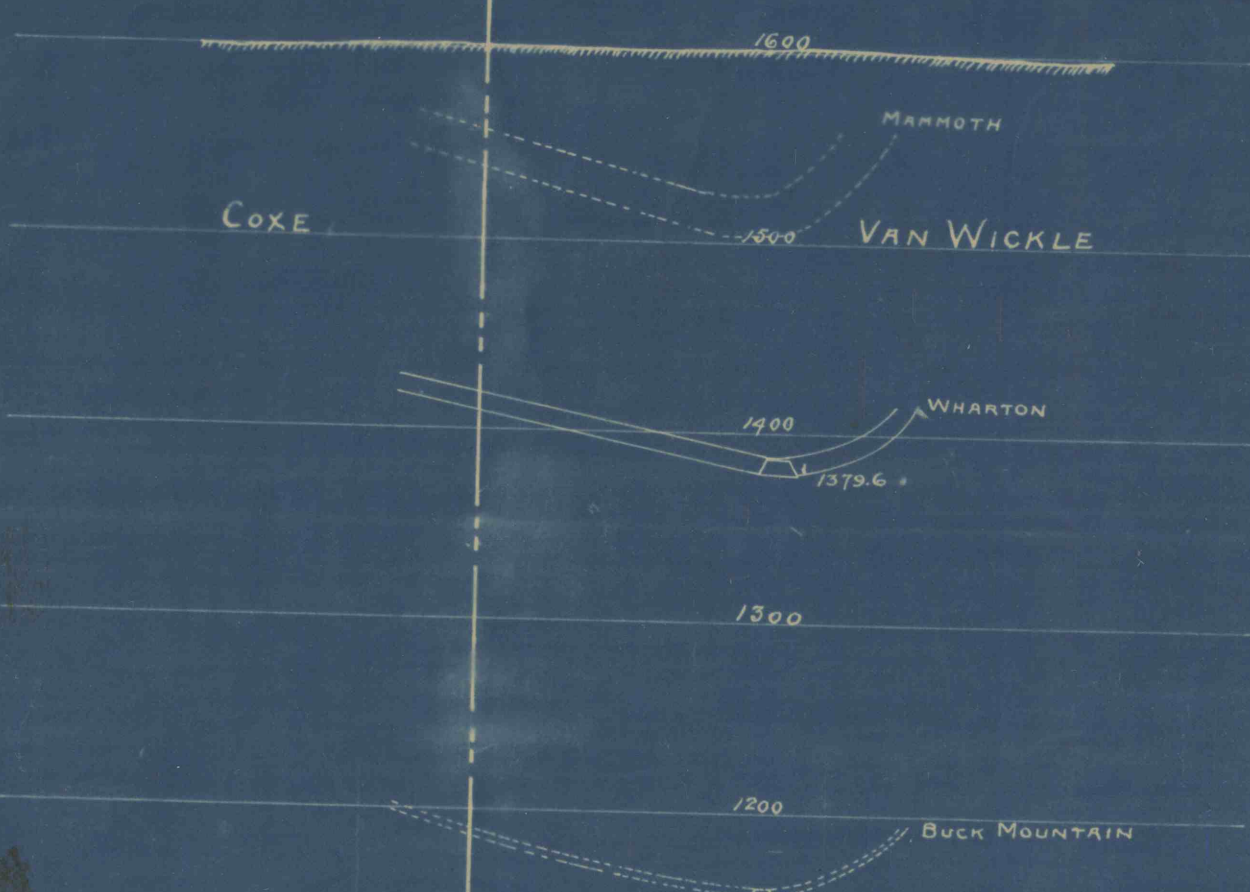

SECTION 7

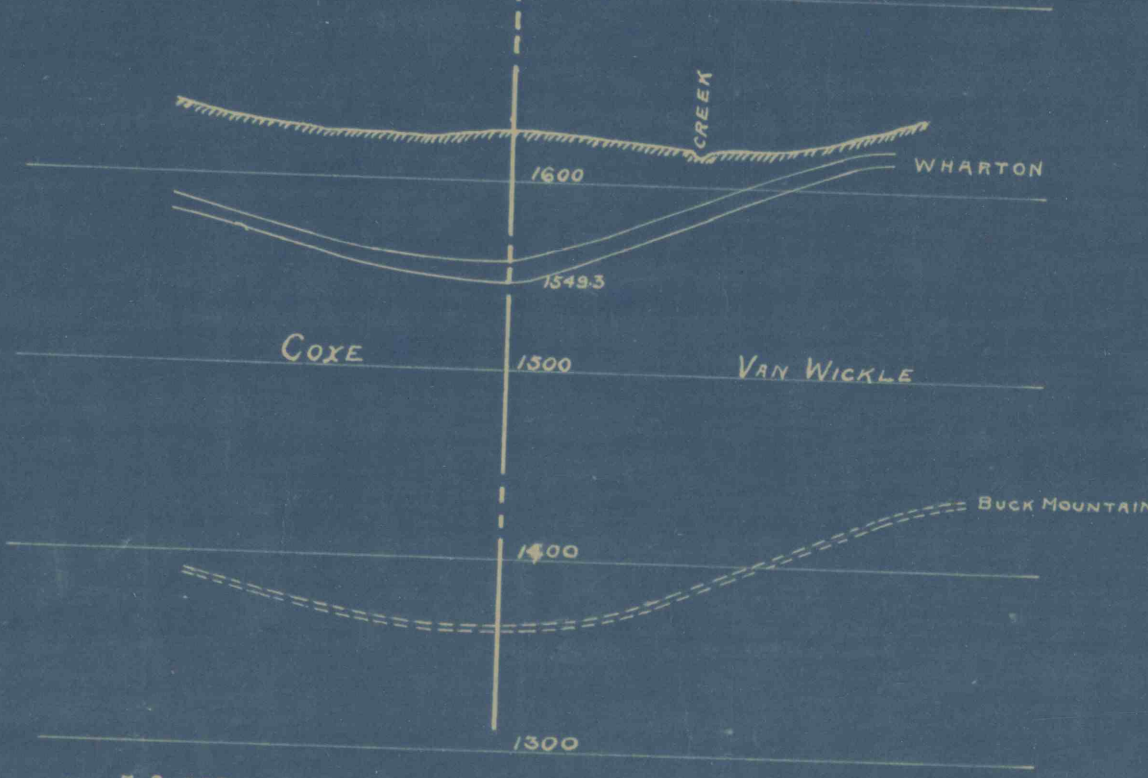

No 7 SLOPE

SECTIONS AND PLAN OF COLERAINE MINE WORKINGS
ADJOINING PROPERTY LINES — PER AGREEMENT
OF ENGINEERS AND MINE INSPECTOR — AUG. 12TH, 1896

JAN. 1897

SCALE 100 FEET = 1 INCH

W. L. CHAMBERLIN
ENGINEER

- PRINCE
- MARROTH
- WHARTON
- BUCK MOUNTAIN
- WORKINGS FROM OLD MAPS

No 1 SLOPE

807 11 1872
MF