


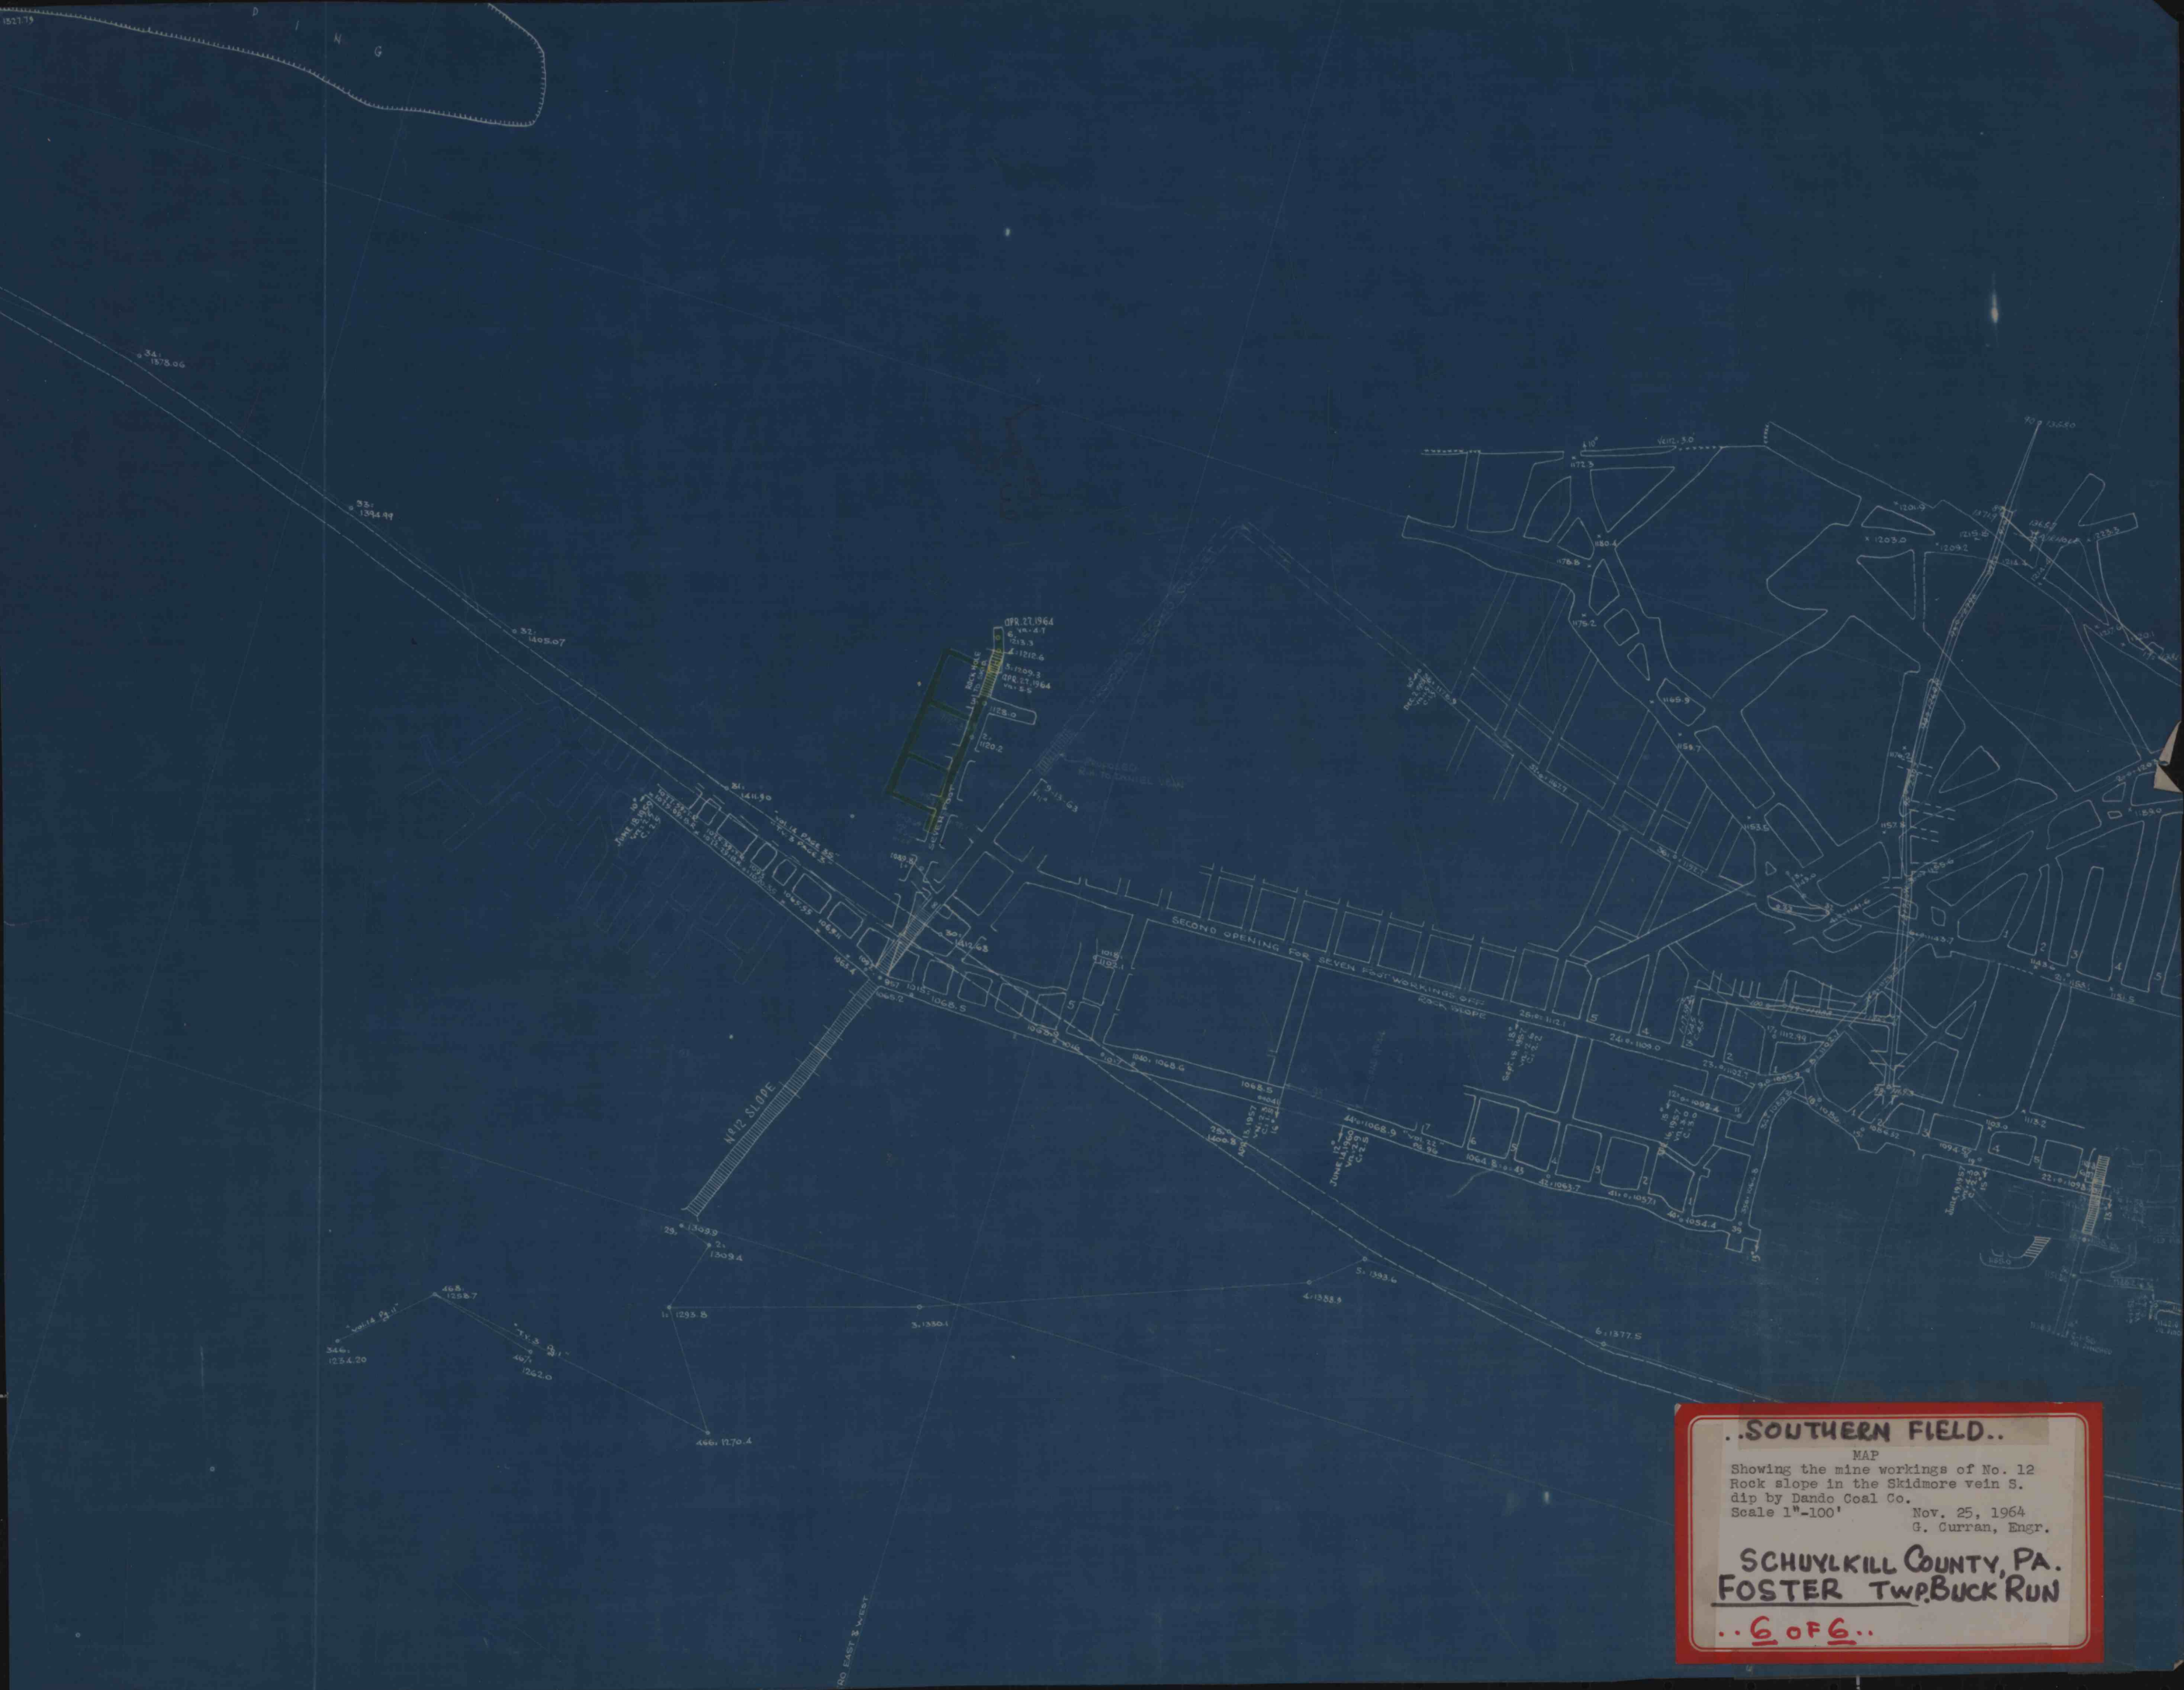

SOUTHERN FIELD.
MAP
Showing the mine workings of No. 12
Rock slope in the Skidmore vein S.
dip by Dando Coal Co.
Scale 1"=100' Nov. 25, 1964
G. Curran, Engr.
SCHUYLKILL COUNTY, PA.
FOSTER TWP. BUCK RUN
..6 OF 6..