


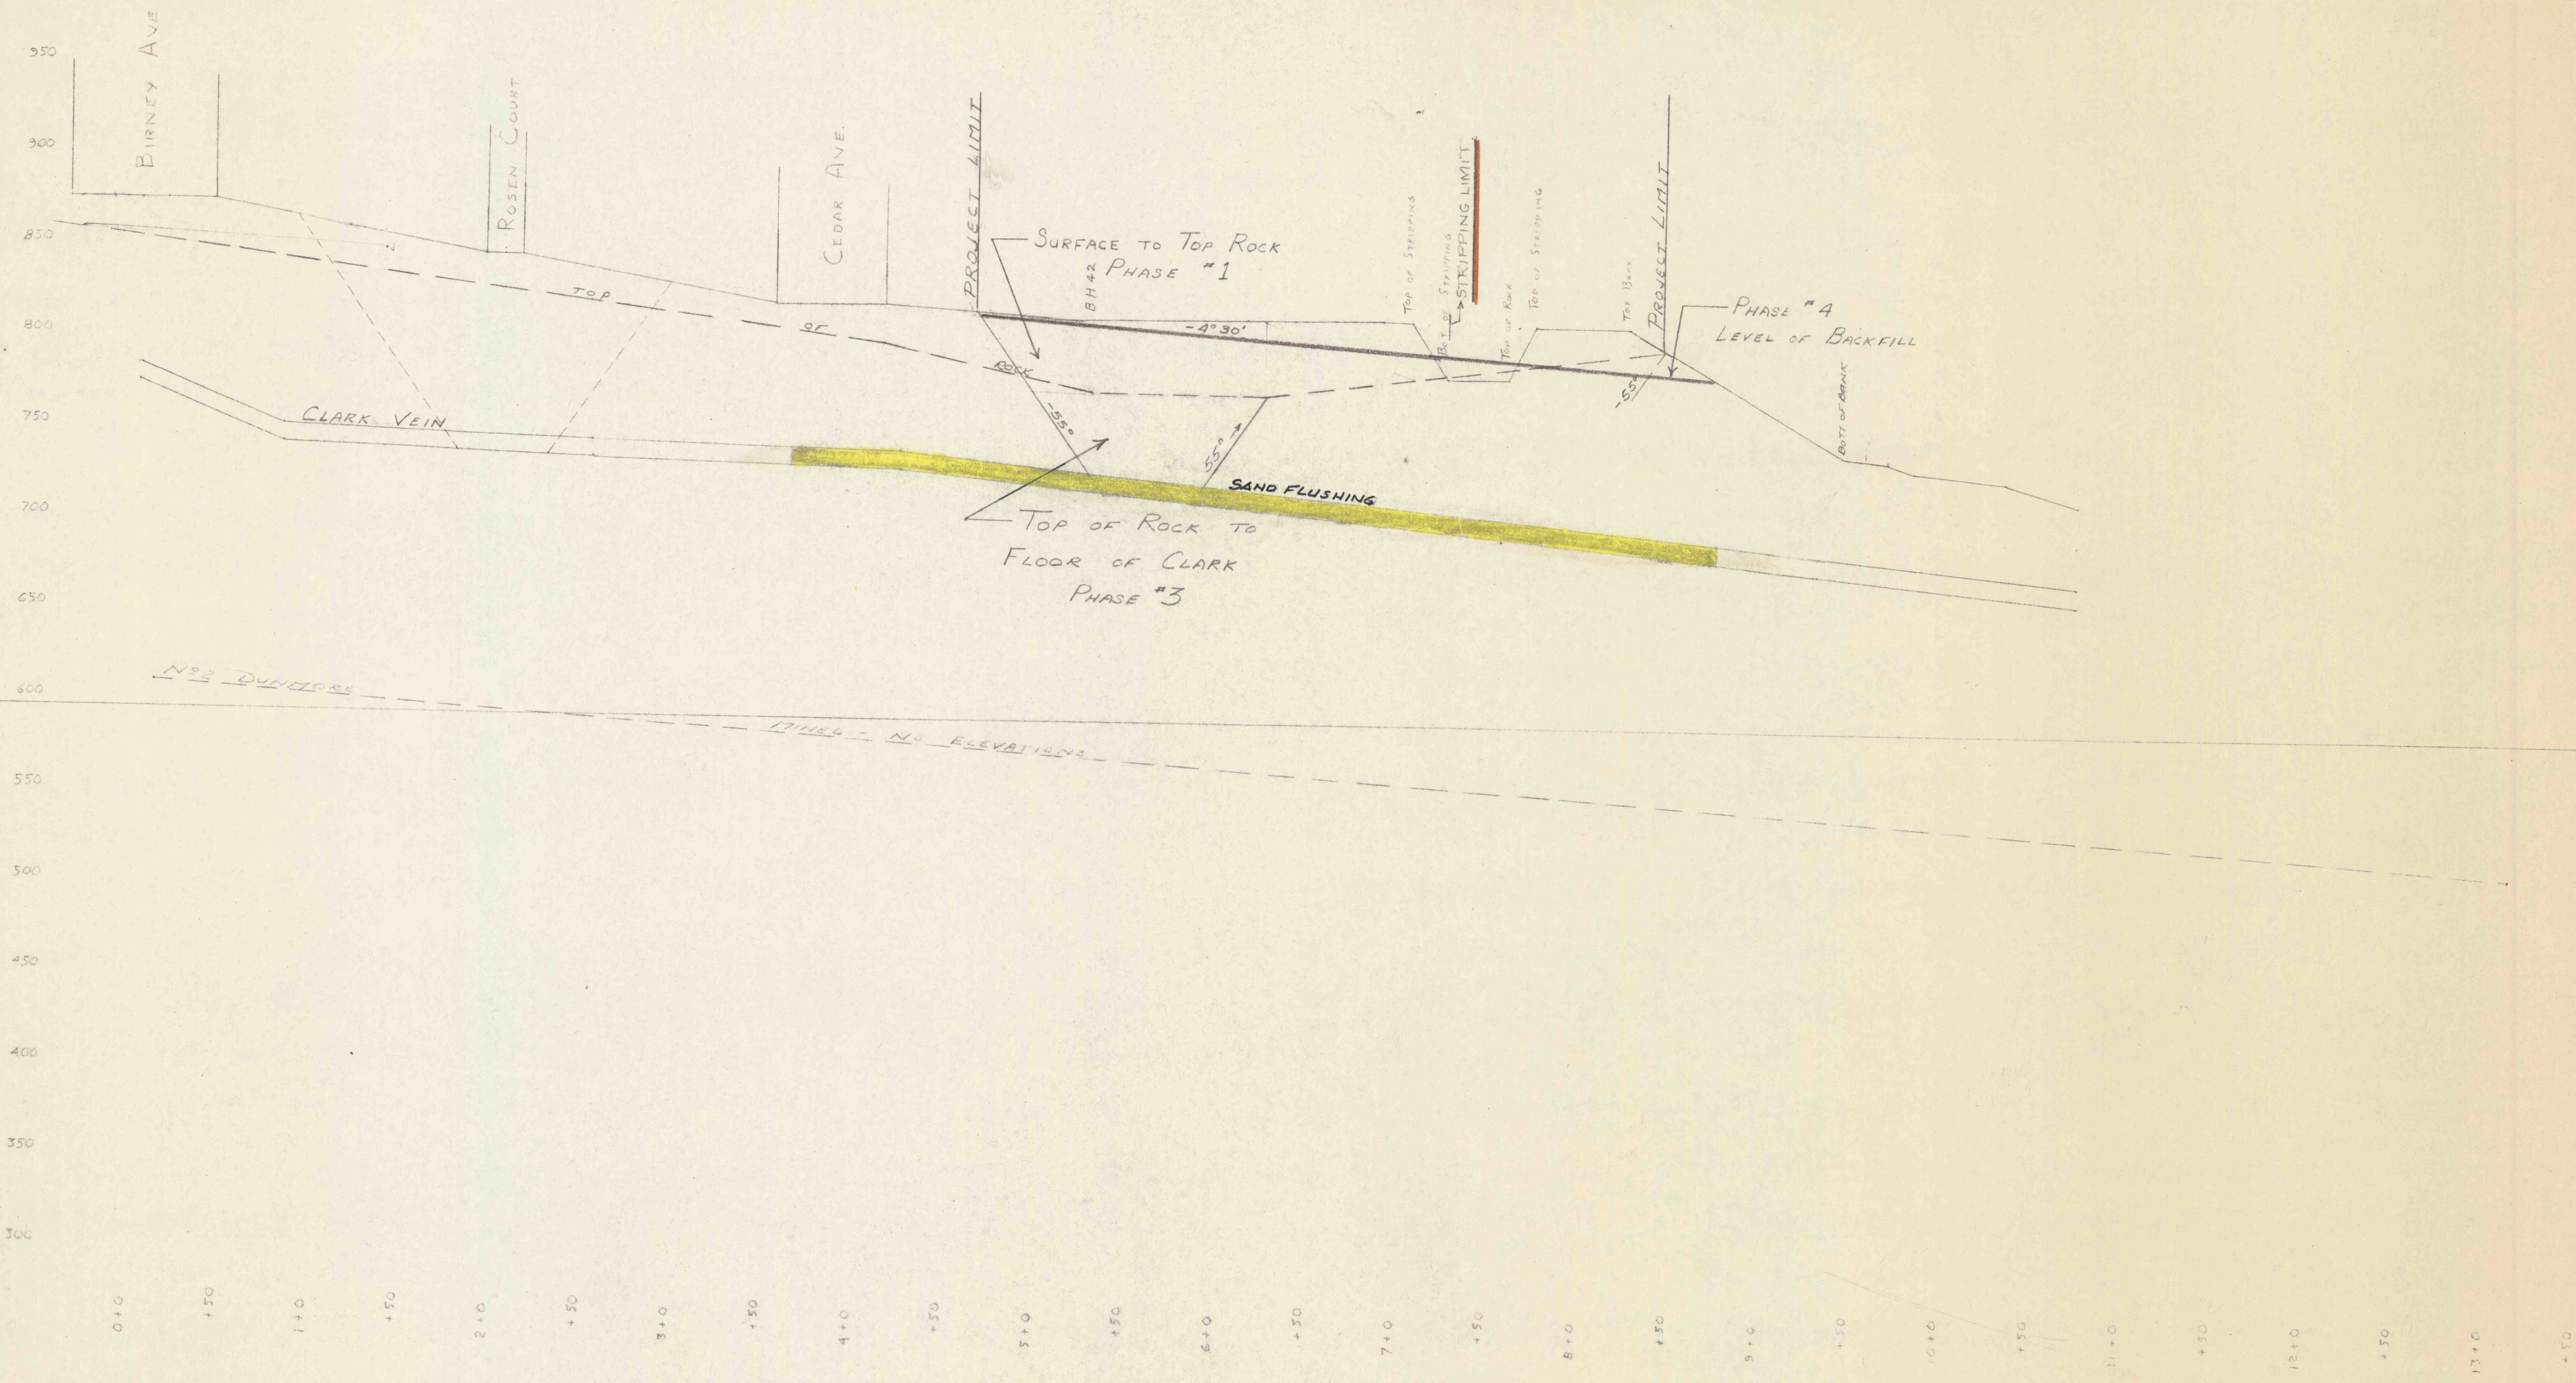

X-SECTION 5 CEDAR AVE MINE FIRE
SCRANTON, PA.
SCALE HOR & VERT. 1" = 50'