


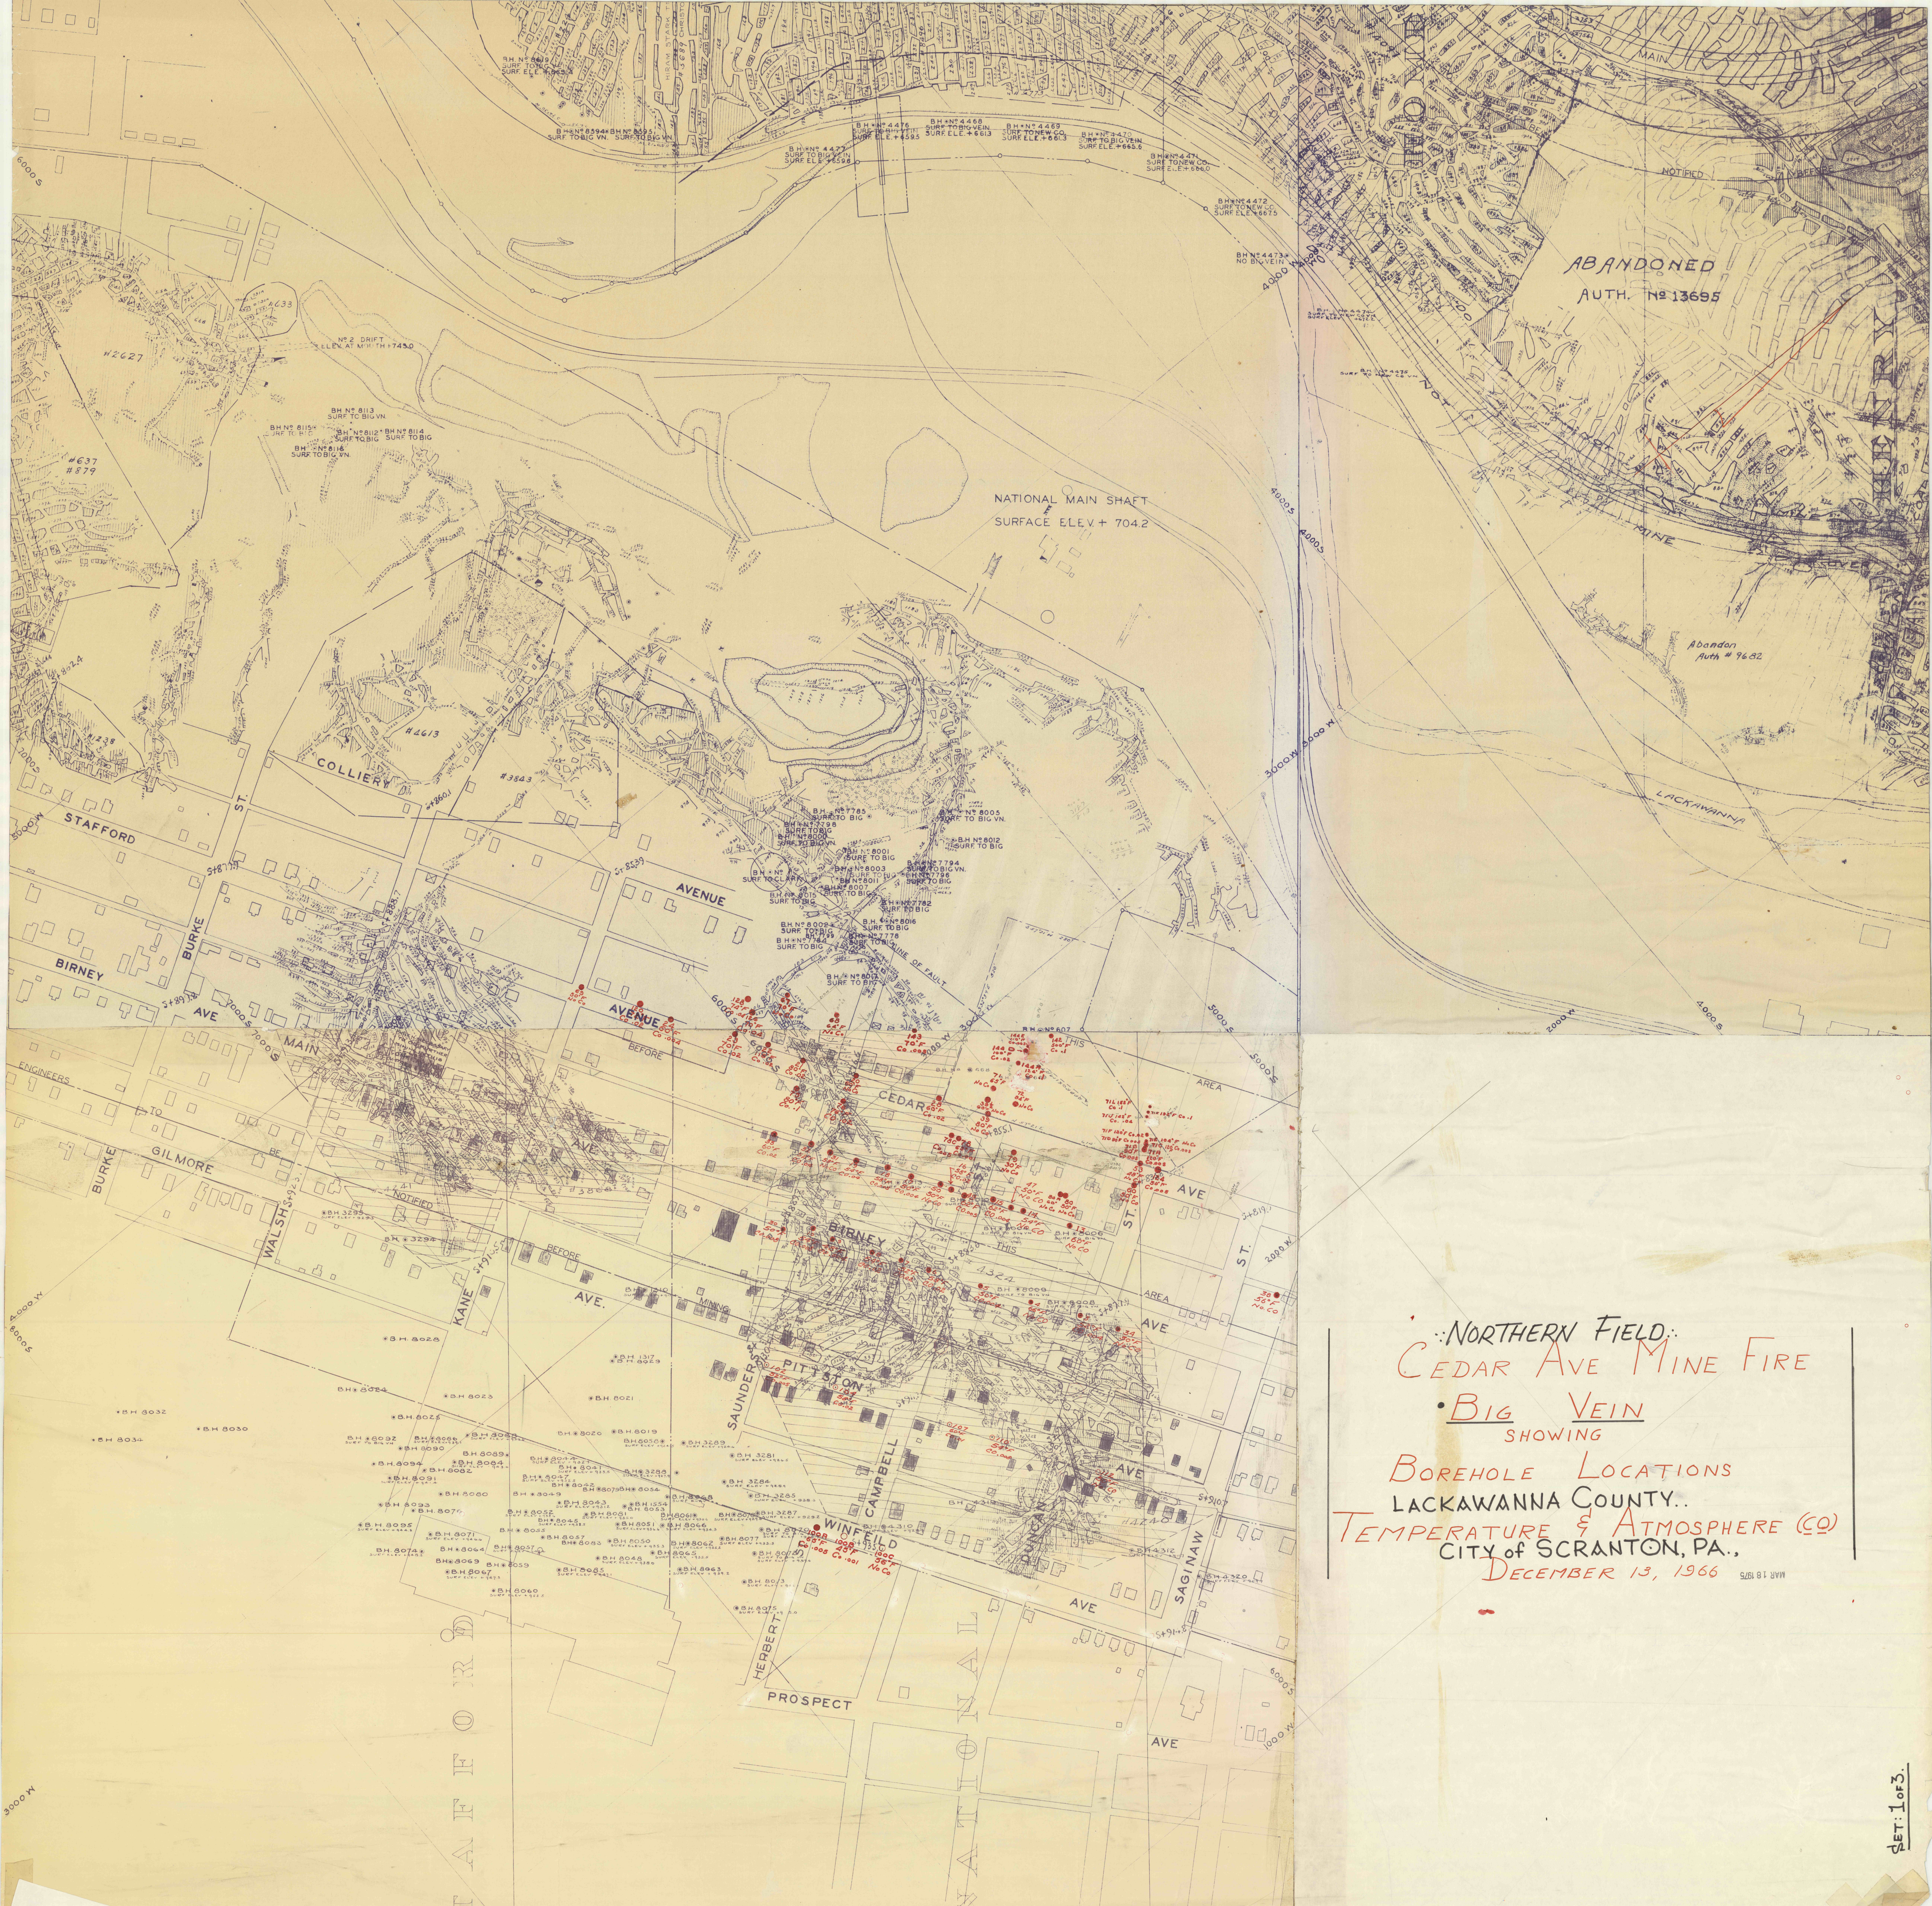

NORTHERN FIELD:
CEDAR AVE MINE FIRE
• BIG VEIN
SHOWING
BOREHOLE LOCATIONS
LACKAWANNA COUNTY..
TEMPERATURE & ATMOSPHERE (CO)
CITY OF SCRANTON, PA.,
DECEMBER 13, 1966