


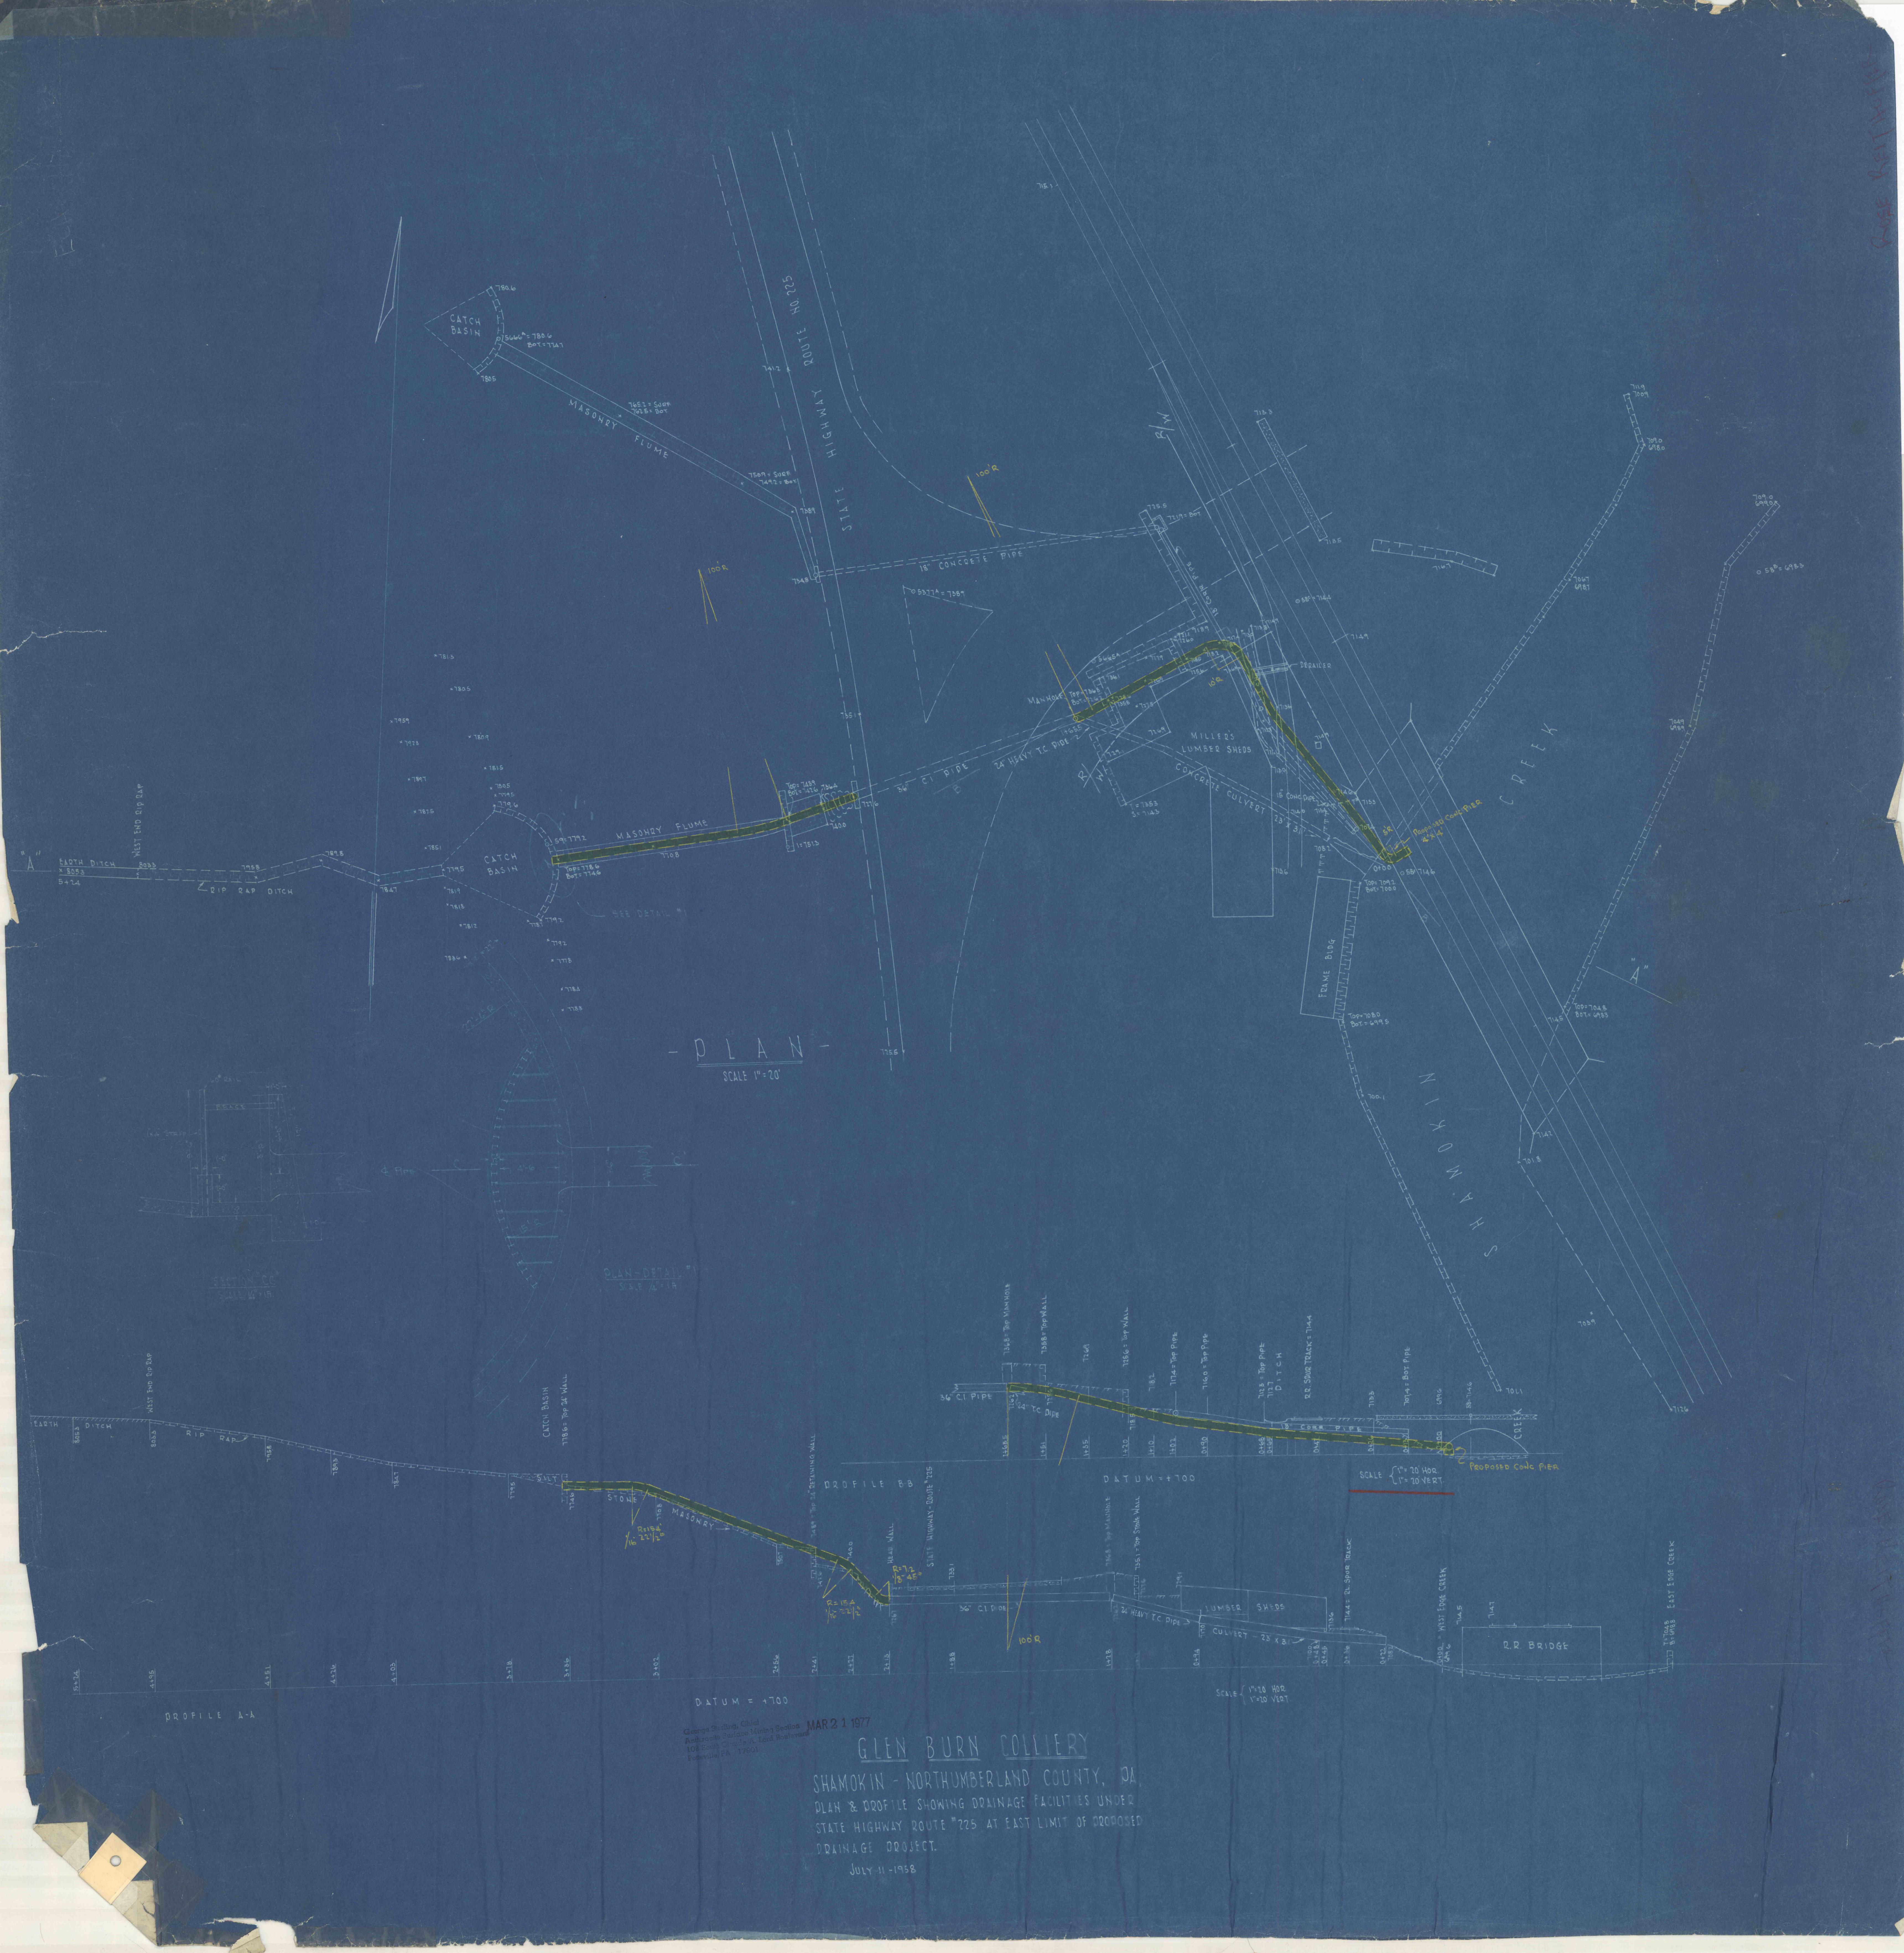


MAR 21 1977

GLEN BURN COLLIERY

SHAMOKIN - NORTHUMBERLAND COUNTY, PA.
PLAN & PROFILE SHOWING DRAINAGE FACILITIES UNDER
STATE HIGHWAY ROUTE 225 AT EAST LIMIT OF PROPOSED
DRAINAGE PROJECT.

JULY 11 - 1958