


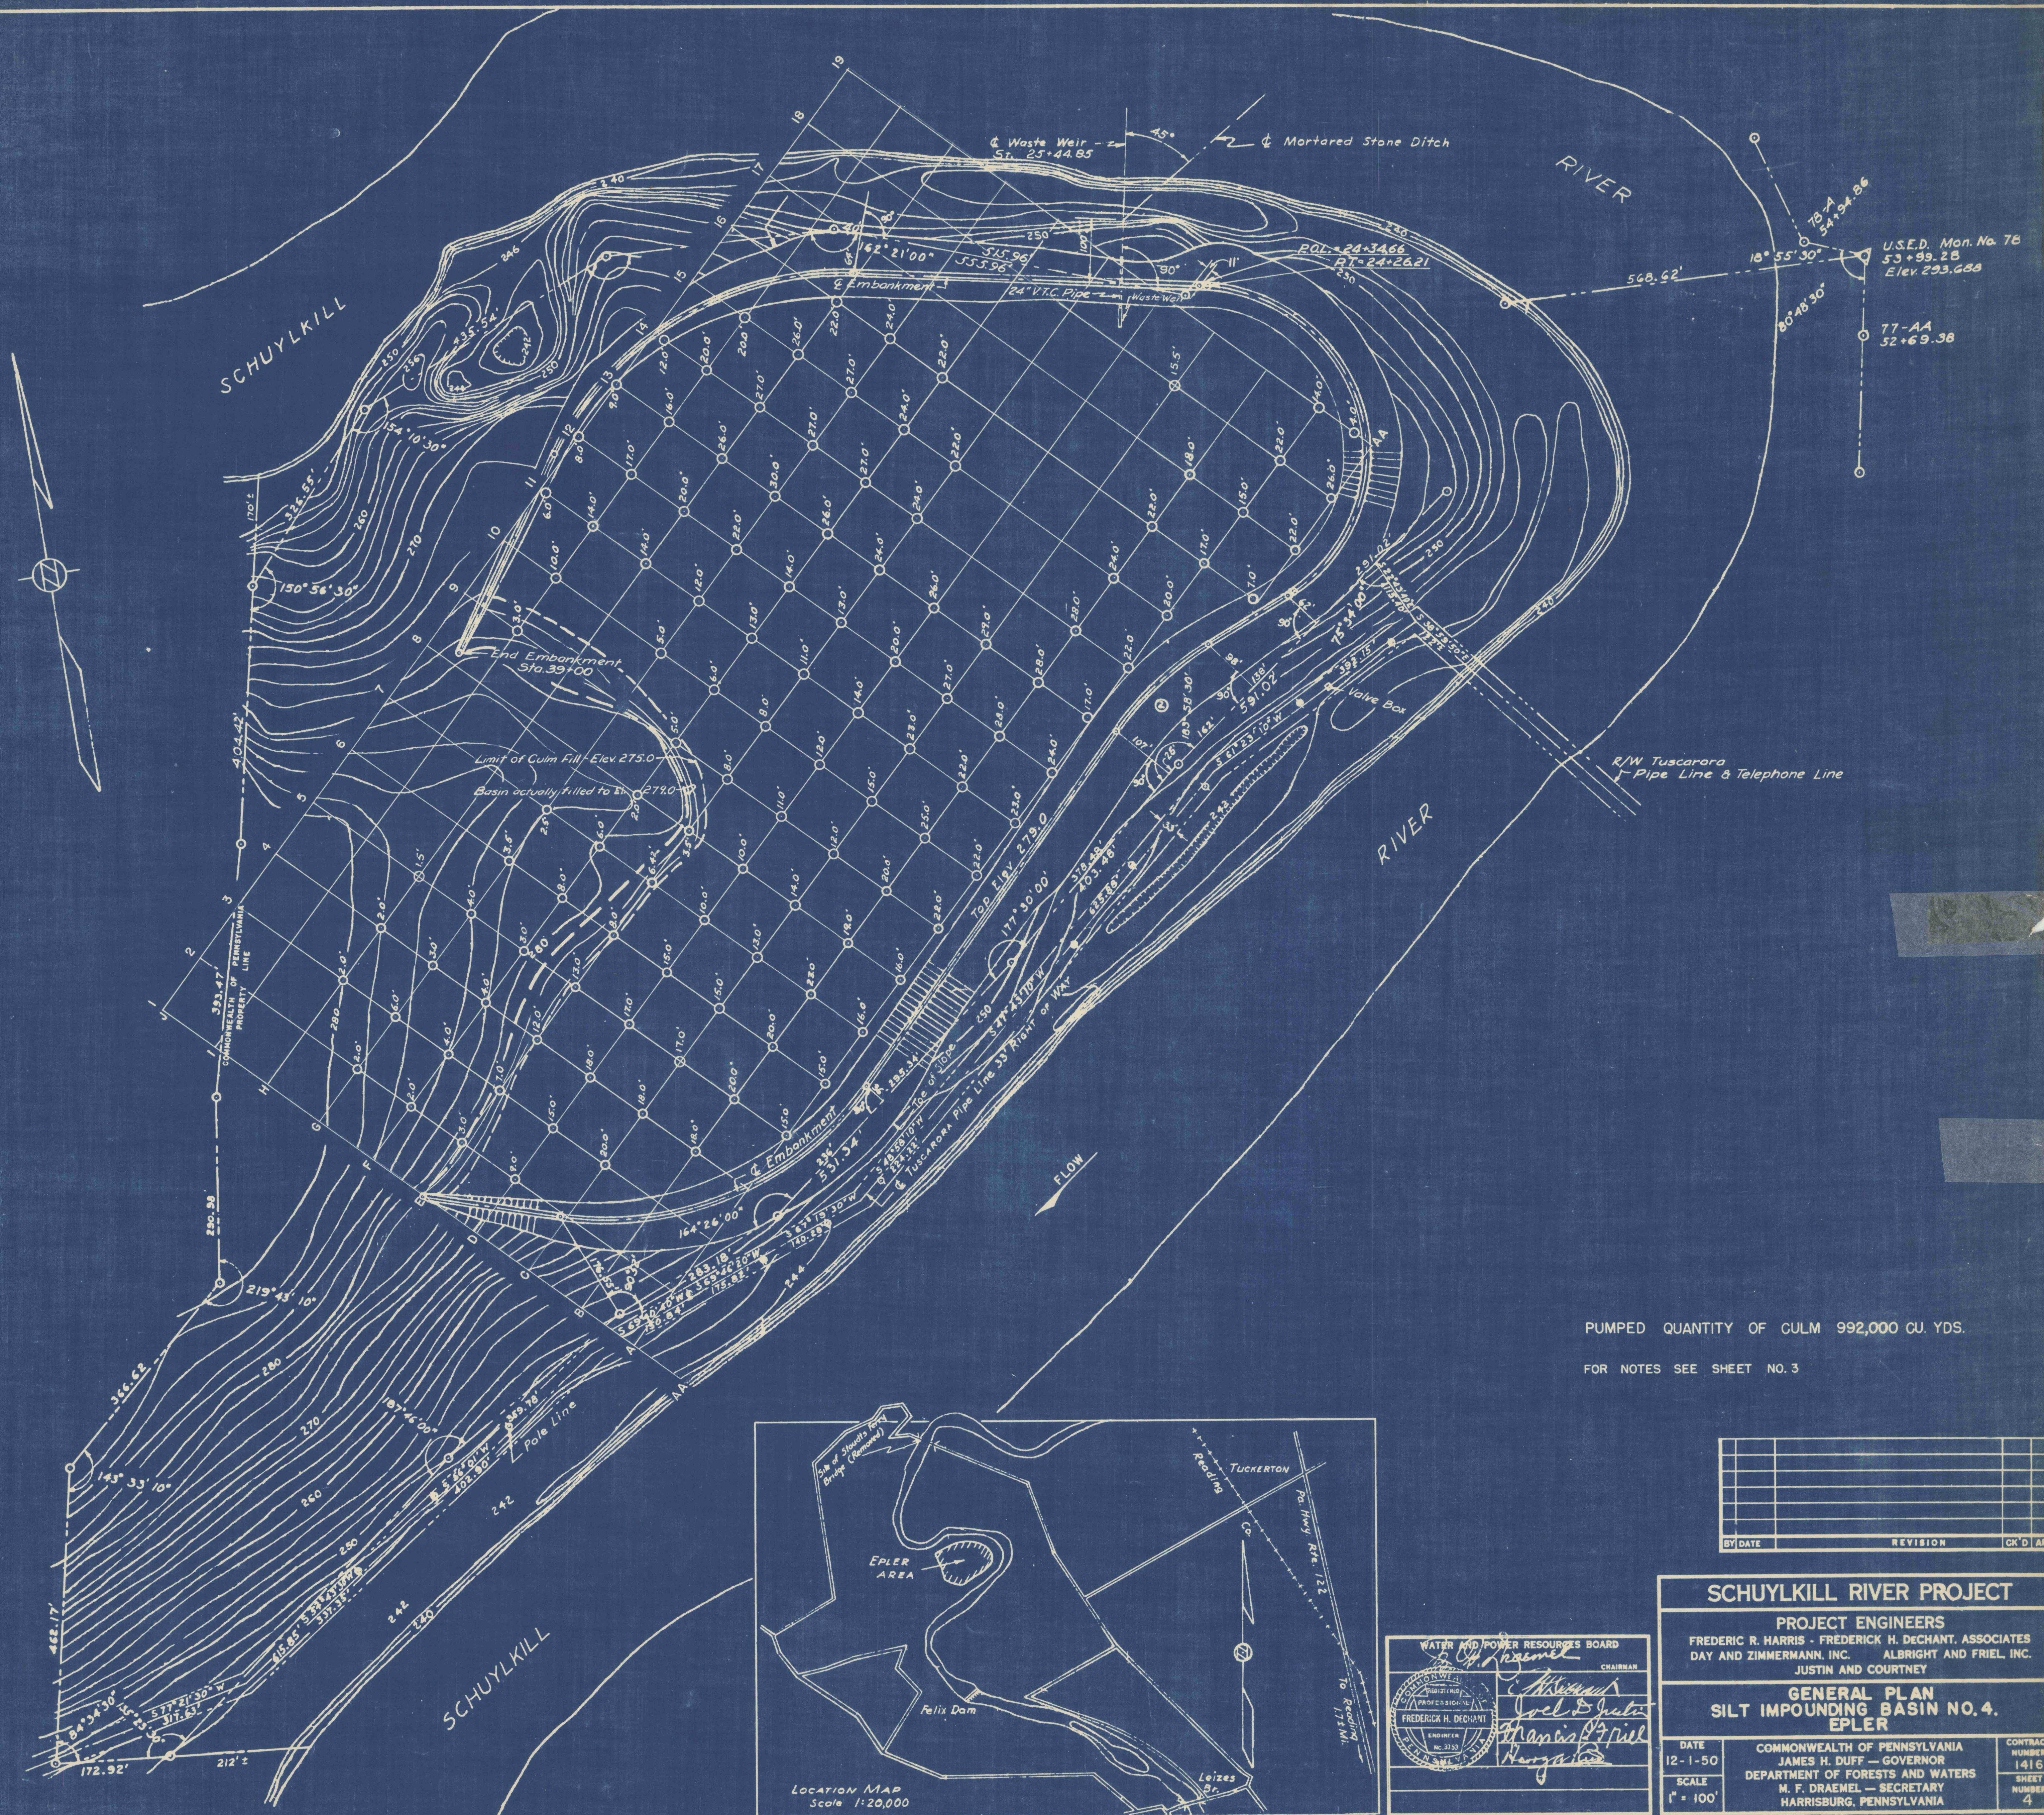

PUMPED QUANTITY OF CULM 992,000 CU. YDS.

FOR NOTES SEE SHEET NO. 3

BY	DATE	REVISION	CHK'D	APP

SCHUYLKILL RIVER PROJECT

PROJECT ENGINEERS
FREDERIC R. HARRIS - FREDERICK H. DECHANT, ASSOCIATES
DAY AND ZIMMERMANN, INC. ALBRIGHT AND FRIEL, INC.
JUSTIN AND COURTNEY

GENERAL PLAN SILT IMPOUNDING BASIN NO. 4. EPLER

DATE 12-1-50	COMMONWEALTH OF PENNSYLVANIA JAMES H. DUFF - GOVERNOR DEPARTMENT OF FORESTS AND WATERS M. F. DRAEMEL - SECRETARY HARRISBURG, PENNSYLVANIA	CONTRACT NUMBER 1416 SHEET NUMBER 4
-----------------	---	--

