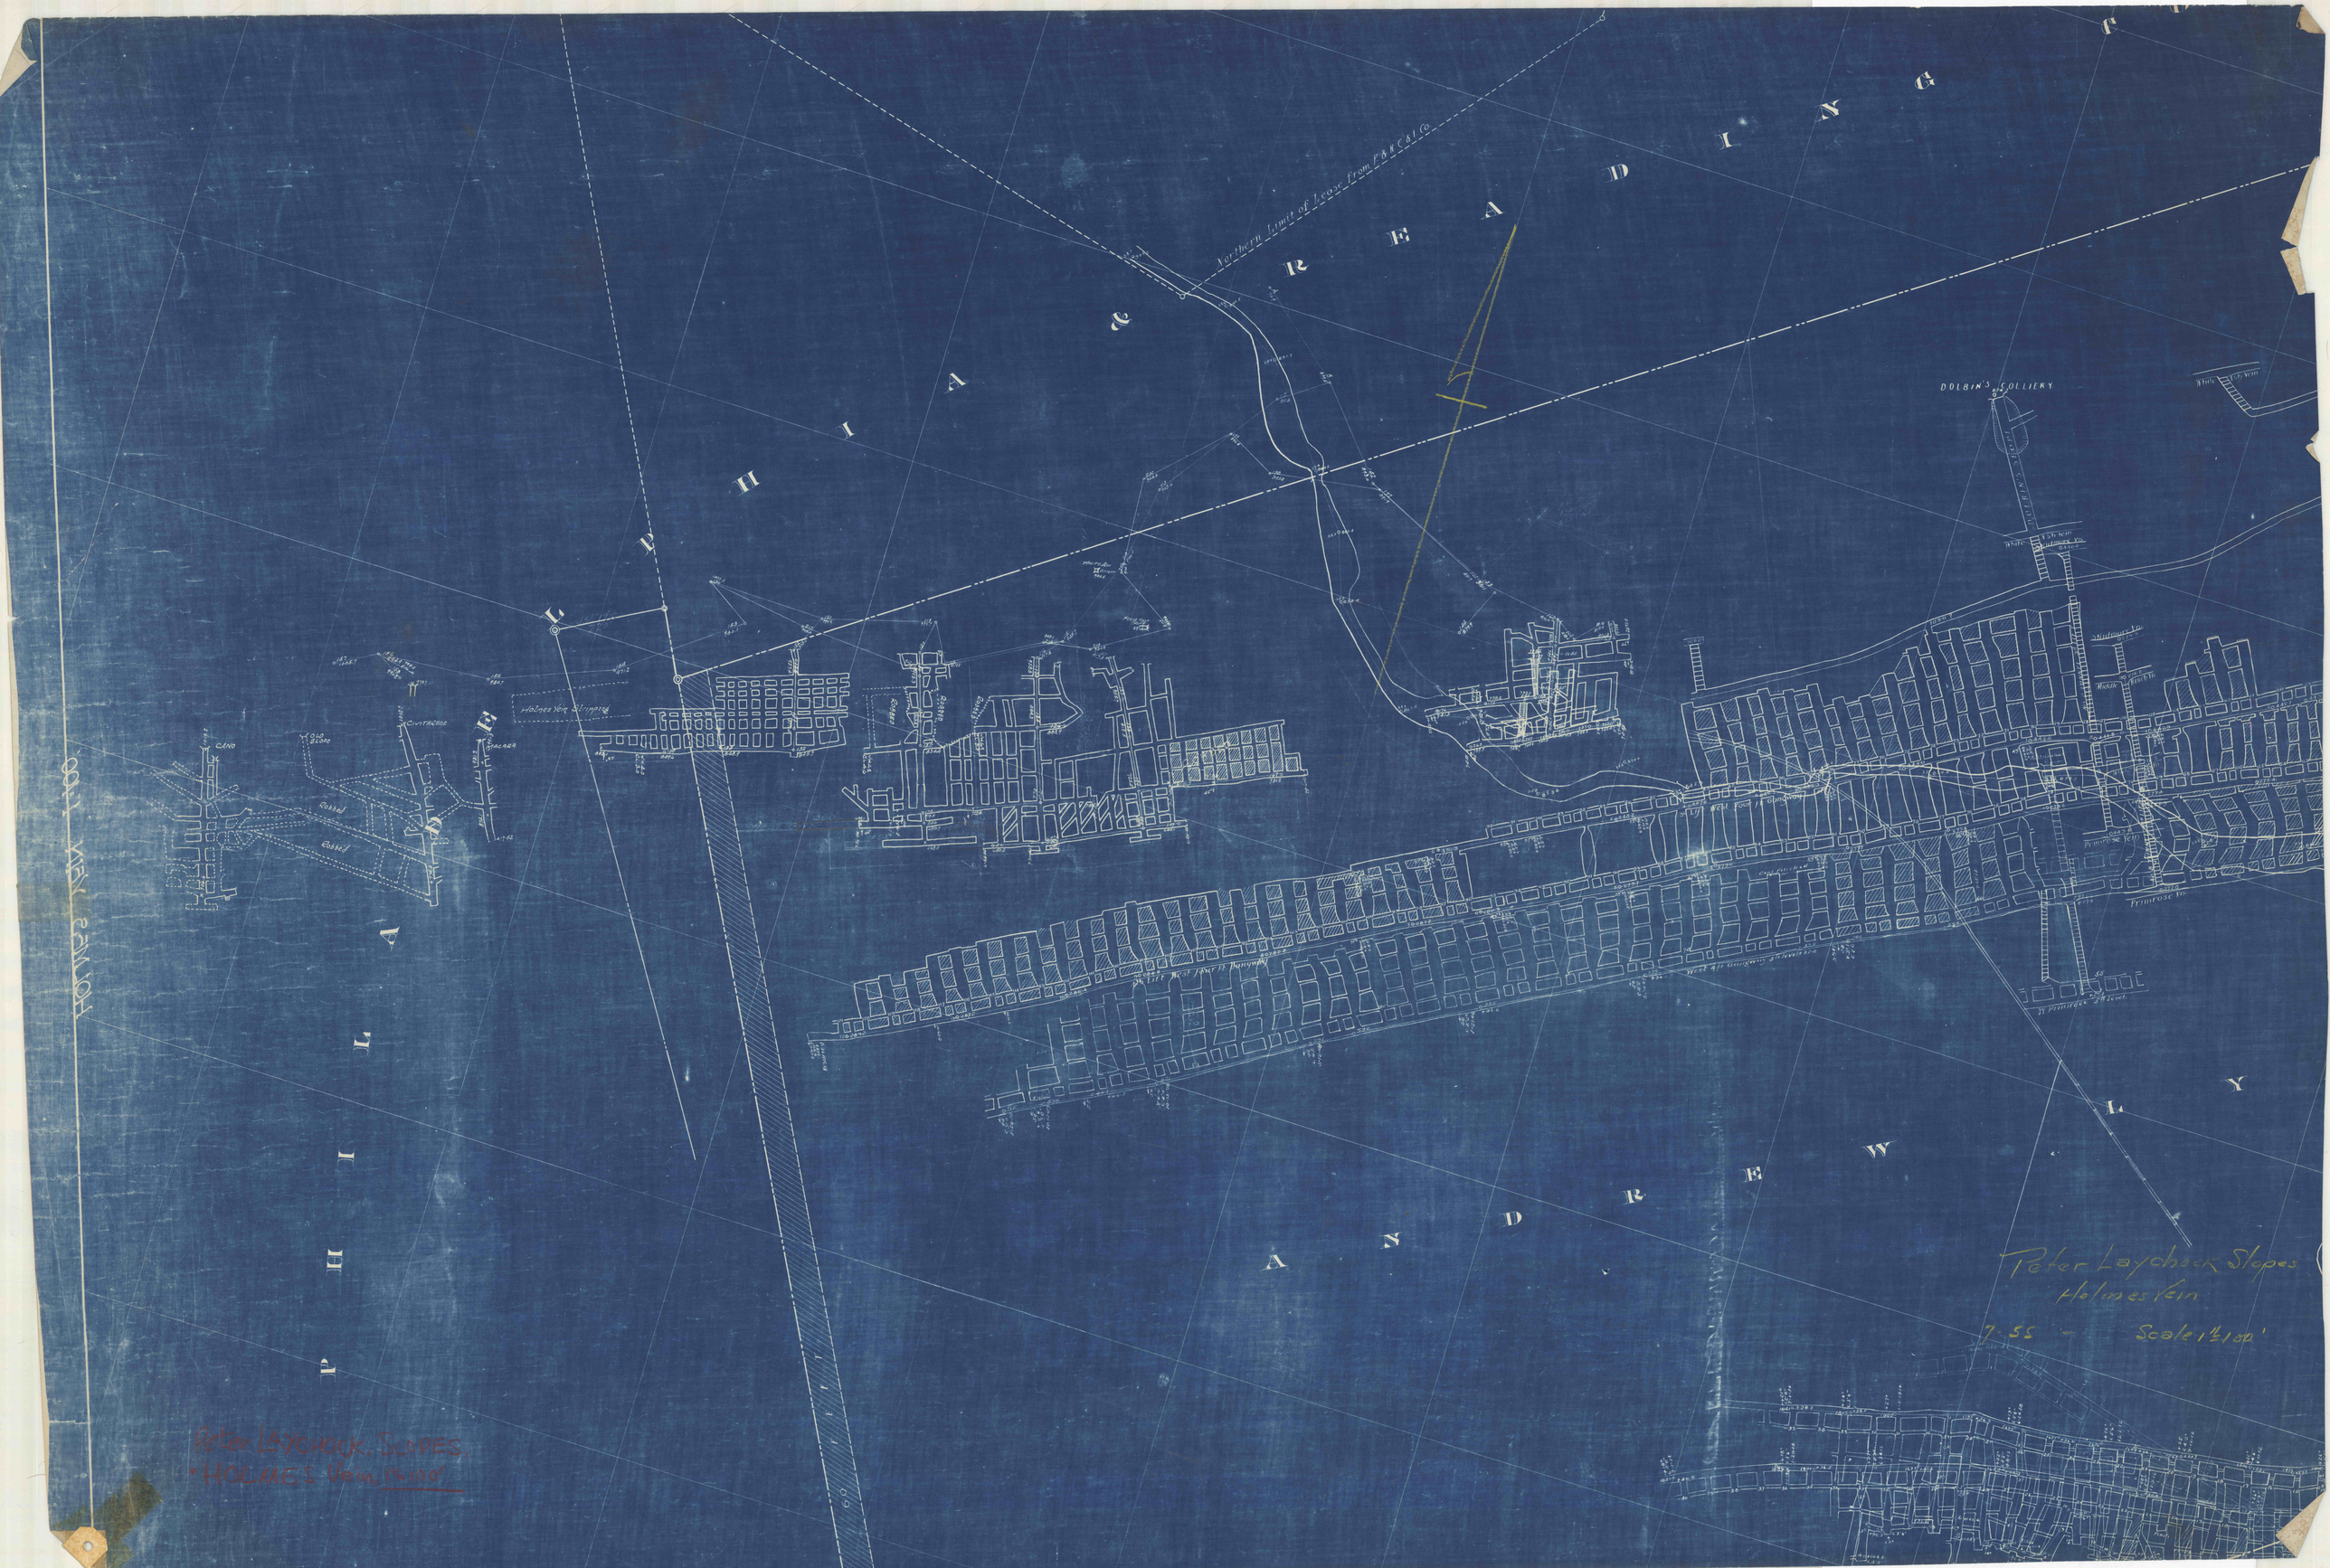
Northern Limit of Lease from P&R Coal Co
DOLBIN'S COLLIERY
Holmes Vein Stripping
Crosscut
Cano
Old Slope
Russel
Russel
Shutdown Inc
Primrose Inc
Primrose Vein
Peter Laychock Slopes
Holmes Vein
7.55
Scale 1½100'
Peter LAYCHOCK. SLOPES.
"HOLMES Vein. 1½100'