


E-1

E-1

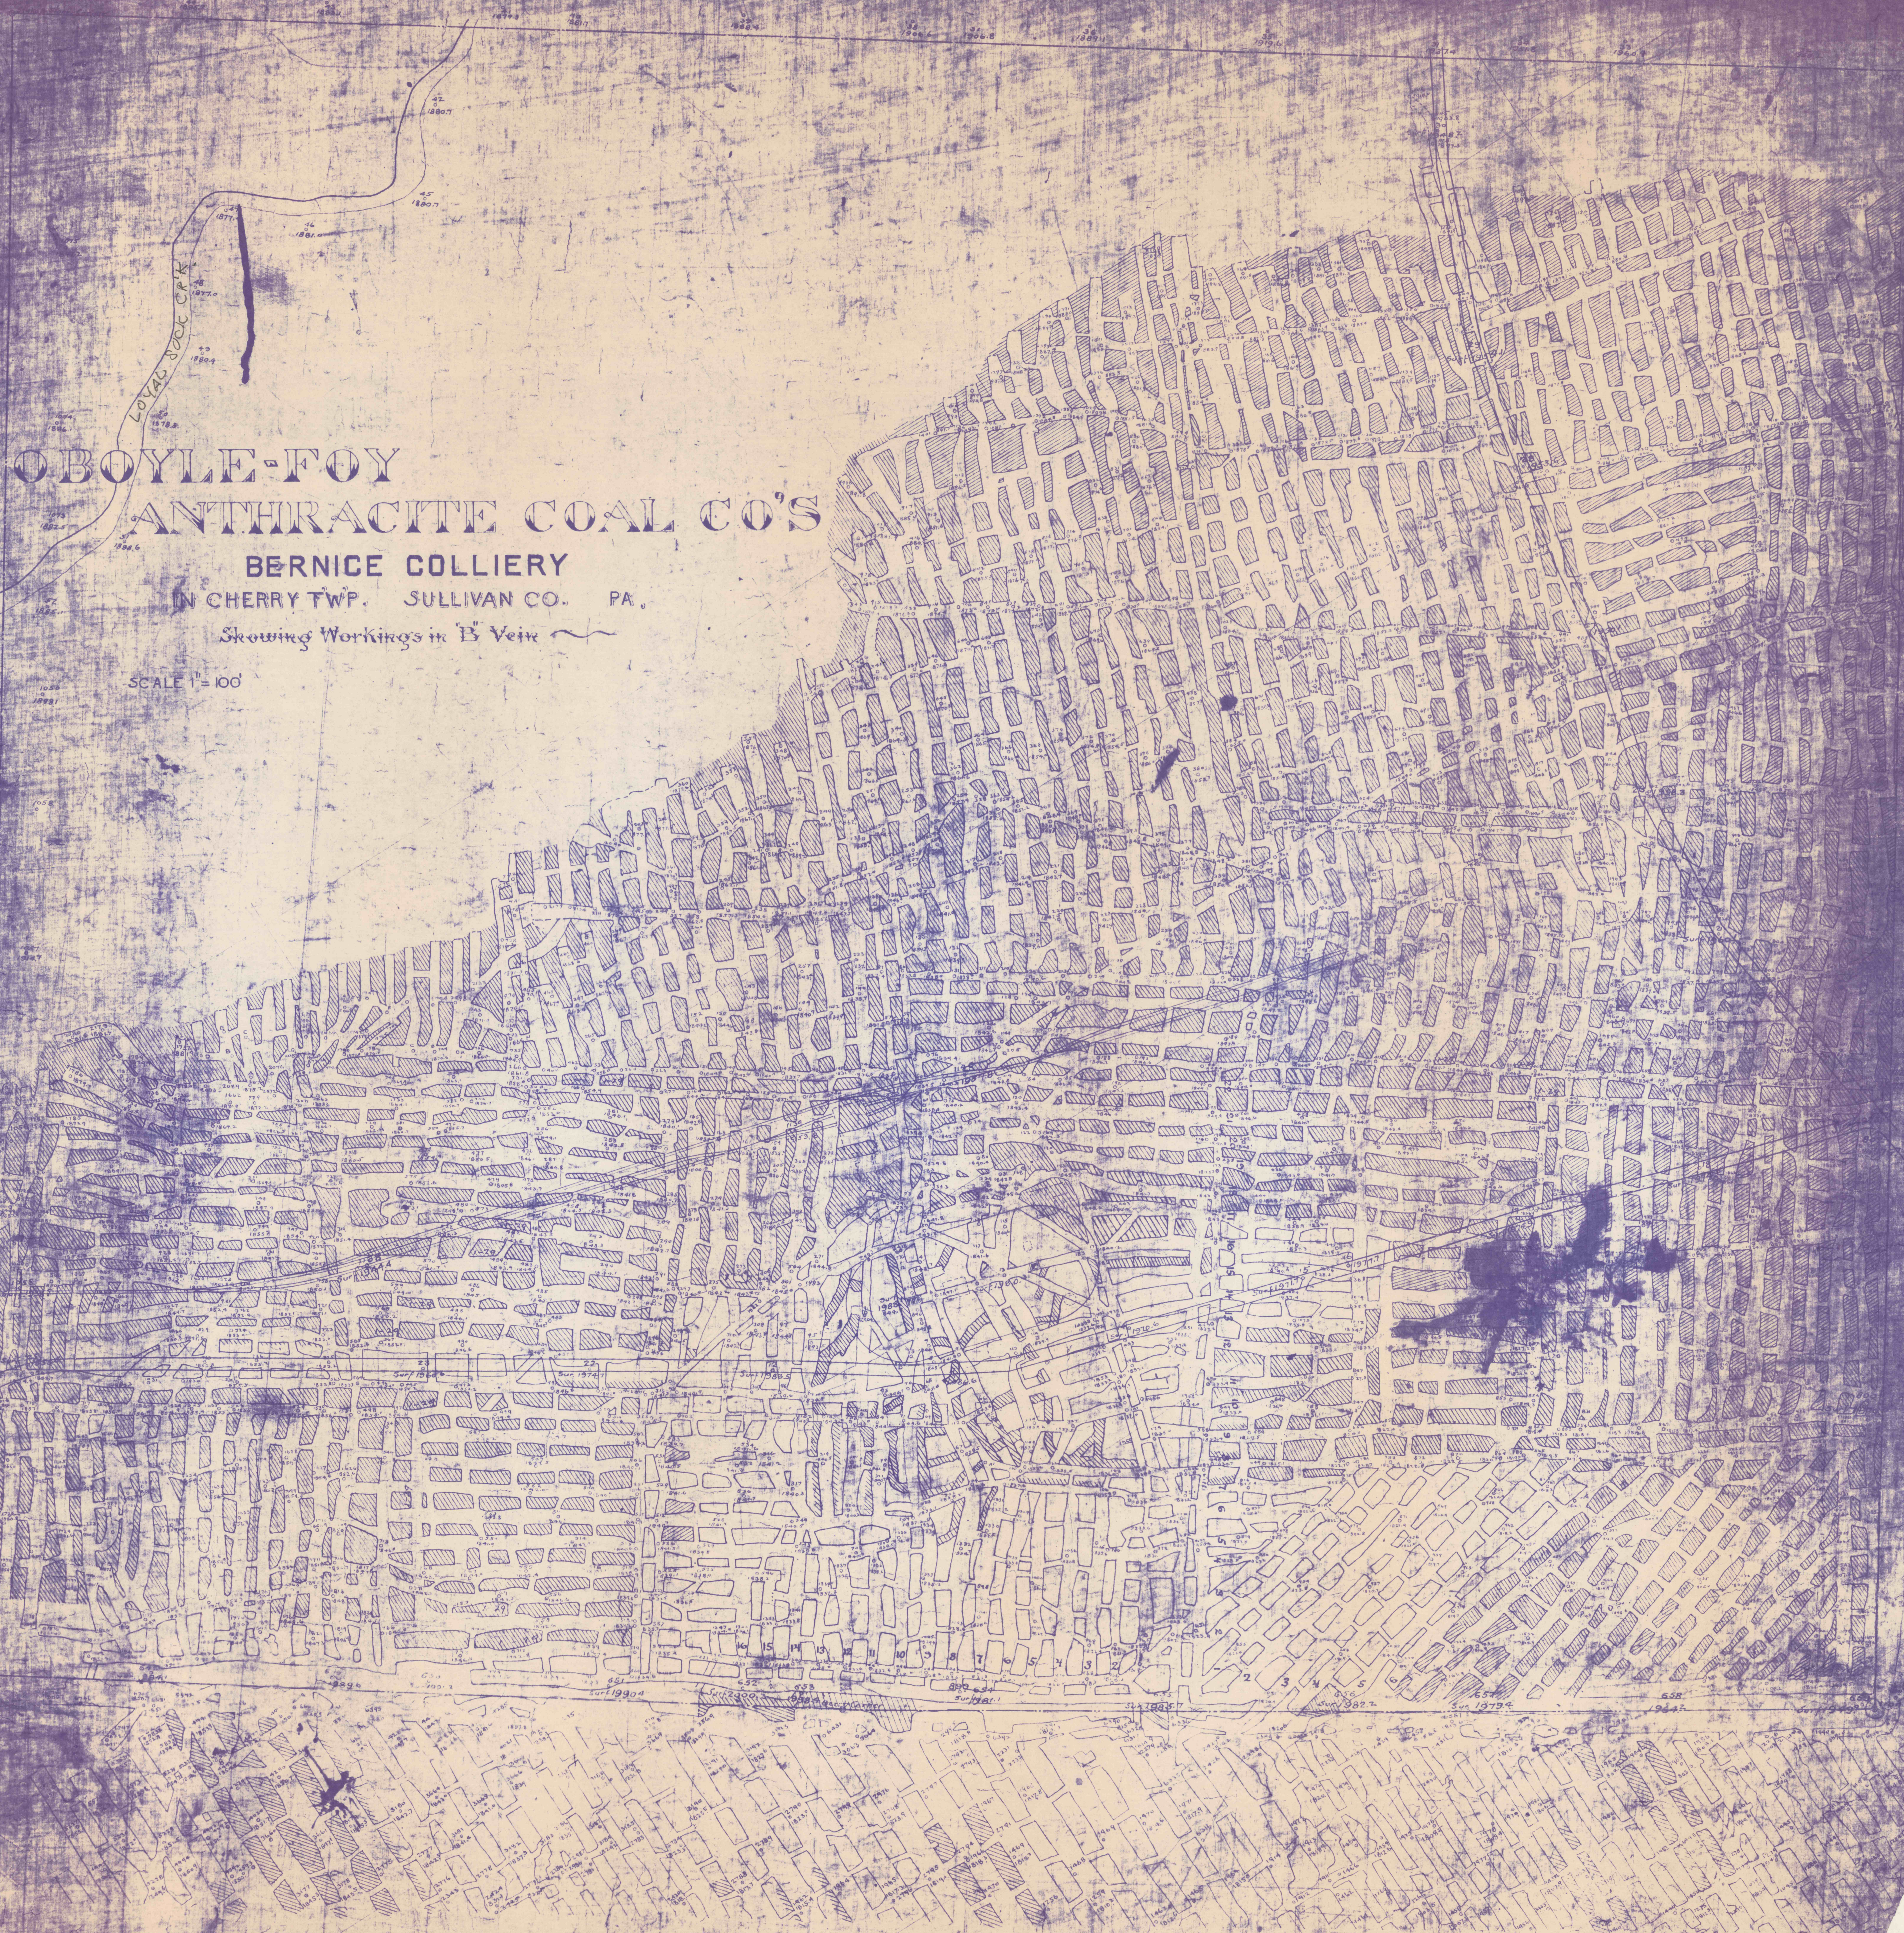

OBOYLE-FOY ANTHRACITE COAL CO'S

BERNICE COLLIERY
IN CHERRY TWP. SULLIVAN CO. PA.

Showing Workings in B Vein

SCALE 1" = 100'