


14-ES-A 2-LEAF COVER

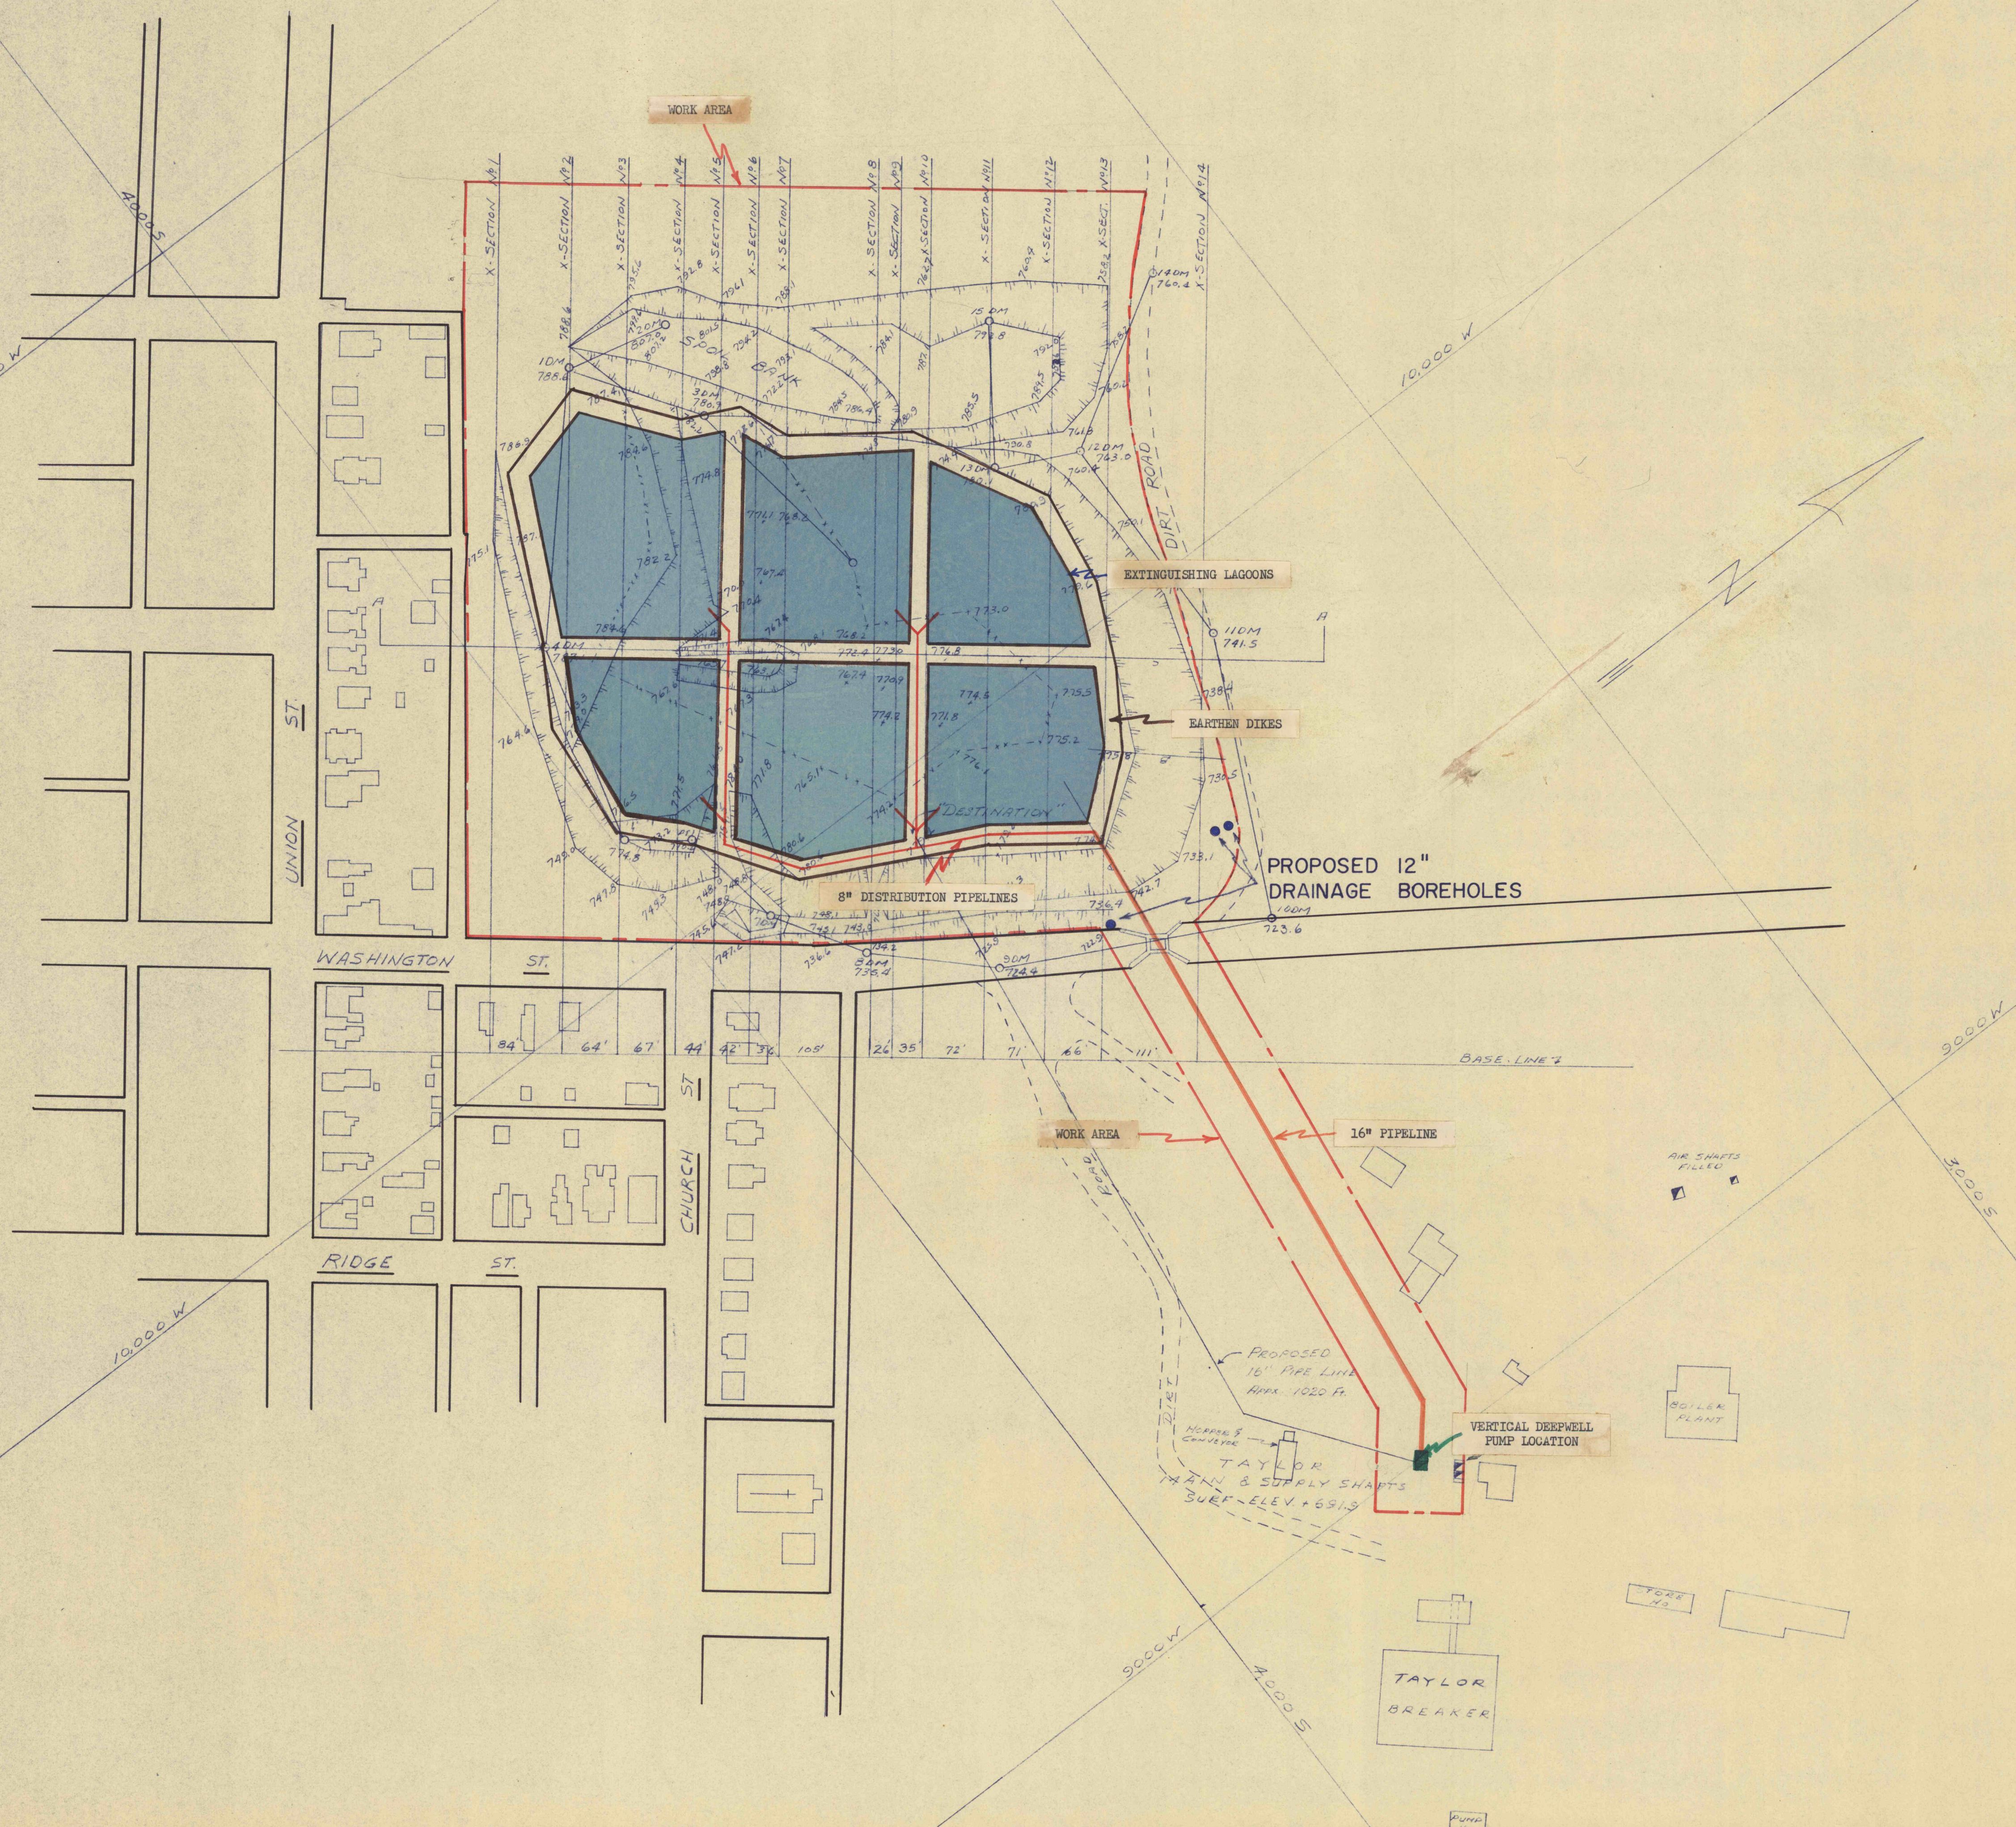

-EXHIBIT A-

"THE LAND AND WATER CONSERVATION
AND RECLAMATION ACT"
AIR POLLUTION ELIMINATION PROJECT NO. SL-203
SURFACE MAP SHOWING
BURNING REFUSE BANK
UNION AND WASHINGTON STREETS
TAYLOR BOROUGH LACKAWANNA COUNTY
PENNSYLVANIA DEPARTMENT OF MINES & MINERAL INDUSTRIES
SCALE 1" = 100'
SEPTEMBER 1968

14-ES-A 2-LEAF COVER