


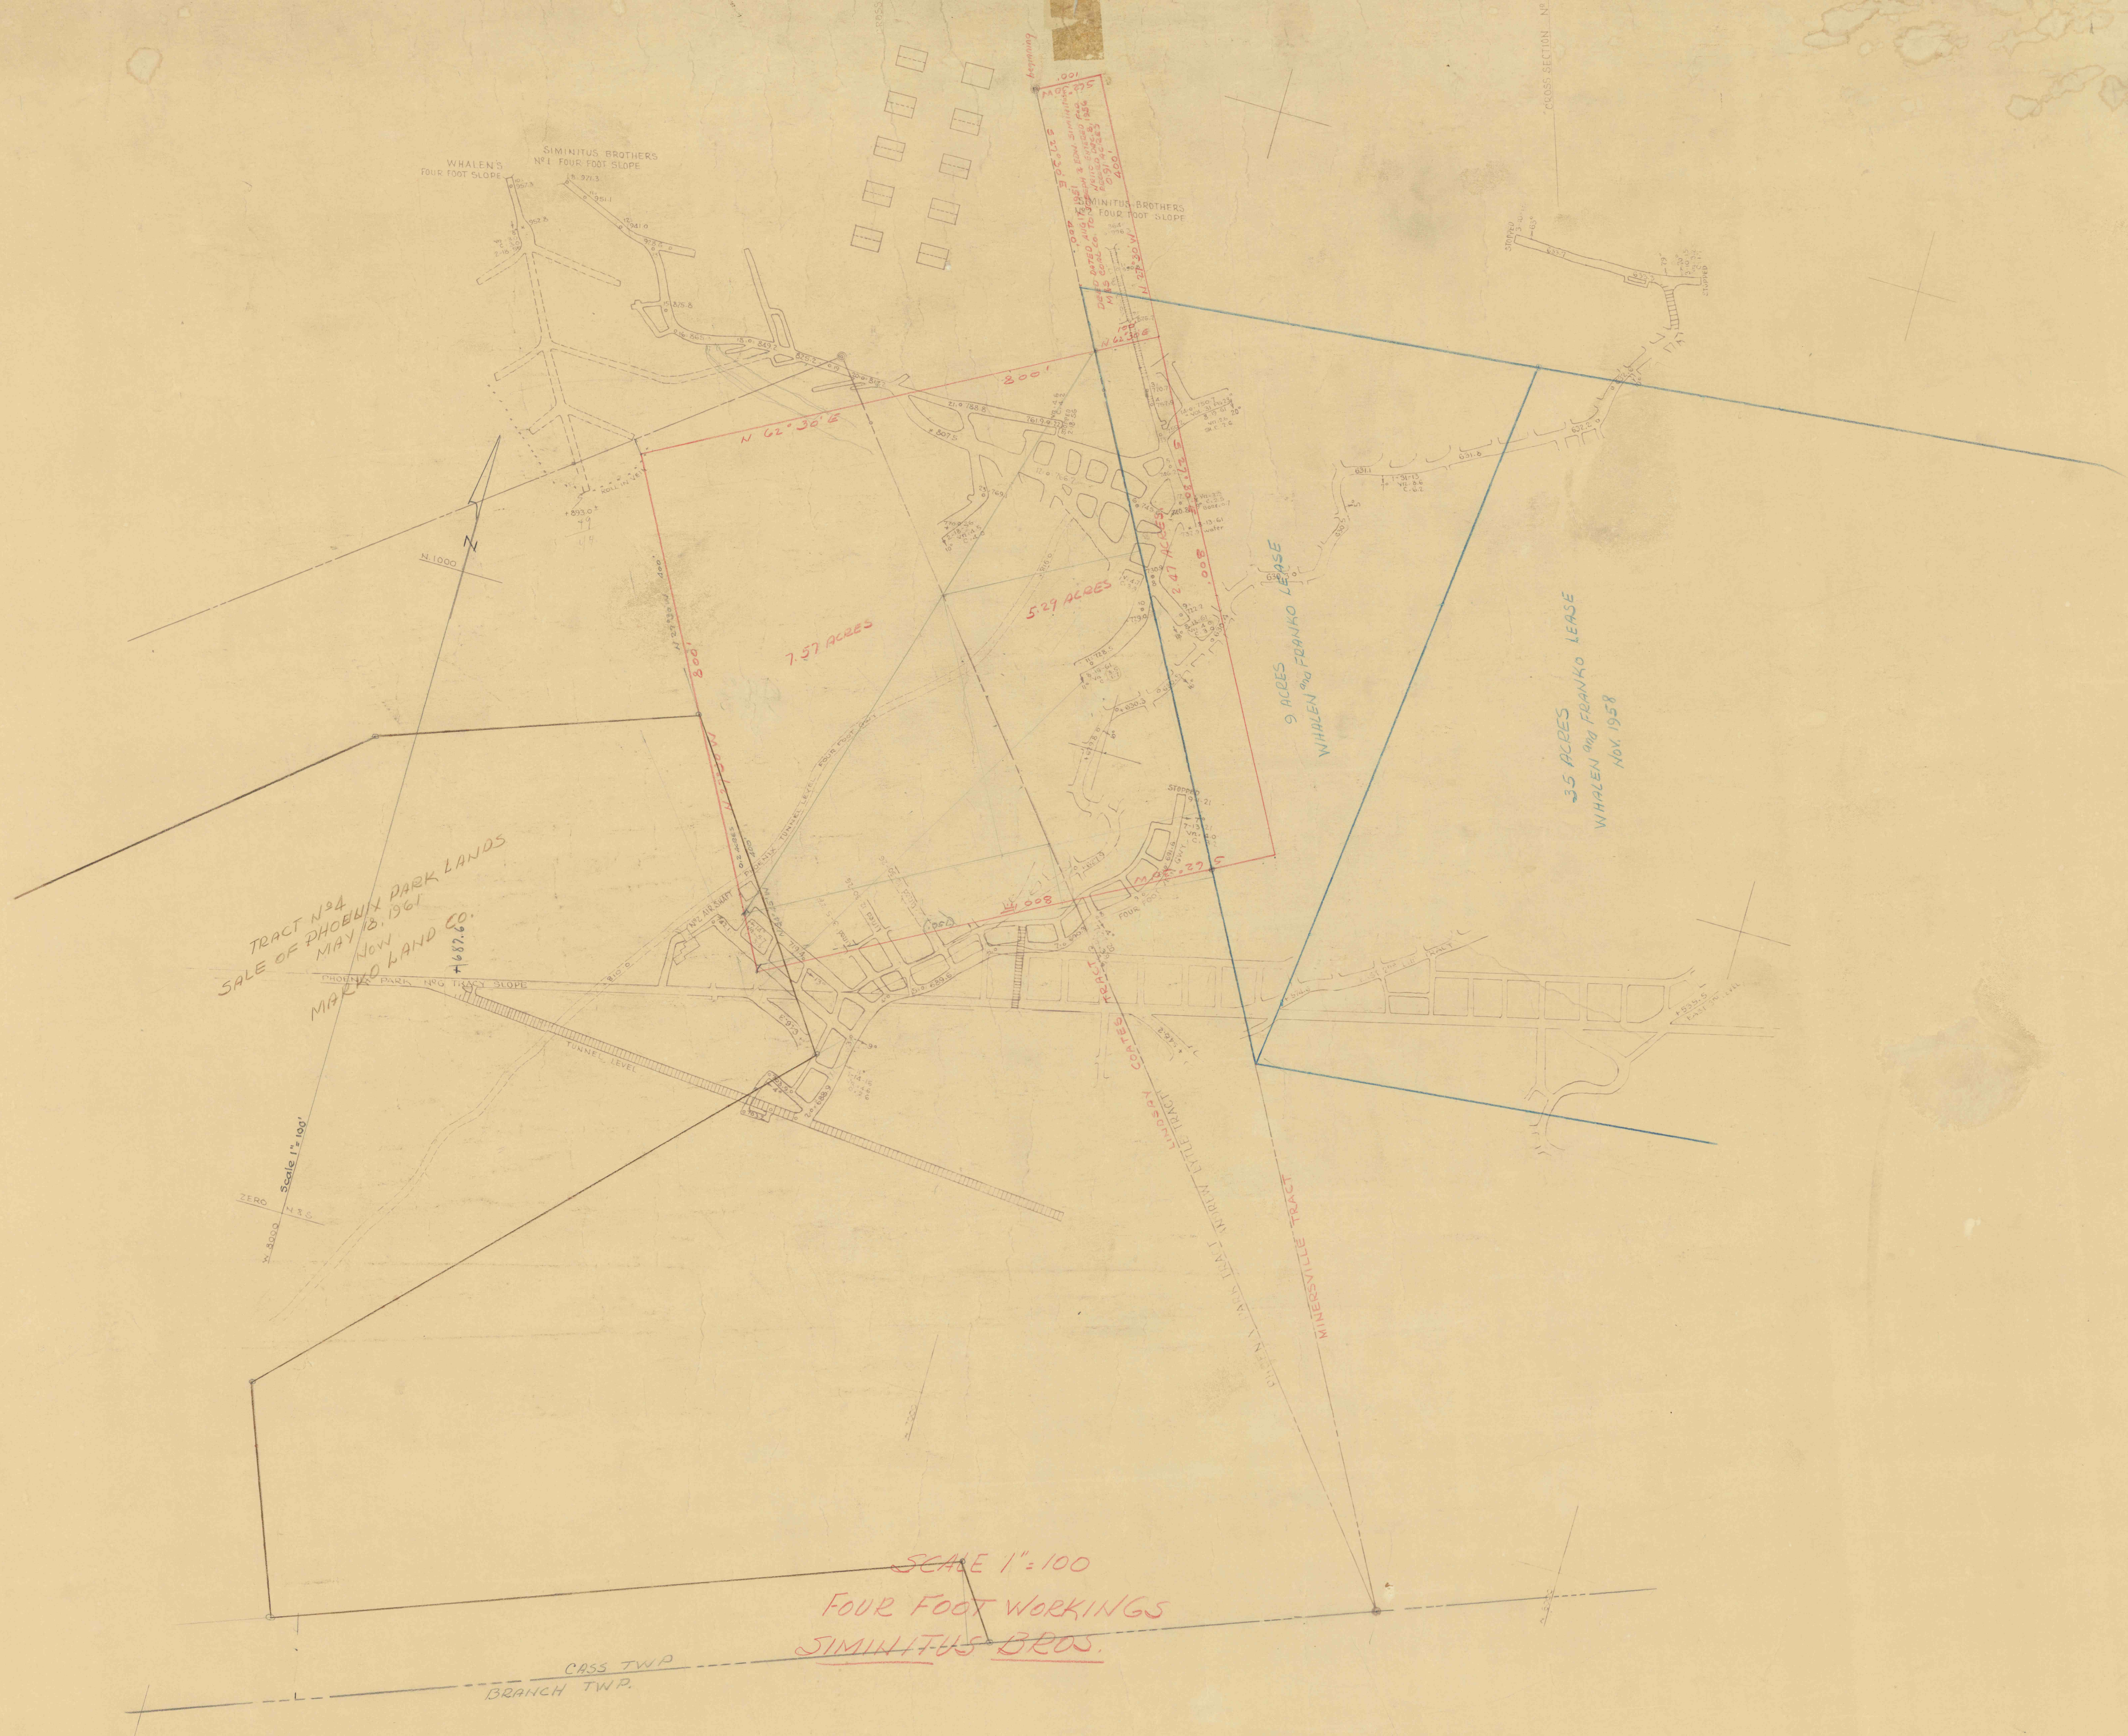

22
400
0.008/0.000