


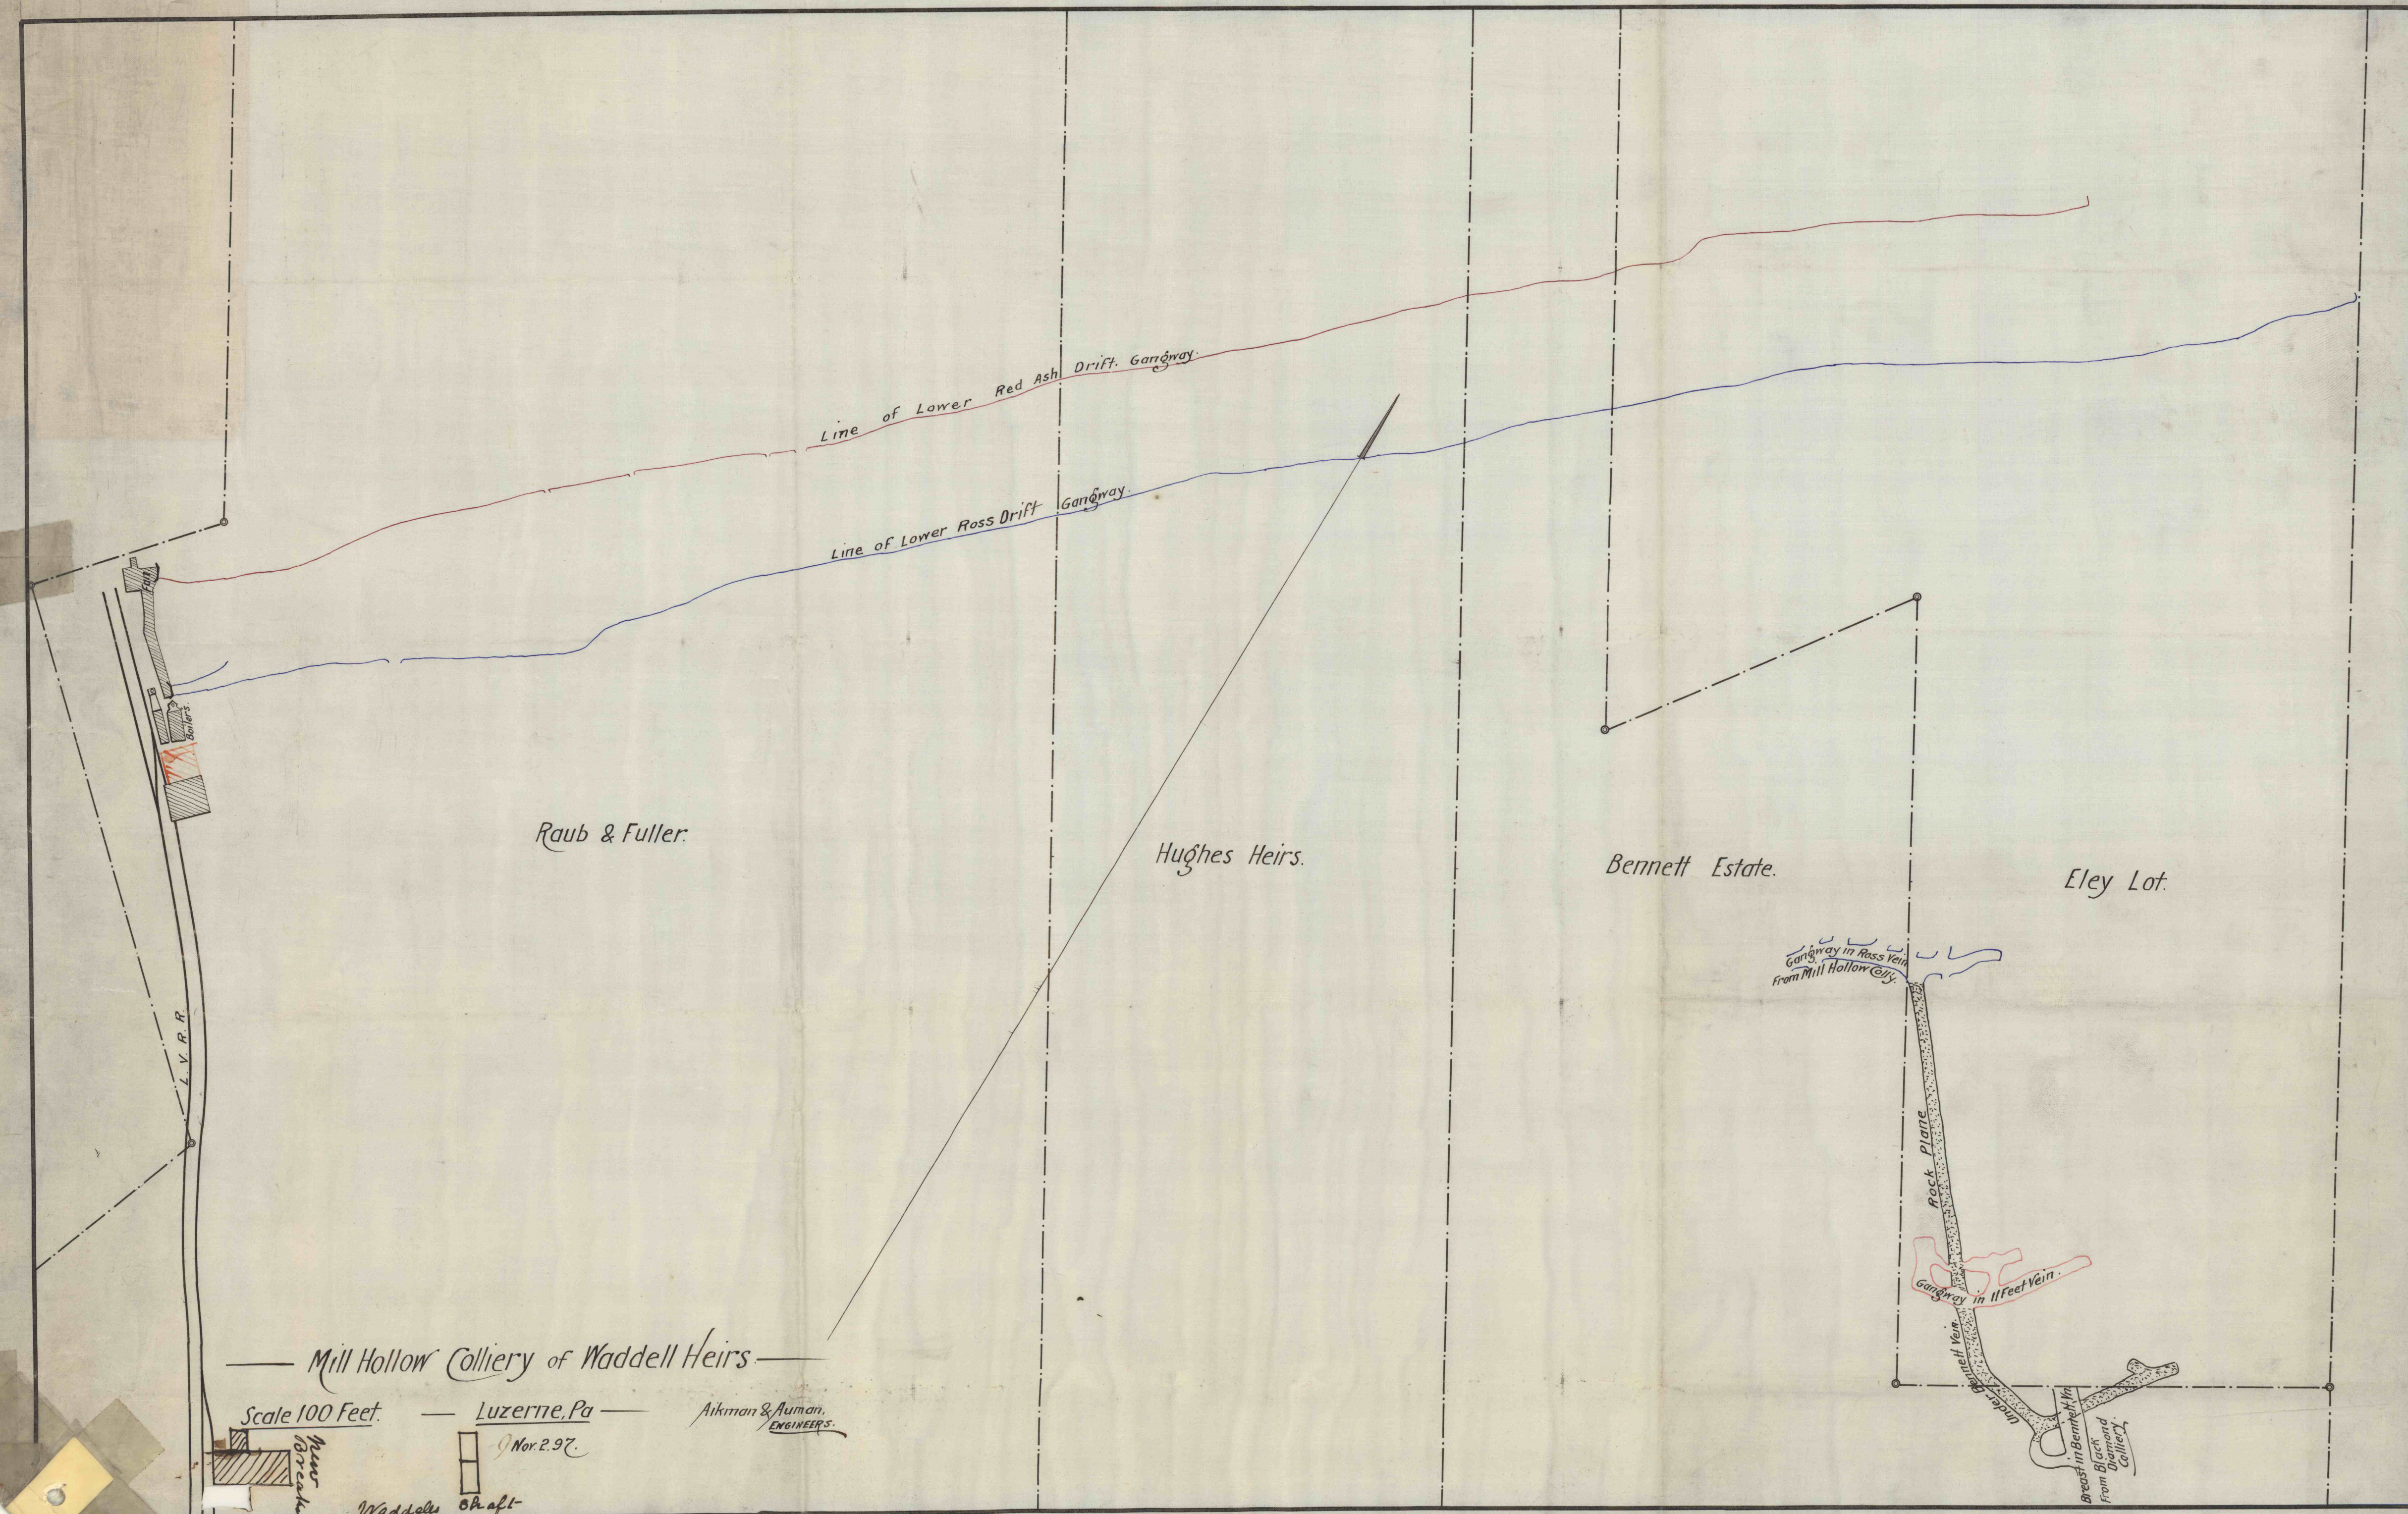

Line of Lower Red Ash Drift Gangway

Line of Lower Ross Drift Gangway

Raub & Fuller

Hughes Heirs

Bennett Estate

Eley Lot

— Mill Hollow Colliery of Waddell Heirs —

Scale 100 Feet

— Luzerne, Pa —

Aikman & Auman,
ENGINEERS

Nov. 2. 97

New Breaker

Waddell's Shaft

Gangway in Ross Vein
From Mill Hollow Colly

Rock Plane

Gangway in 11 Feet Vein

Bennett Vein

Breach in Bennett Vein
From Black Diamond Colliery