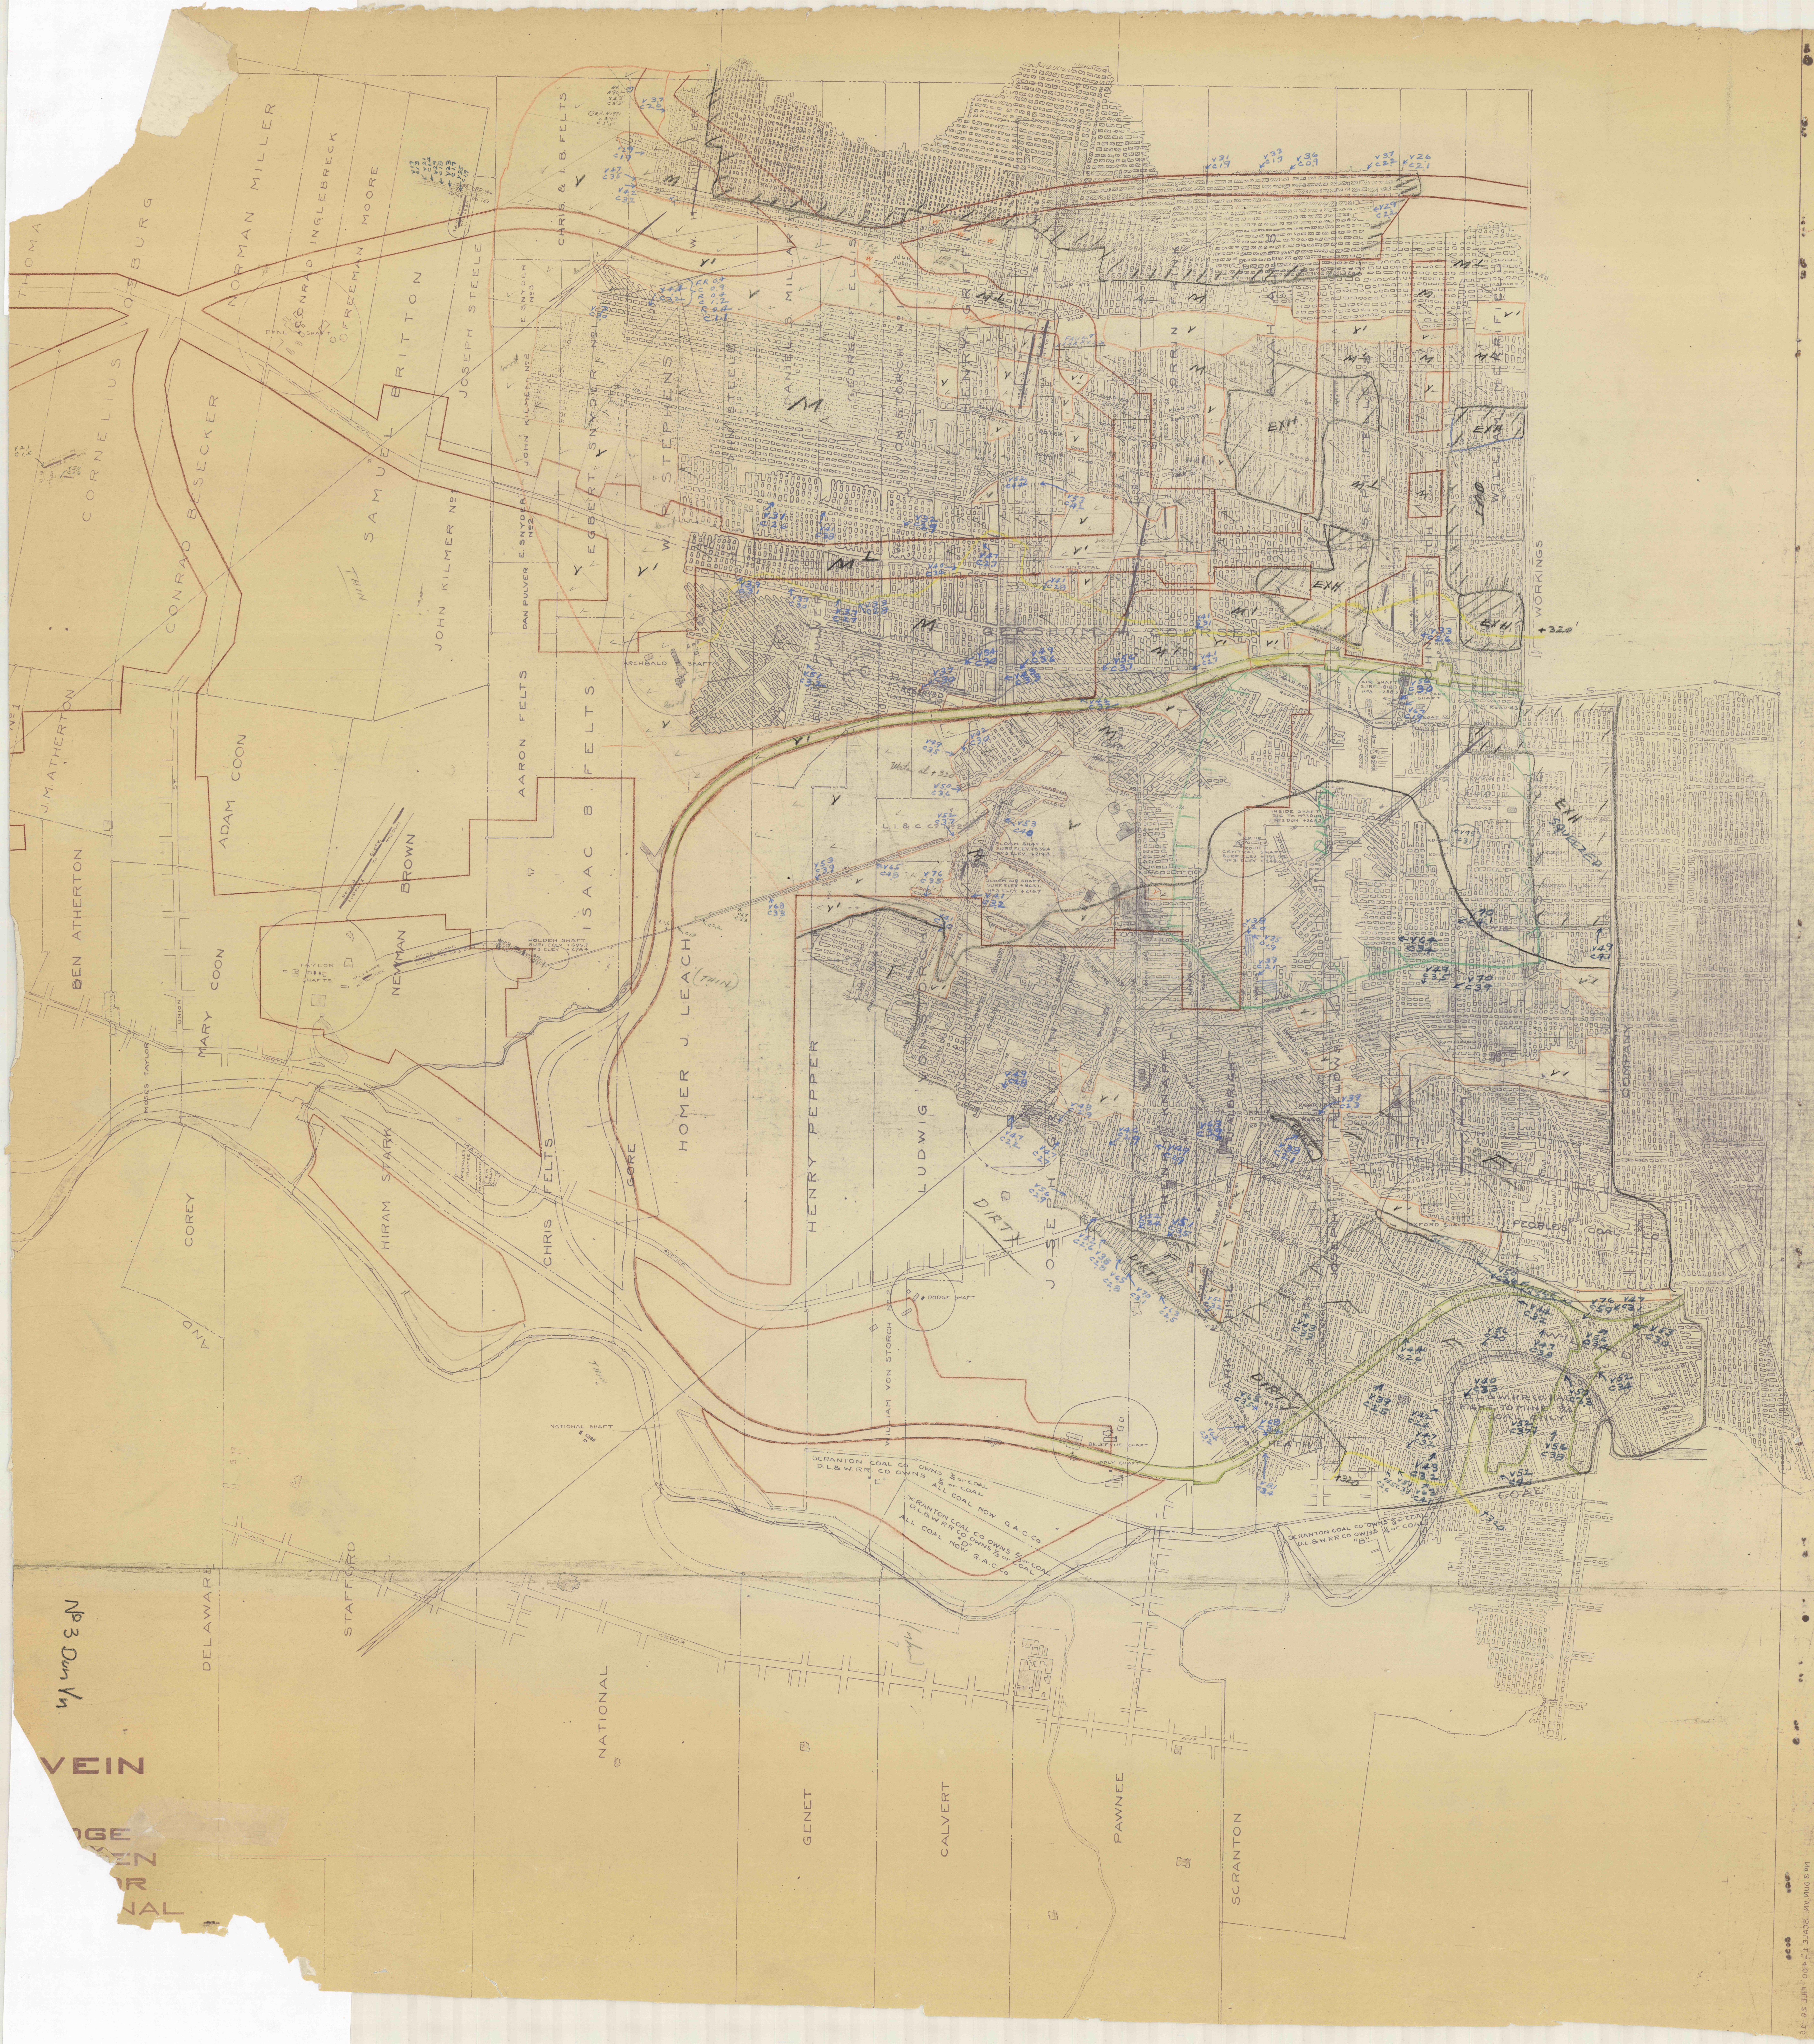
THOMA
CORNELIUS OSBURG
NORMAN MILLER
CONRAD INGLEBRECK
FREEMAN MOORE
CONRAD BESECKER
SAMUEL BRITTON
JOHN KILMER No 1
JOSEPH STEELE
E. SNYDER No 3
CHRIS & I. B. FELTS
JOHN KILMER No 2
EGBERT SNYDER No 1
E. SNYDER No 2
DAN PULVER
W. STEPHENS
ANTHONY STEELE
DANIEL S. MILLAR
GEORGE ELLIS
VON STORCH No 1
HENRY GRIFFIN
ORRIN
ABRAHAM
JOSEPH FELLOWS
JOHN SMITH
WILLIAM MERRIFIELD
WORKINGS
PYNE SHAFT
ARCHBALD SHAFT
GERSHOM M. COURSEN
CONTINENTAL SHAFT
AIR SHAFT SURF +818.3 No 3 +288.3
HYDE PARK SHAFT
Water at +320
WATER +350
FAULT
EXH.
EXH. SQUEEZED
+320'
J. M. ATHERTON
BEN ATHERTON
ADAM COON
MARY COON
AARON FELTS
ISAAC B. FELTS
NEWMAN BROWN
TAYLOR SHAFTS
No 24 SLOPE SURFACE TO No 2 DUN
No 10 B SLOPE CLARK TO No 3 DUN
HOLDEN SHAFT SURF. ELEV +696.7 No 3 ELEV +278.4
HOMER J. LEACH (THIN)
HENRY PEPPER
LUDWIG VON STORCH
L. I. & C. Co.
SLOAN SHAFT SURF. ELEV +839.4 No 3 ELEV +219.3
SLOAN AIR SHAFT SURF. ELEV +863.1 No 3 ELEV +215.7
CENTRAL SHAFT SURF. ELEV +799.9 No 3 ELEV +248.6
INSIDE SHAFT BIG TO No 3 DUN No 3 DUN +243.7
JOSEPH FELLOWS
HENRY KNAPP
ALBRIGHT
COMPANY
OXFORD SHAFT
PEOPLES COAL CO.
DIRTY
PARK HILL
HEATH
D. L. & W. R.R. CO. HAS RIGHT TO MINE 3/4 COAL
GOAL
+320
COREY
AND
HIRAM STARK
CHRIS FELTS
GORE
MOSES TAYLOR
NORTH
MAIN
AVENUE
UNION ST.
DODGE SHAFT
WILLIAM VON STORCH No 2
BELLEVUE SHAFT
SUPPLY SHAFT
NATIONAL SHAFT
SCRANTON COAL CO OWNS 3/4 OF COAL D.L.& W.R.R. CO OWNS 1/4 OF COAL "E" ALL COAL NOW G.A.C. Co
SCRANTON COAL CO OWNS 2/3 OF COAL D.L.& W.R.R. CO OWNS 1/3 OF COAL "D" ALL COAL NOW G.A.C. Co
SCRANTON COAL CO OWNS 3/4 OF COAL D.L.& W.R.R. CO OWNS 1/4 OF COAL "B"
DELAWARE
STAFFORD
MAIN AVE
CEDAR
NATIONAL
GENET
CALVERT
PAWNEE
SCRANTON
ELM ST
AVE
THIN
Good
out
Y
Y'
M
M'
Y 3.1 C 2.0
Y 29 C 1.9
Y 47 C 3.5
Y 42 C 3.2
Y 31 C 1.9
Y 33 C 1.7
Y 36 C 0.9
Y 37 C 2.2
Y 26 C 2.1
Y 29 C 2.2
Y 41 C 3.1
Y 41 C 2.7
Y 49 C 3.5
Y 50 C 3.6
Y 53 C 4.8
Y 65 C 4.8
Y 76 C 3.5
Y 70 C 3.9
Y 49 C 4.1
Y 95 C 3.1
Y 39 C 1.3
Y 81 C 3.4

No 3 Dun Vn

VEIN

DGE
EN
OR
NAL