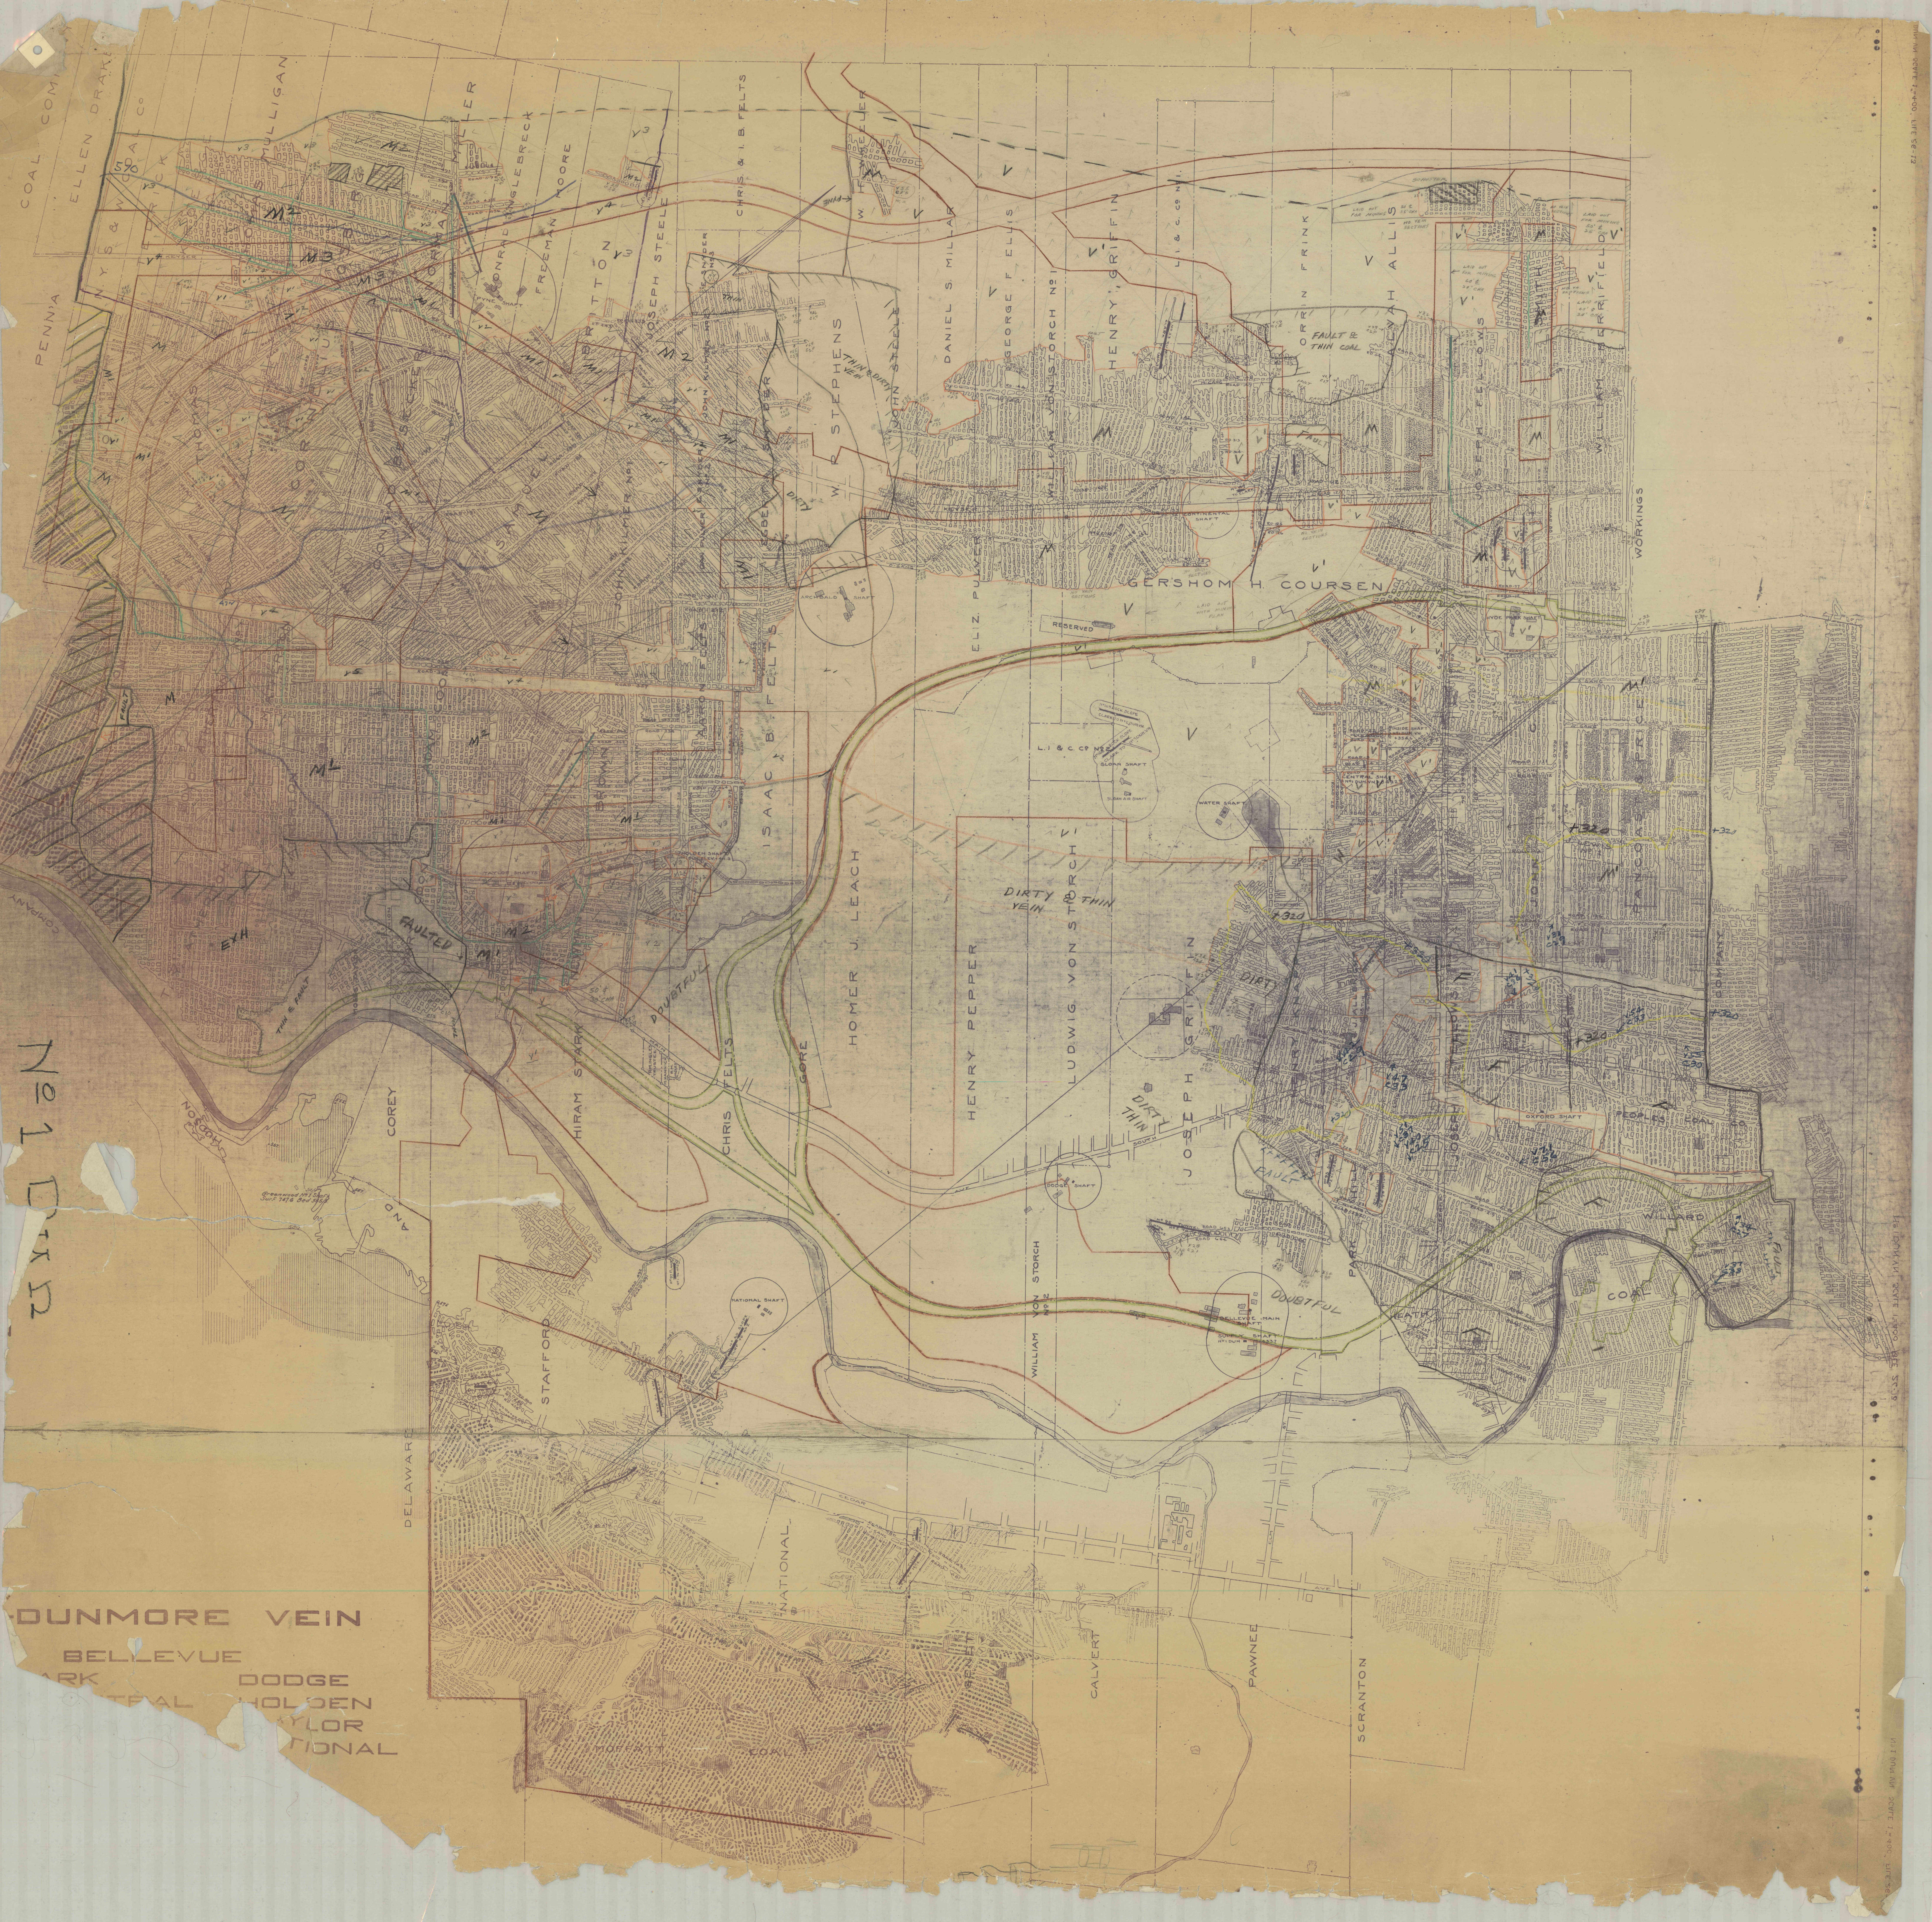
PENN'A COAL COMPANY
ELLEN DRAKE
N.Y. S. & W. COAL Co
MULLIGAN
MILLER
CONRAD ENGLEBRECK
FREEMAN MOORE
BRITTON
JOSEPH STEELE
CHRIS & I. B. FELTS
JOHN SNYDER No 3
W. H. WHEELER
PYNE SHAFT
W. P. STEPHENS
THIN & DIRTY VEIN
JOHN STEELE
DANIEL S. MILLAR
GEORGE F. ELLIS
WILLIAM VON STORCH No 1
HENRY GRIFFIN
L. I. & C. Co No 1
ORRIN FRINK
ALVAH ALLIS
FAULT & THIN COAL
JOSEPH FELLOWS
SMITH
WILLIAM MERRIFIELD
LAID OUT FOR MINING
NO VEIN SECTIONS
SCHUSTER
FAULT
WORKINGS
CONTINENTAL SHAFT
GERSHOM H. COURSEN
ELIZ. PULVER
RESERVED
ARCHBALD SHAFT
EGBERT SNYDER
JOHN KILMER No 2
DIRTY
ISAAC B. FELTS
HYDE PARK SHAFT
INSIDE SHAFT
CENTRAL SHAFT
L. I. & C. Co No 2
SLOAN SHAFT
SLOAN AIR SHAFT
WATER SHAFT
DOUBTFUL
DIRTY & THIN VEIN
HOMER J. LEACH
HENRY PEPPER
LUDWIG VON STORCH
JOSEPH GRIFFIN
JOHN KILMER No 1
SAMUEL
CORNELIUS
THOMAS
TAYLOR SHAFTS
HOLDEN SHAFT
FAULTED
EXH
THIN & FAULT
BROWN
COREY
HIRAM STARK
CHRIS FELTS
GORE
DIRTY THIN
SOUTH MAIN AVE
DODGE SHAFT
NATIONAL SHAFT
WILLIAM VON STORCH No 2
BELLEVUE MAIN SHAFT
SUPPLY SHAFT
HUDSON COMPANY
DELAWARE AND HUDSON
Greenwood No 1 Shaft Surf. 747.6 Bed 565.8
STAFFORD
NATIONAL
CEDAR
CALVERT
PAWNEE
SCRANTON
ELM
MOFFATT COAL Co
OXFORD SHAFT
PEOPLES COAL CO
WILLARD
PARK
JOHN PRICE
HANCOCK
COMPANY
COAL
+320
KEYSER

# DUNMORE VEIN

BELLEVUE
ARK DODGE
TRAL HOLDEN
YLOR
TIONAL

No 1 Dun

No 1 DUN VN SCALE 1"=400' FILE 32-13