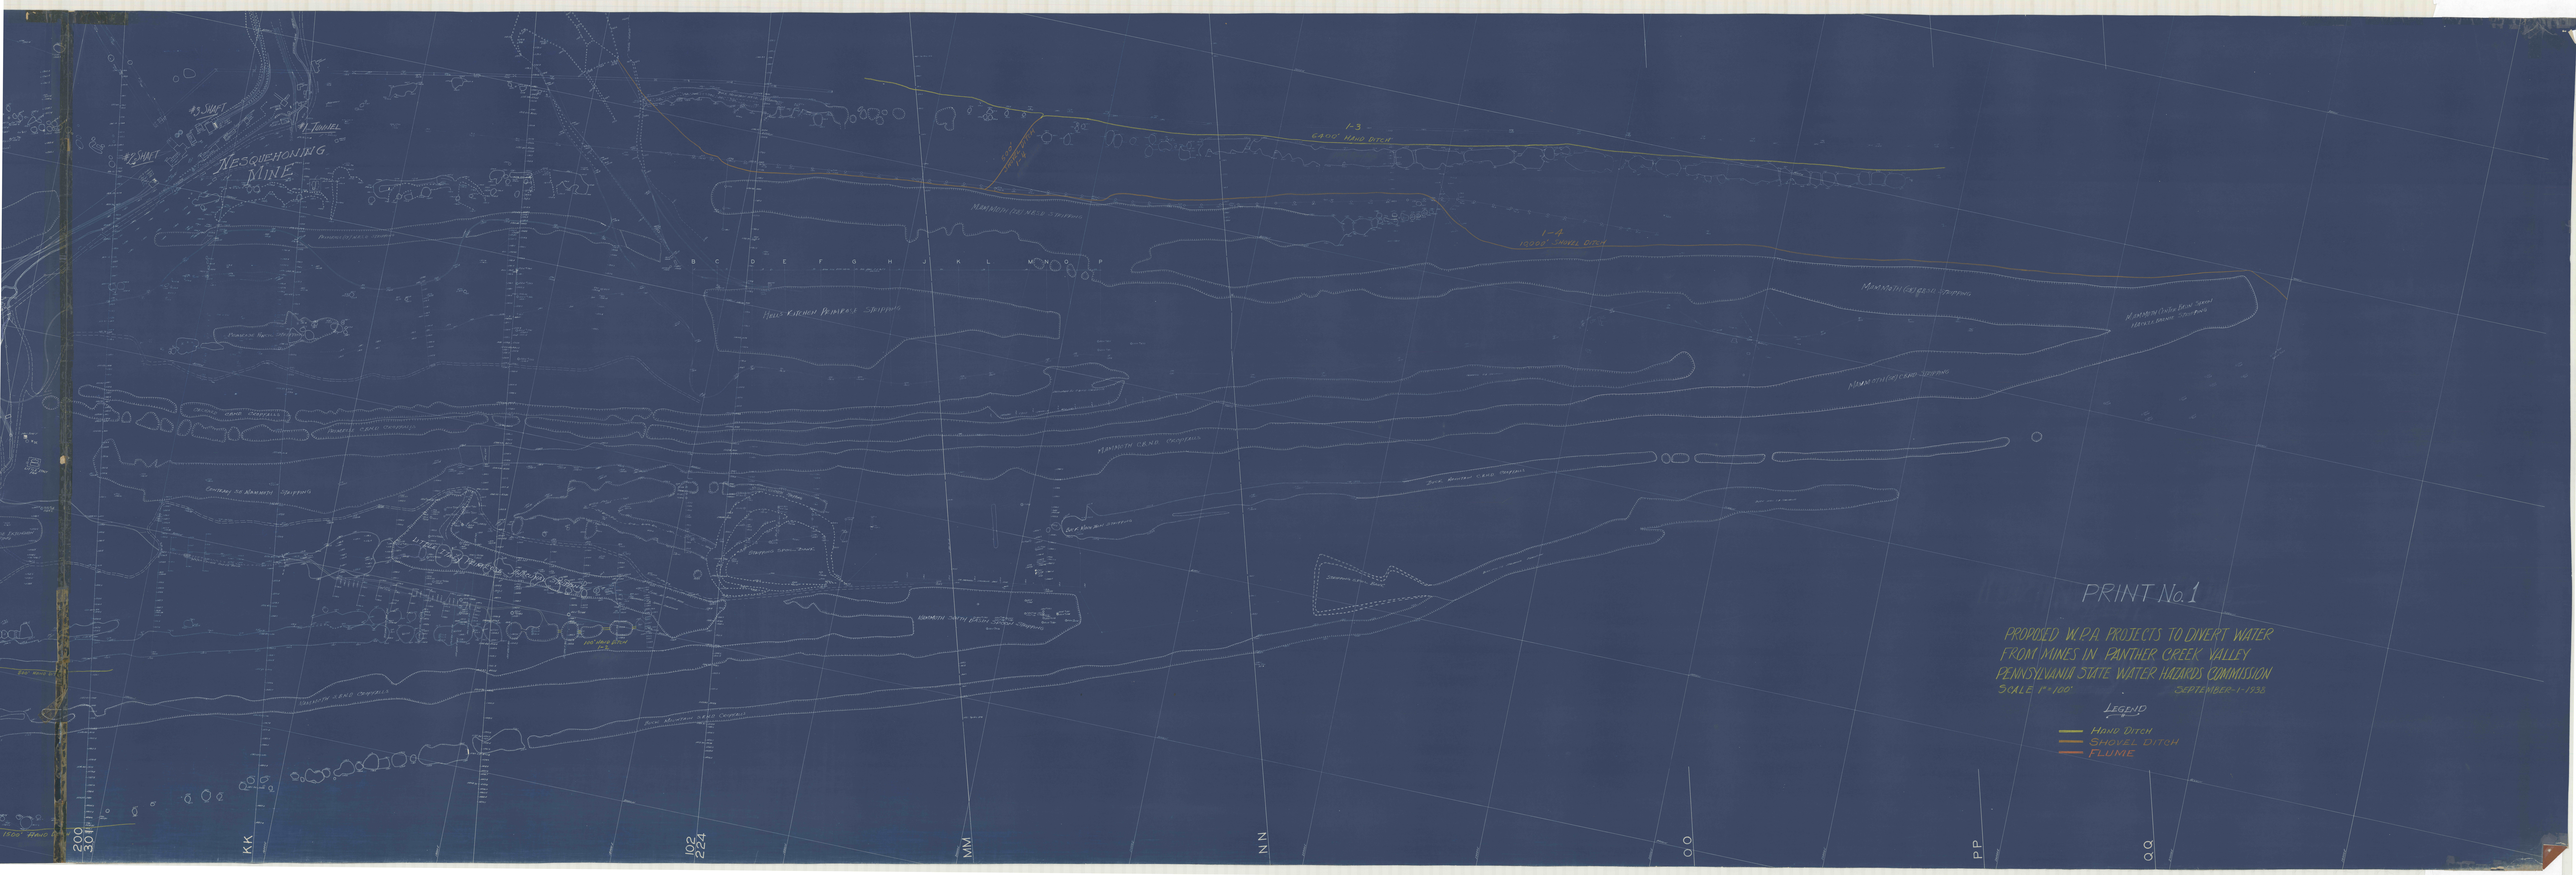

#3 SHAFT
#2 SHAFT
#1 TUNNEL
NESQUEHONING MINE
1-3
6400' HAND DITCH
1-4
10500' SHOVEL DITCH
MAMMOTH COAL CO. PROPERTY
HELLS KITCHEN PERIMETER STRIPPING
MAMMOTH COAL CO. STRIPPINGS
MAMMOTH COAL CO. STRIPPINGS
MAMMOTH COAL CO. STRIPPINGS