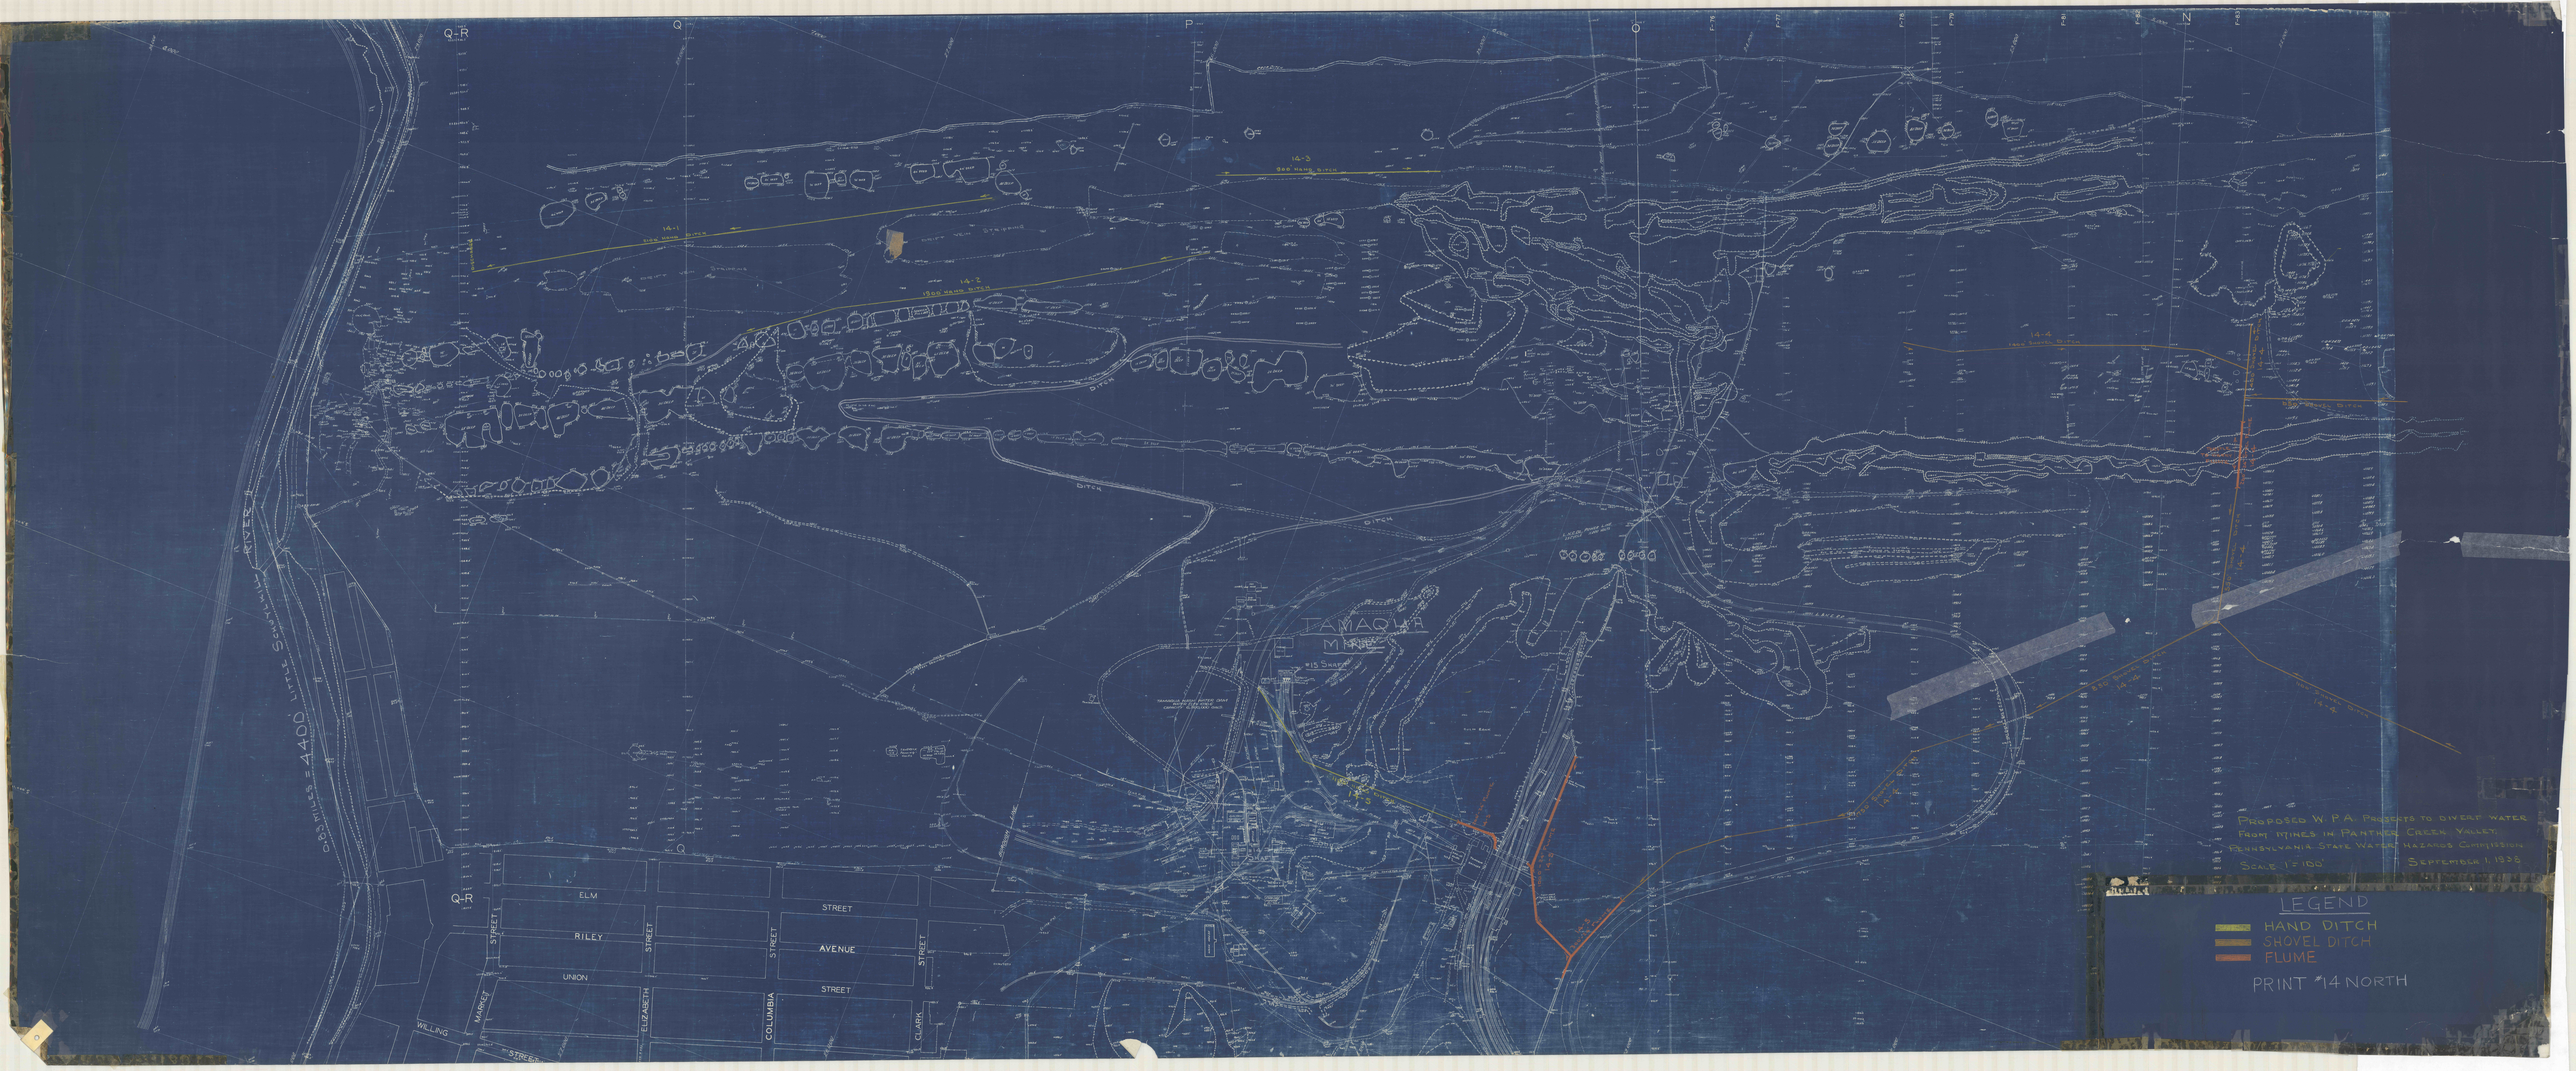
Q-R
Q
P
O
N
14-1
14-2
