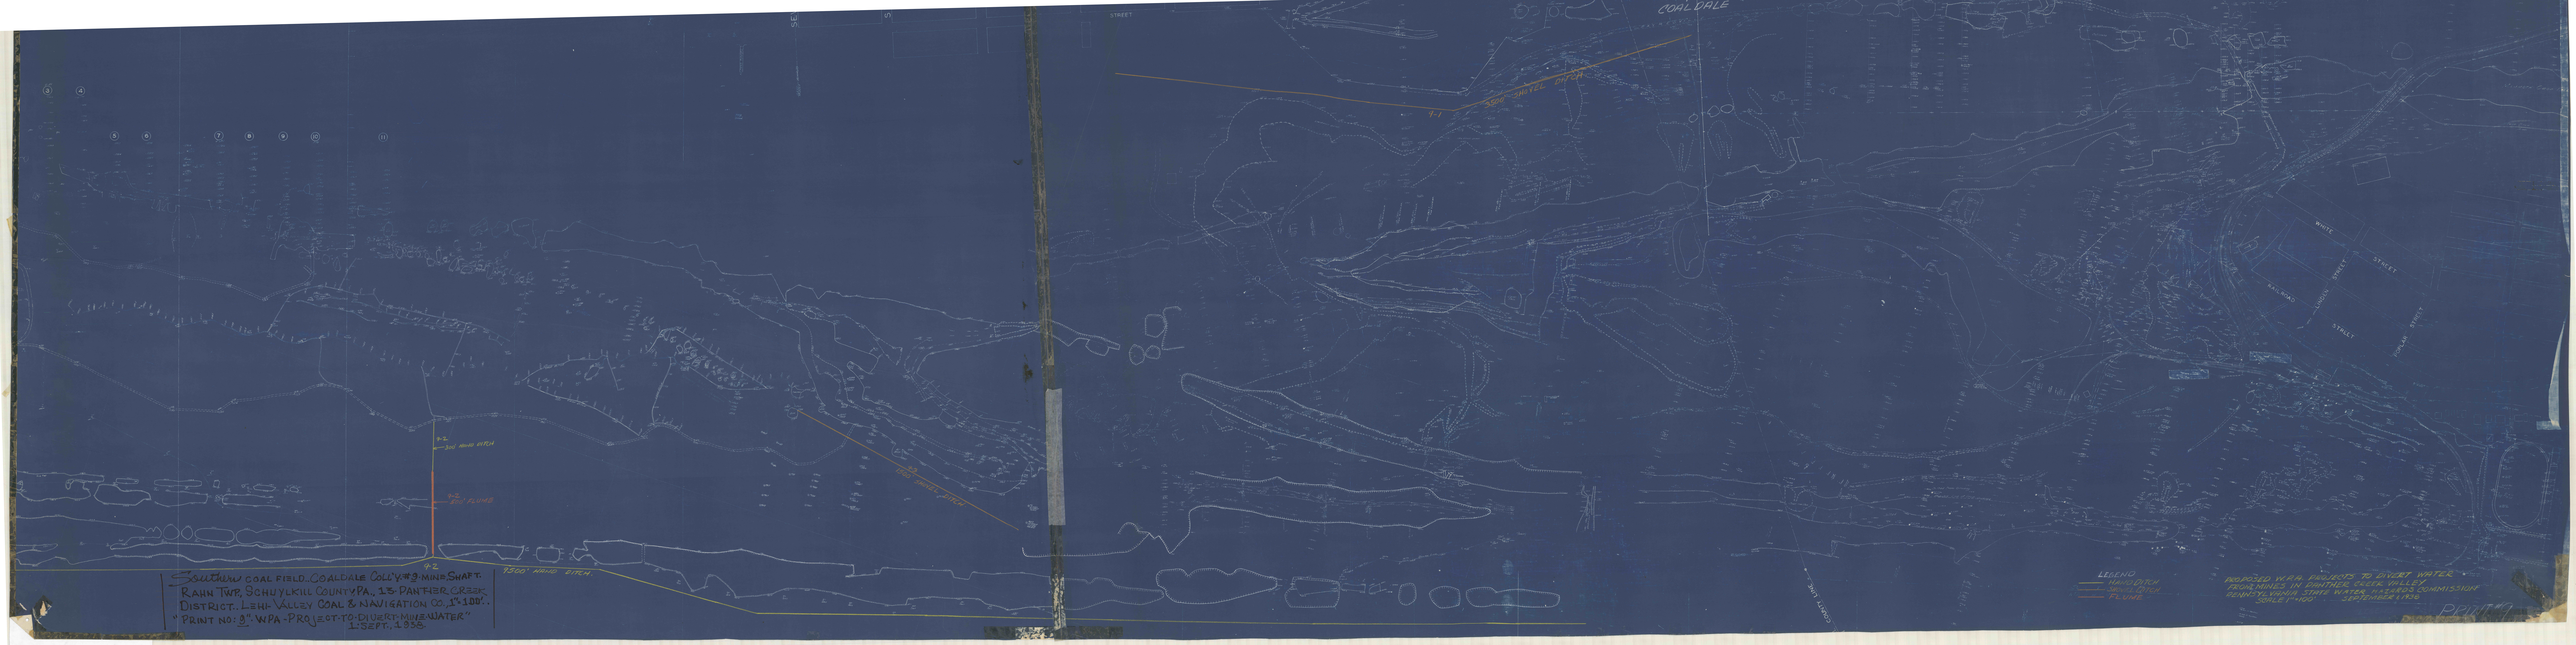


Southern COAL FIELD. COALDALE COLL'Y #3 MINE SHAFT.
RAHN TWP, SCHUYLKILL COUNTY PA., 13 PANTHER CREEK
DISTRICT. LEHI VALLEY COAL & NAVIGATION CO. 1"=100'.
"PRINT NO: 3" WPA-PROJECT-TO-DIVERT-MINEWATER"
1 SEPT. 1936.