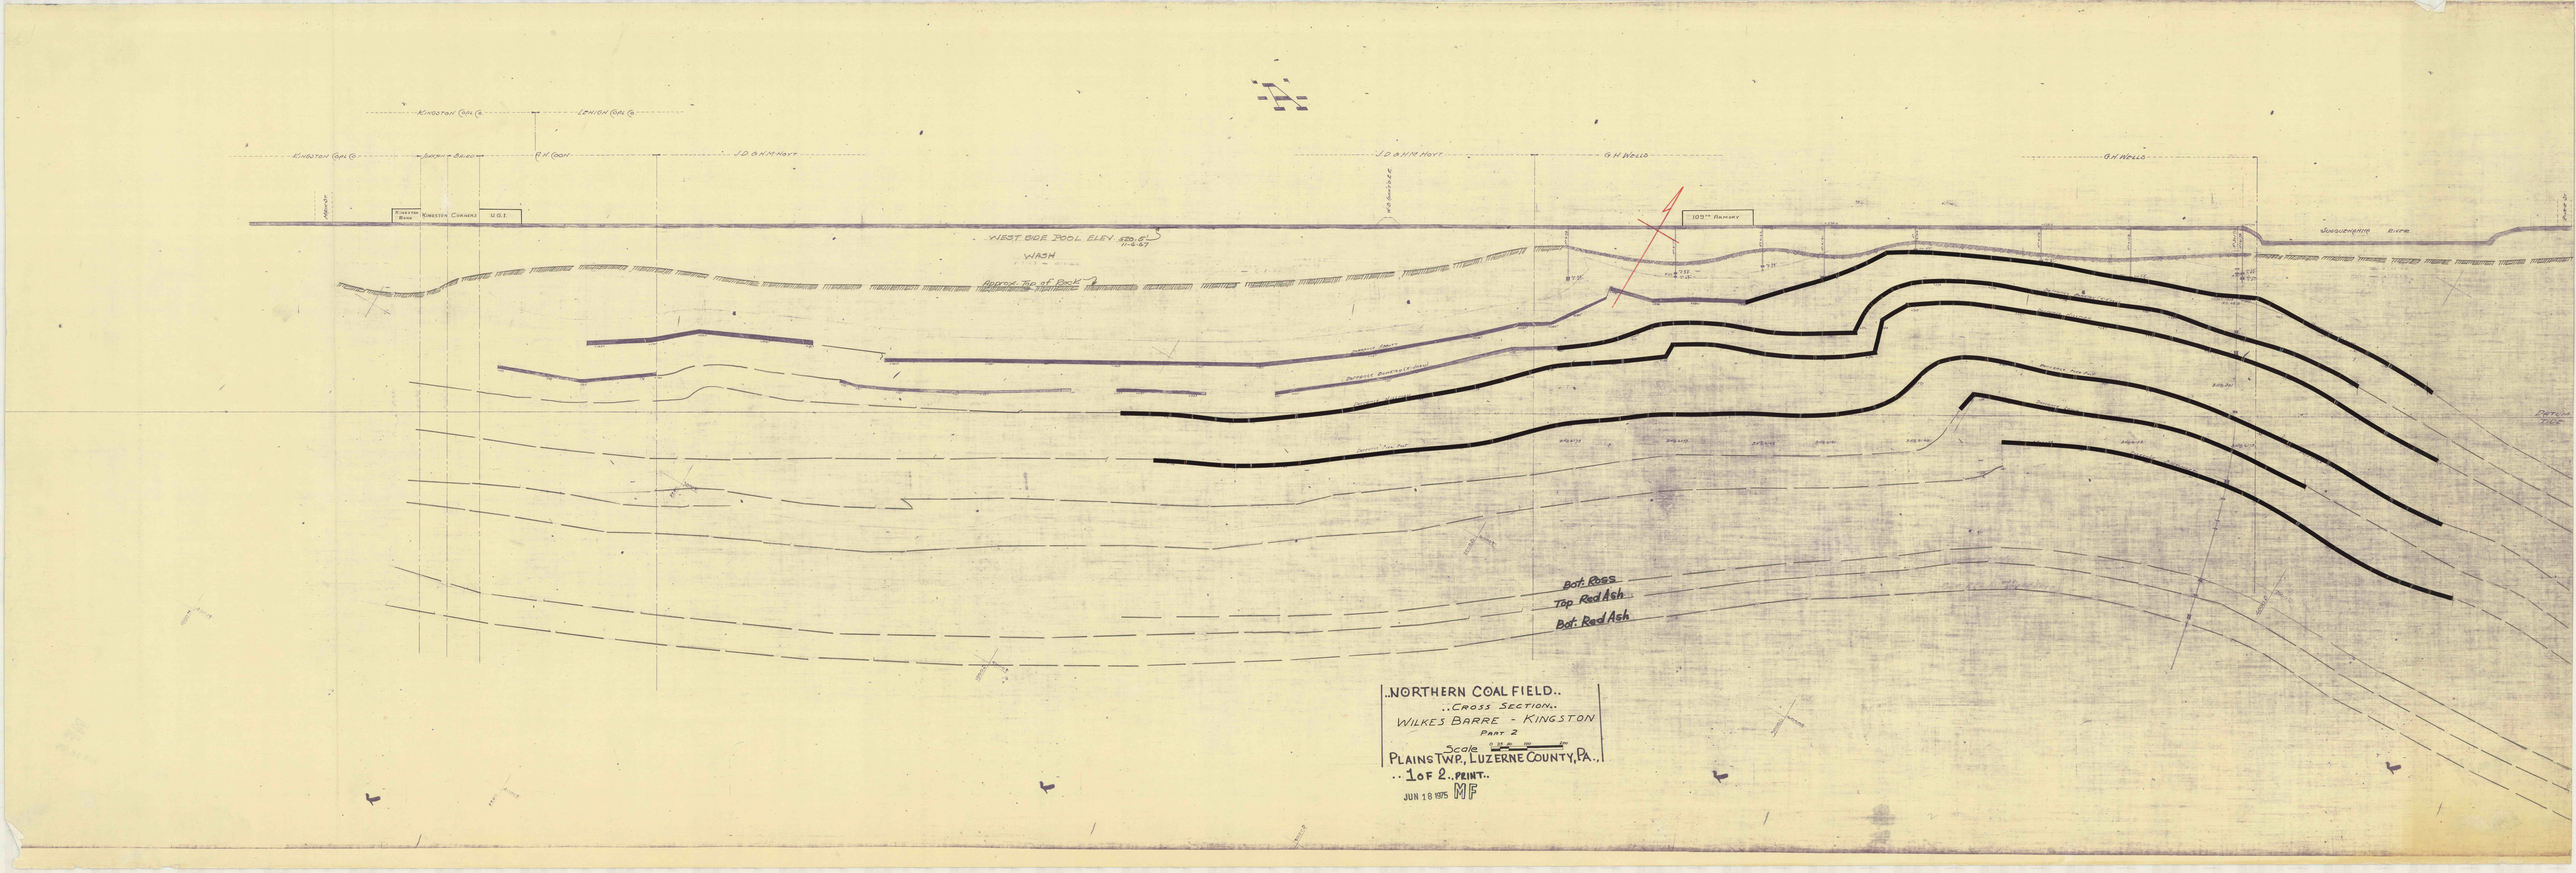

..NORTHERN COAL FIELD..
..CROSS SECTION..
WILKES BARRE - KINGSTON
PART 2
Scale
PLAINS TWP., LUZERNE COUNTY, PA..
..1 OF 2..PRINT..
JUN 18 1975 MF