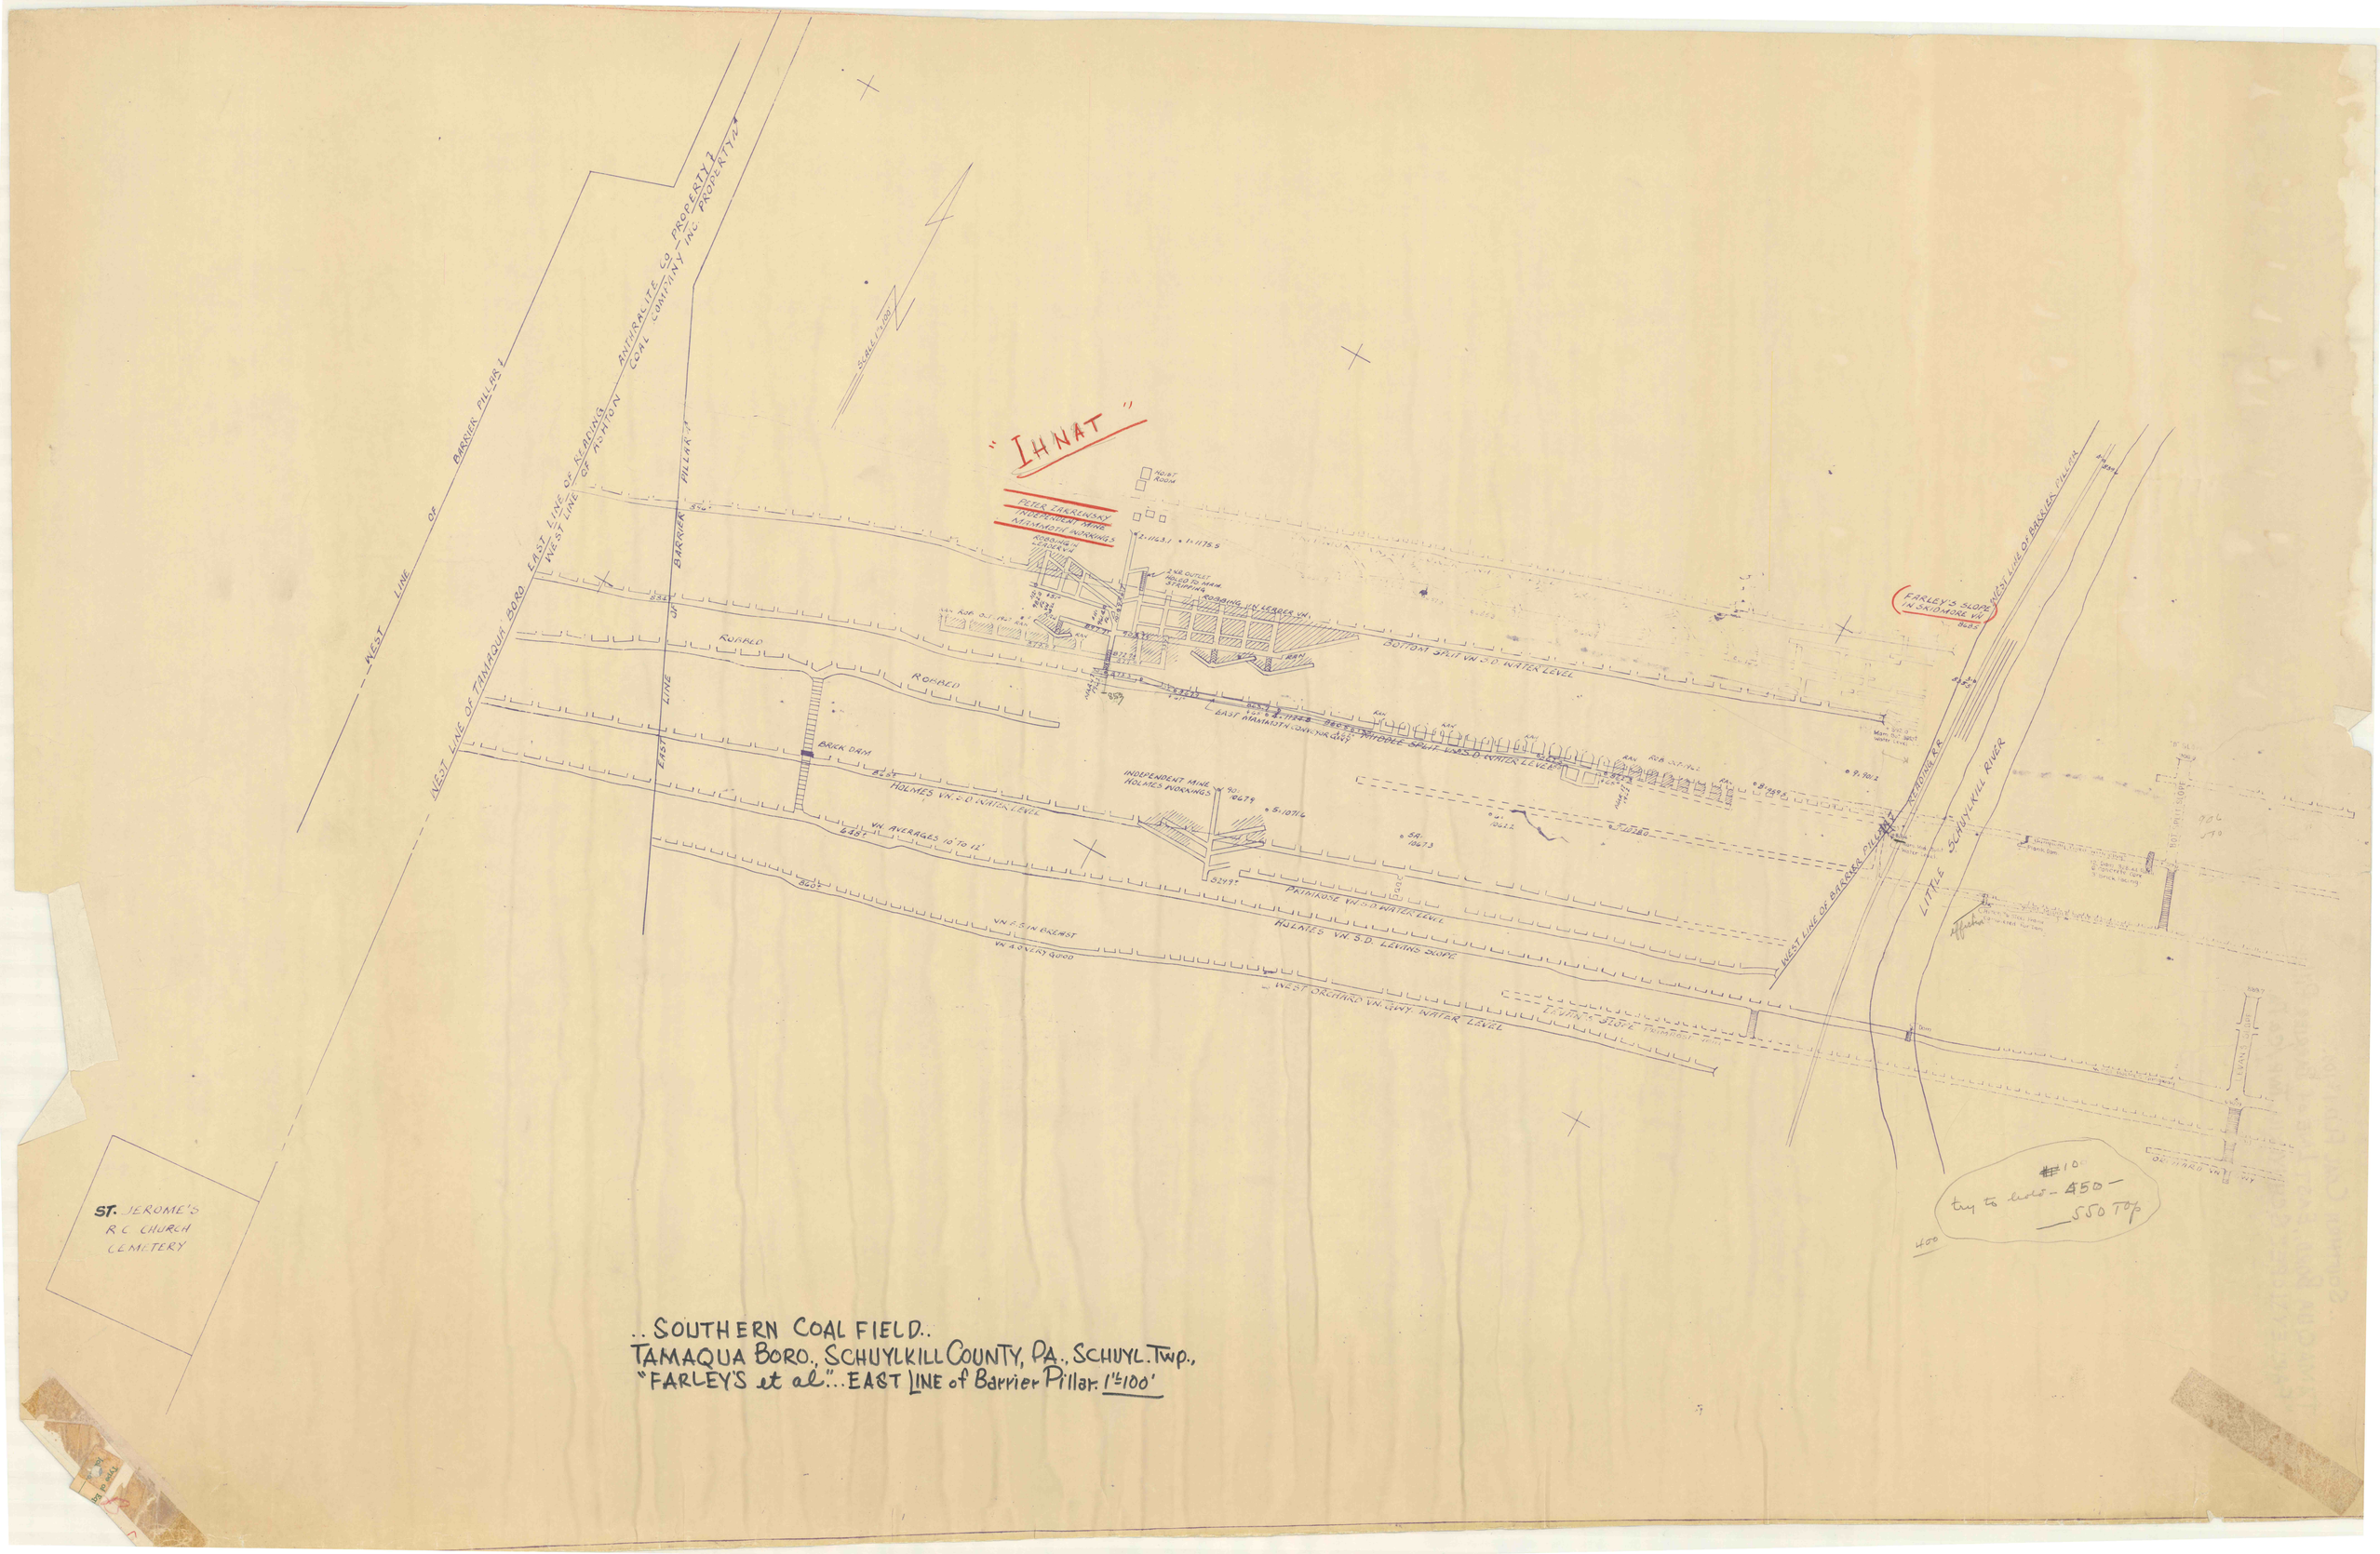

.. SOUTHERN COAL FIELD..
TAMAQUA BORO., SCHUYLKILL COUNTY, PA., SCHUYL. Twp.,
"FARLEY'S et al"..EAST LINE of Barrier Pillar. 1"=100'