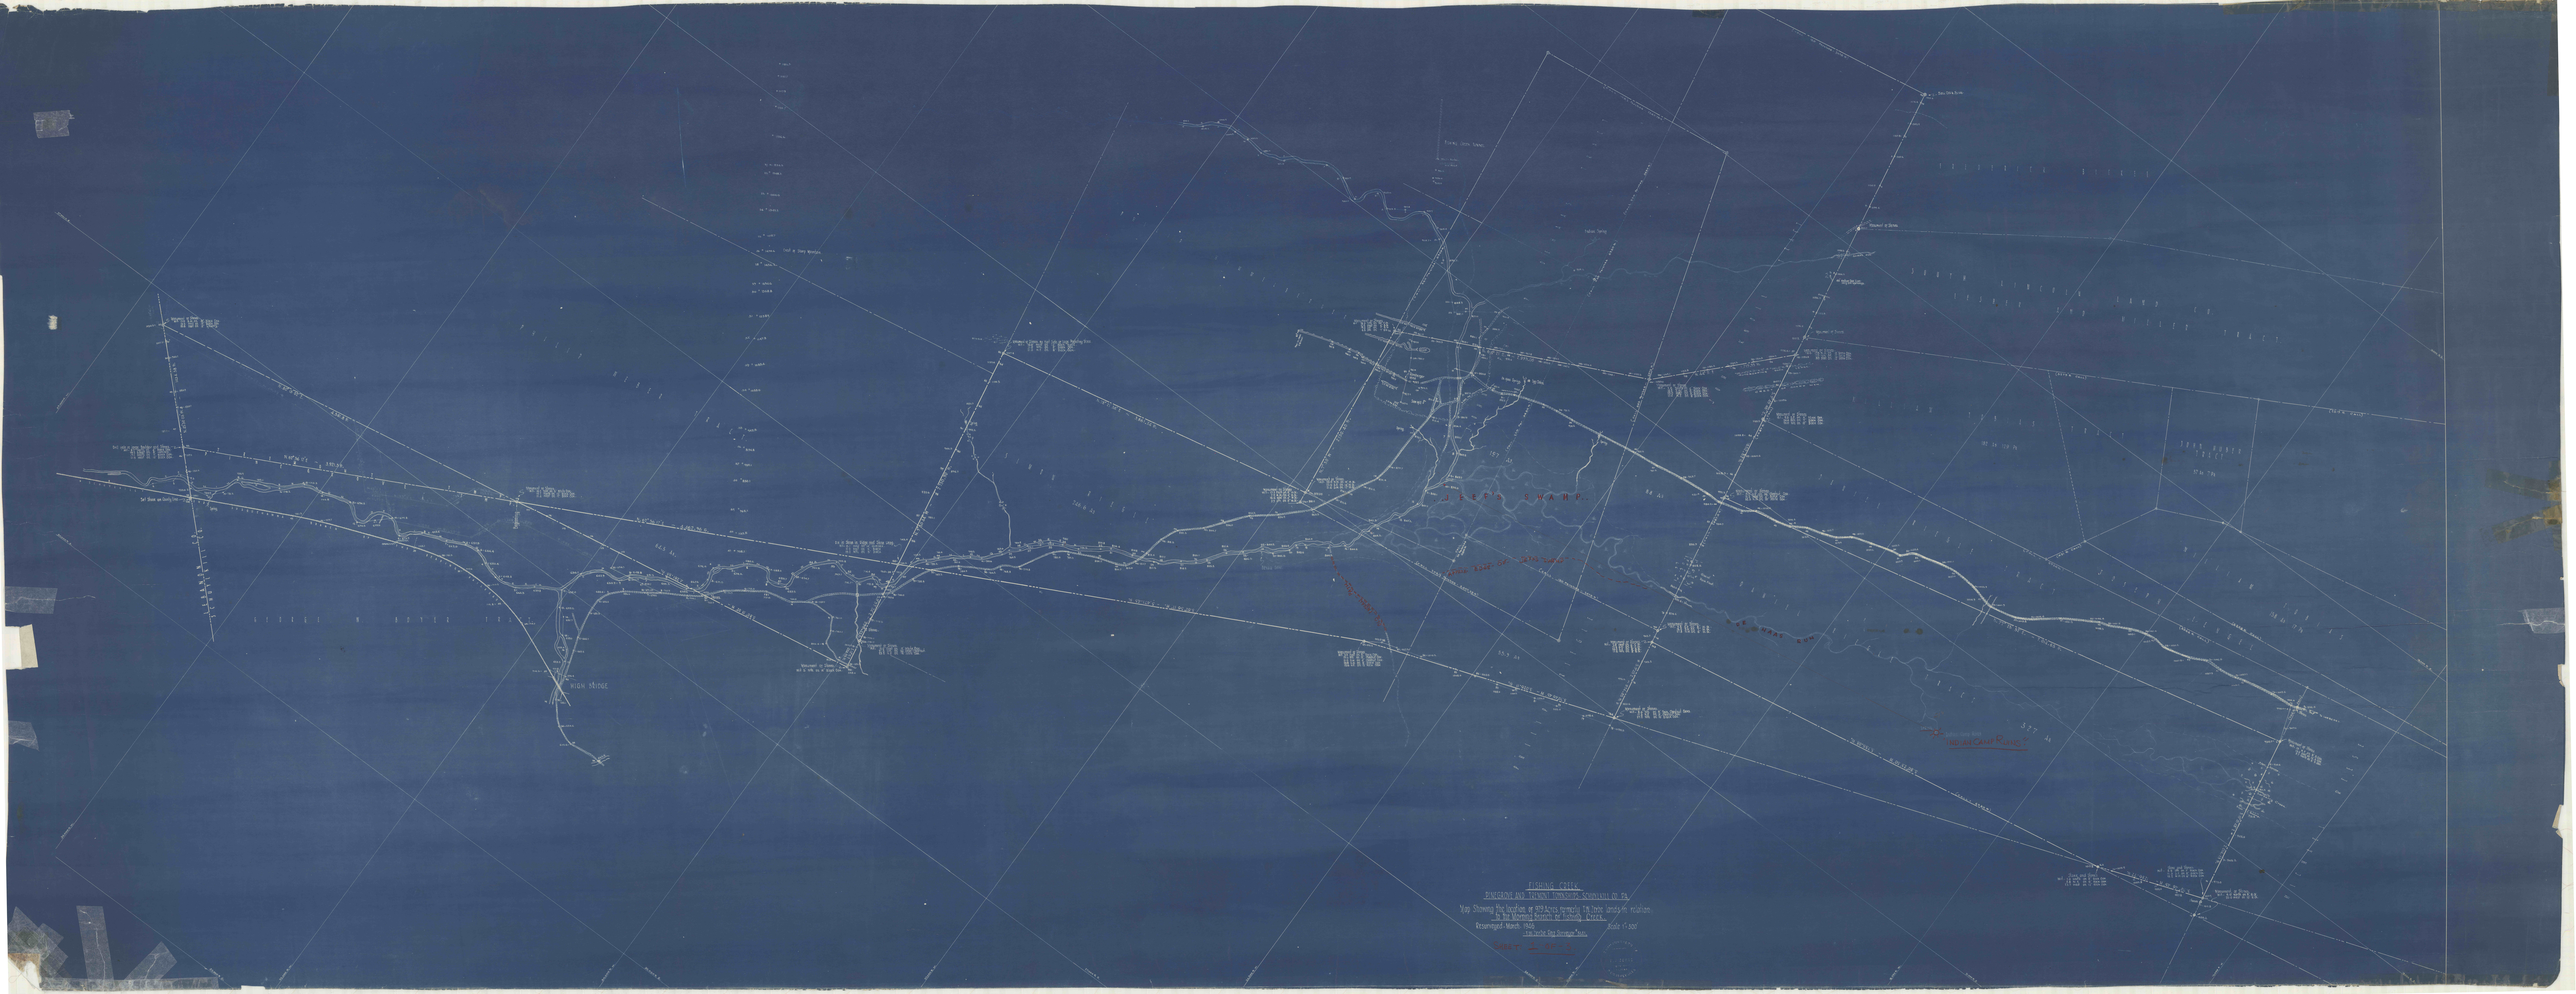
FISHING CREEK
to the Morning Branch of Fishing Creek
Prepared - March 1945
Scale 1" 200'
SHEET 1 OF 1 SHS
JEEP'S SWAMP
BRIDGE
INDIAN CANAL ROUTE