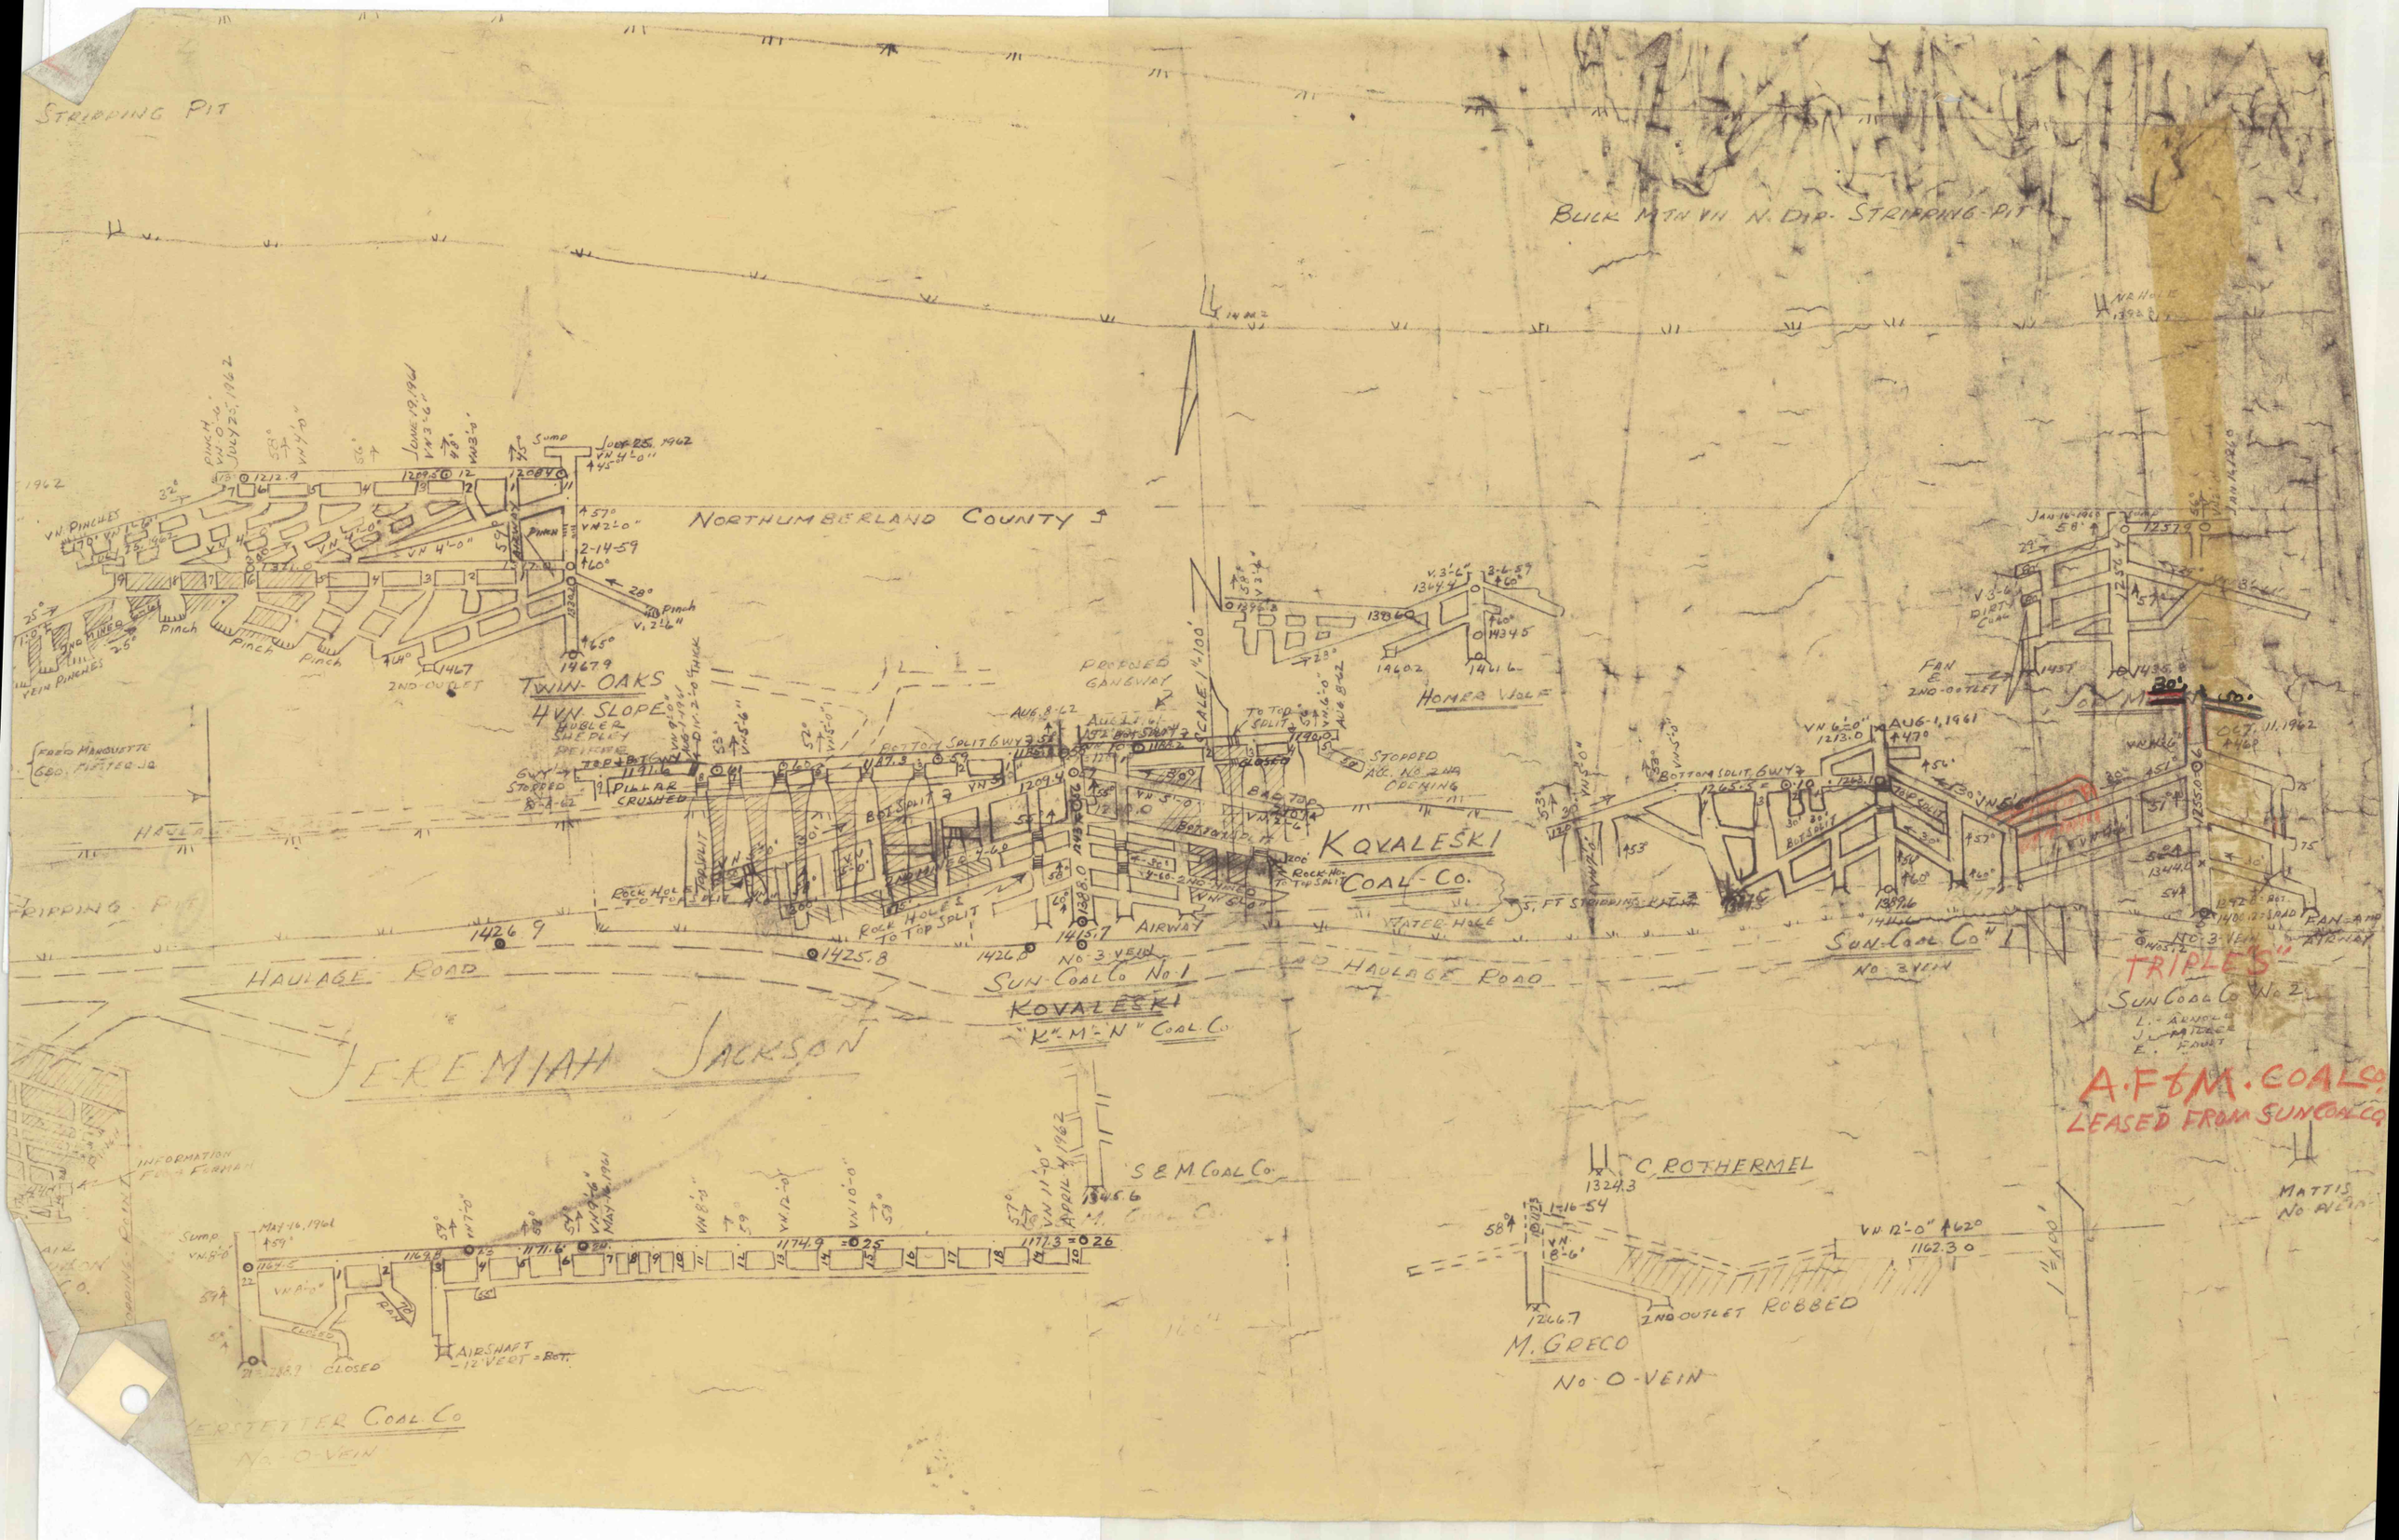
STRIPPING PIT
BUCK MTN VII N. DIP. STRIPPING PIT
NORTHUMBERLAND COUNTY
TWIN-OAKS
4 VN. SLOPE
HUBLER
SHEPLEY
PROPOSED GANGWAY
HOMER VOLE
KOVALESKI
COAL-CO.
SUN-COAL CO No 1
KOVALESKI
"K"M-N" COAL CO.
HAULAGE ROAD
JEREMIAH JACKSON
AIRWAY
STATEE HOLE
SUN-COAL CO No 1
No 3 VEIN
FAN
2ND OUTLET
TRIPLES
SUN COAL CO No 2
A.F&M. COAL CO.
LEASED FROM SUN COAL CO
S & M COAL CO
C. ROTHERMEL
M. GRECO
No O VEIN
2ND OUTLET ROBBED
AIRSHAFT
12 VERT = BOT.
CLOSED
VERSTETTER COAL CO
No O VEIN
MATTIS
No 4 VEIN