


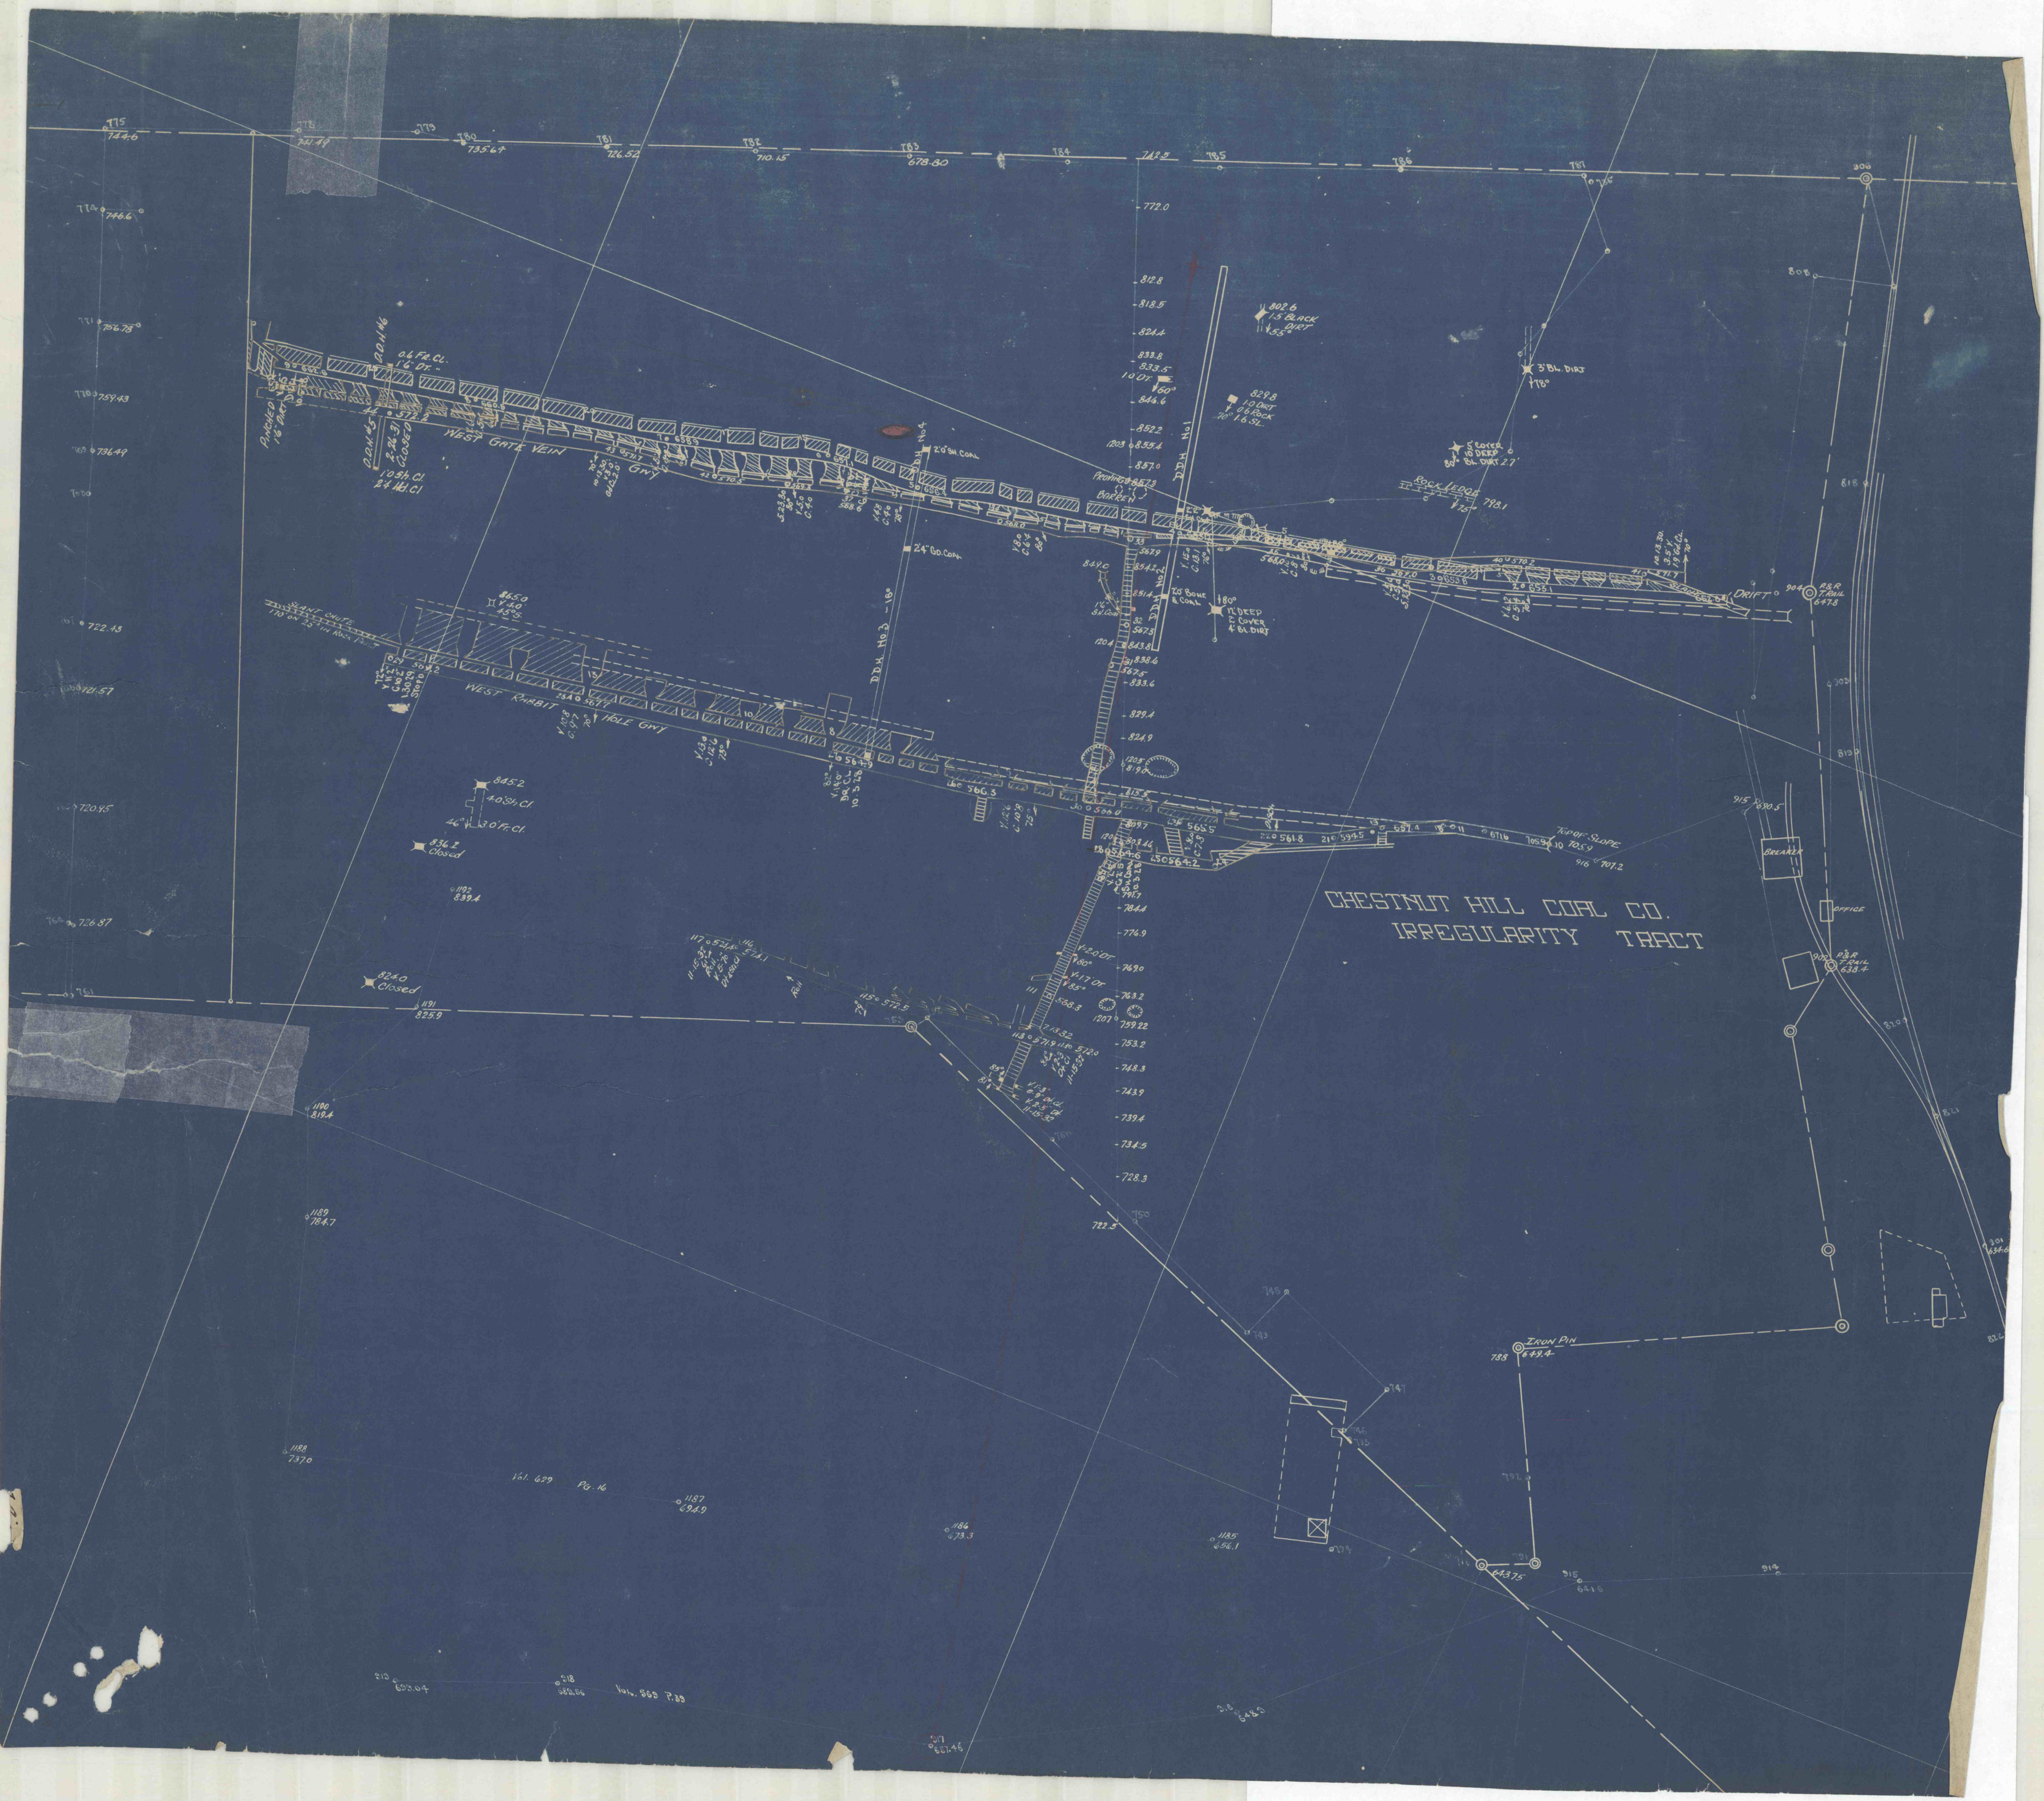

CHESTNUT HILL COAL CO.
IRREGULARITY TRACT