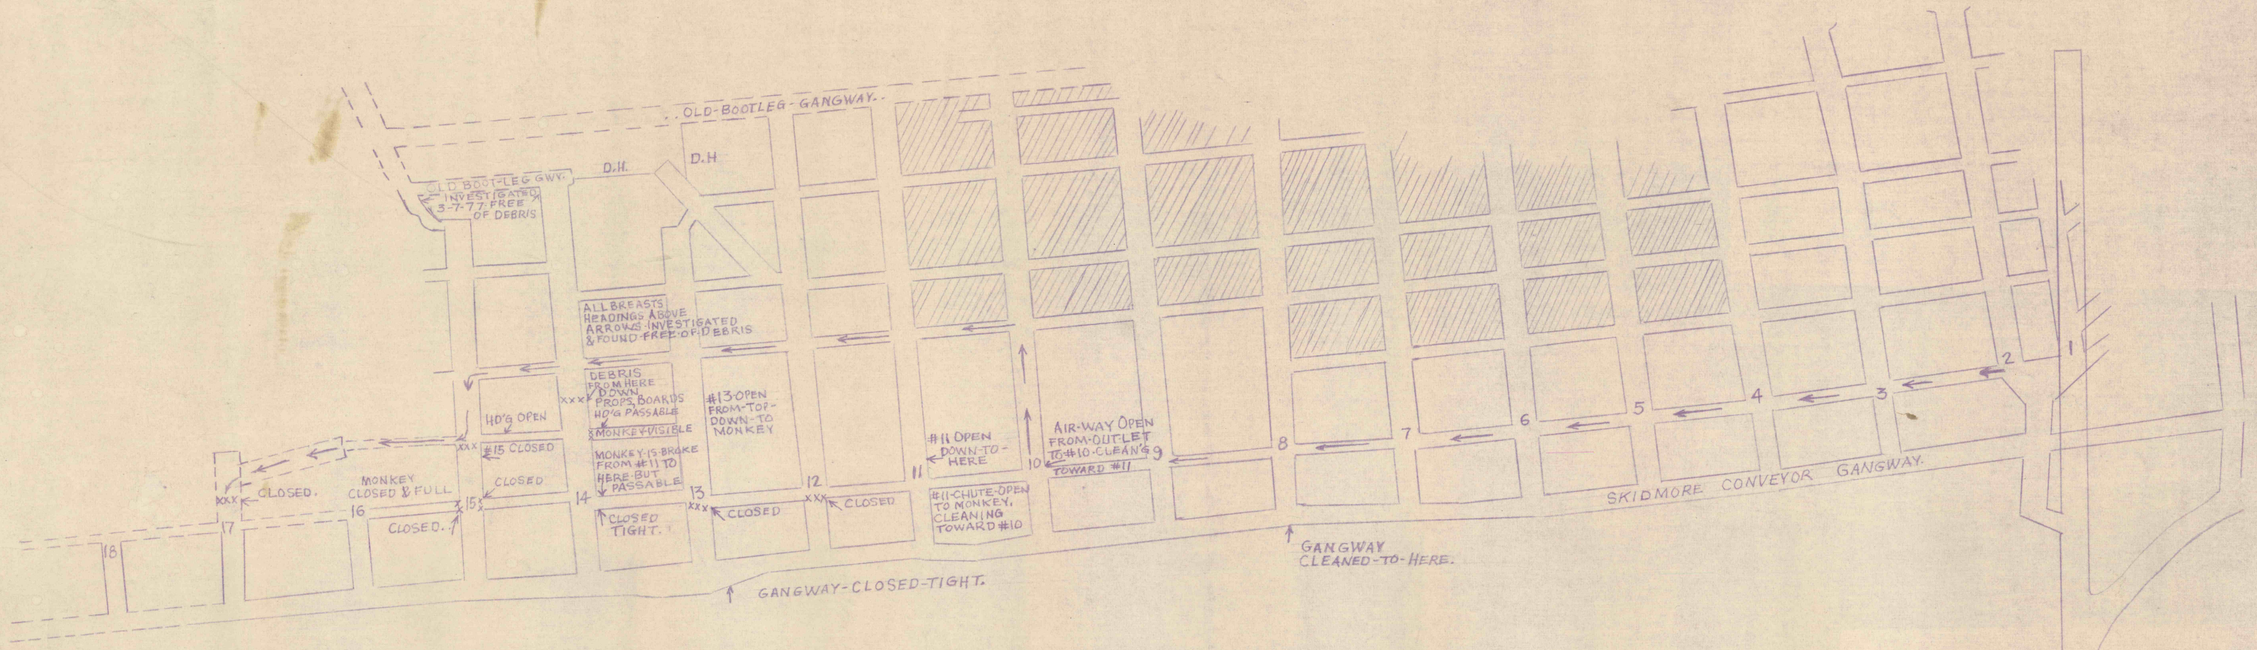

INVESTIGATION...MARCH 7, 1977
BY LEON RICHTER
PALMER MERVINE
WALTER VINCENELLY.

10 MARCH 1977,
ALEX. DROZDA
DEEP MINE SAFETY.