

Estate of Job Rich

IE

IT

IS

IE






















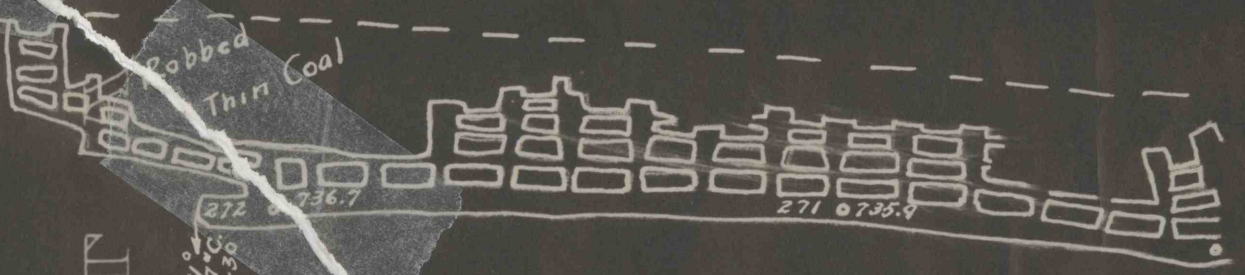

1 P P E D VEIN 12'-0" COAL 7'-0"

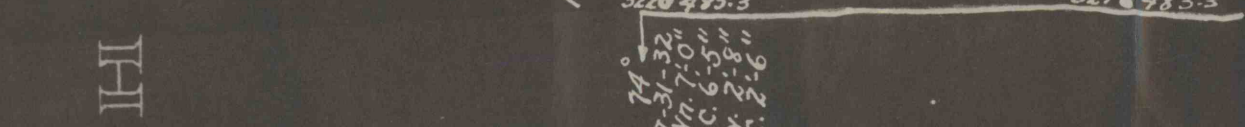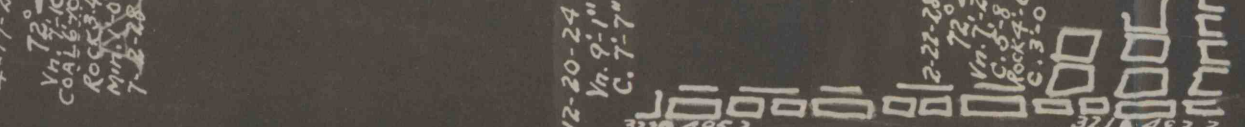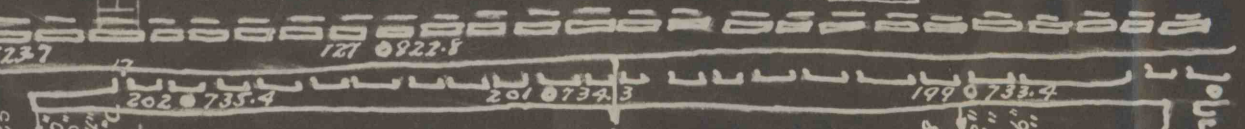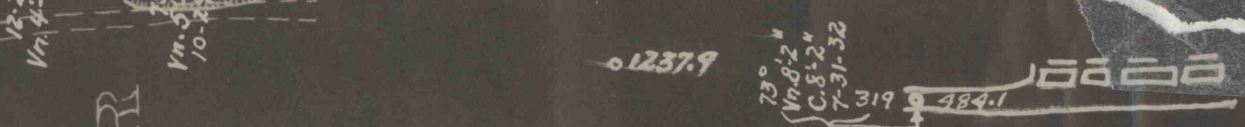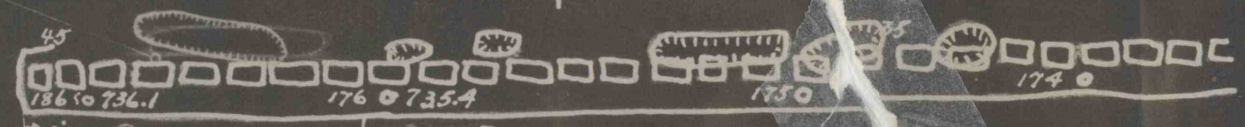

WORKINGS

ON

PART OF YORK FARM PROP.

SURVEYS BY COCHRAN

LEHIGH VALLEY COAL CO.

FEB. 1935

FROM SURVEYS BY LEHIGH VALLEY COAL CO.

ADJUSTMENTS IN SAME FROM INFORMATION BY R. PHILLIPS

CITY OF POTTSVILLE LINE

PHOTO 97 OF 100 SCALE MINE MAP - DEKORR CO INC.